Important Note: Contractor to provide earth berm on north, south, west sides only

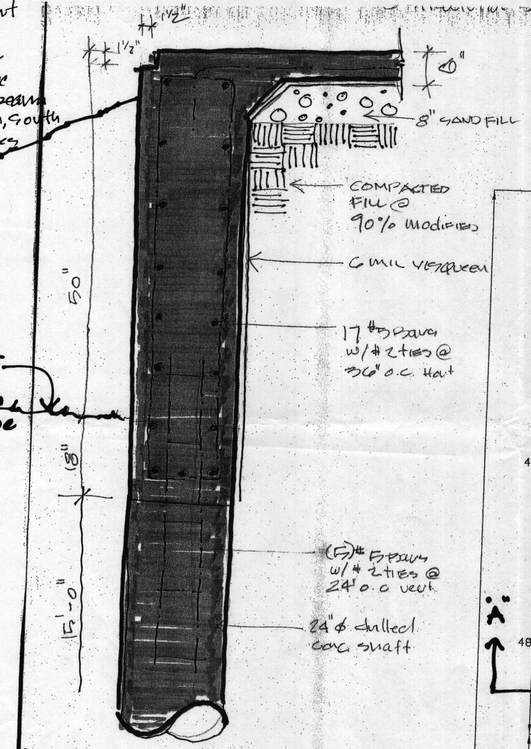

"A" Perimeter Grade Beam

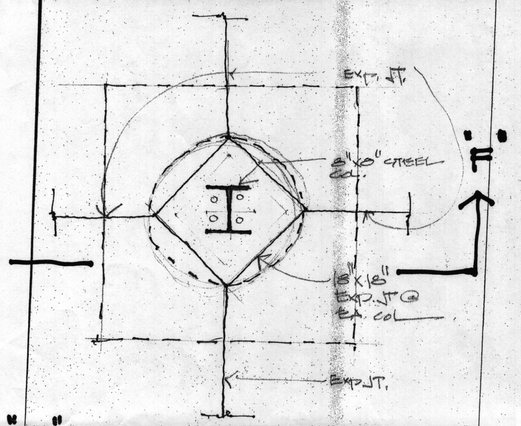

"B" Plan Detail of Col. Typ. @ all cols

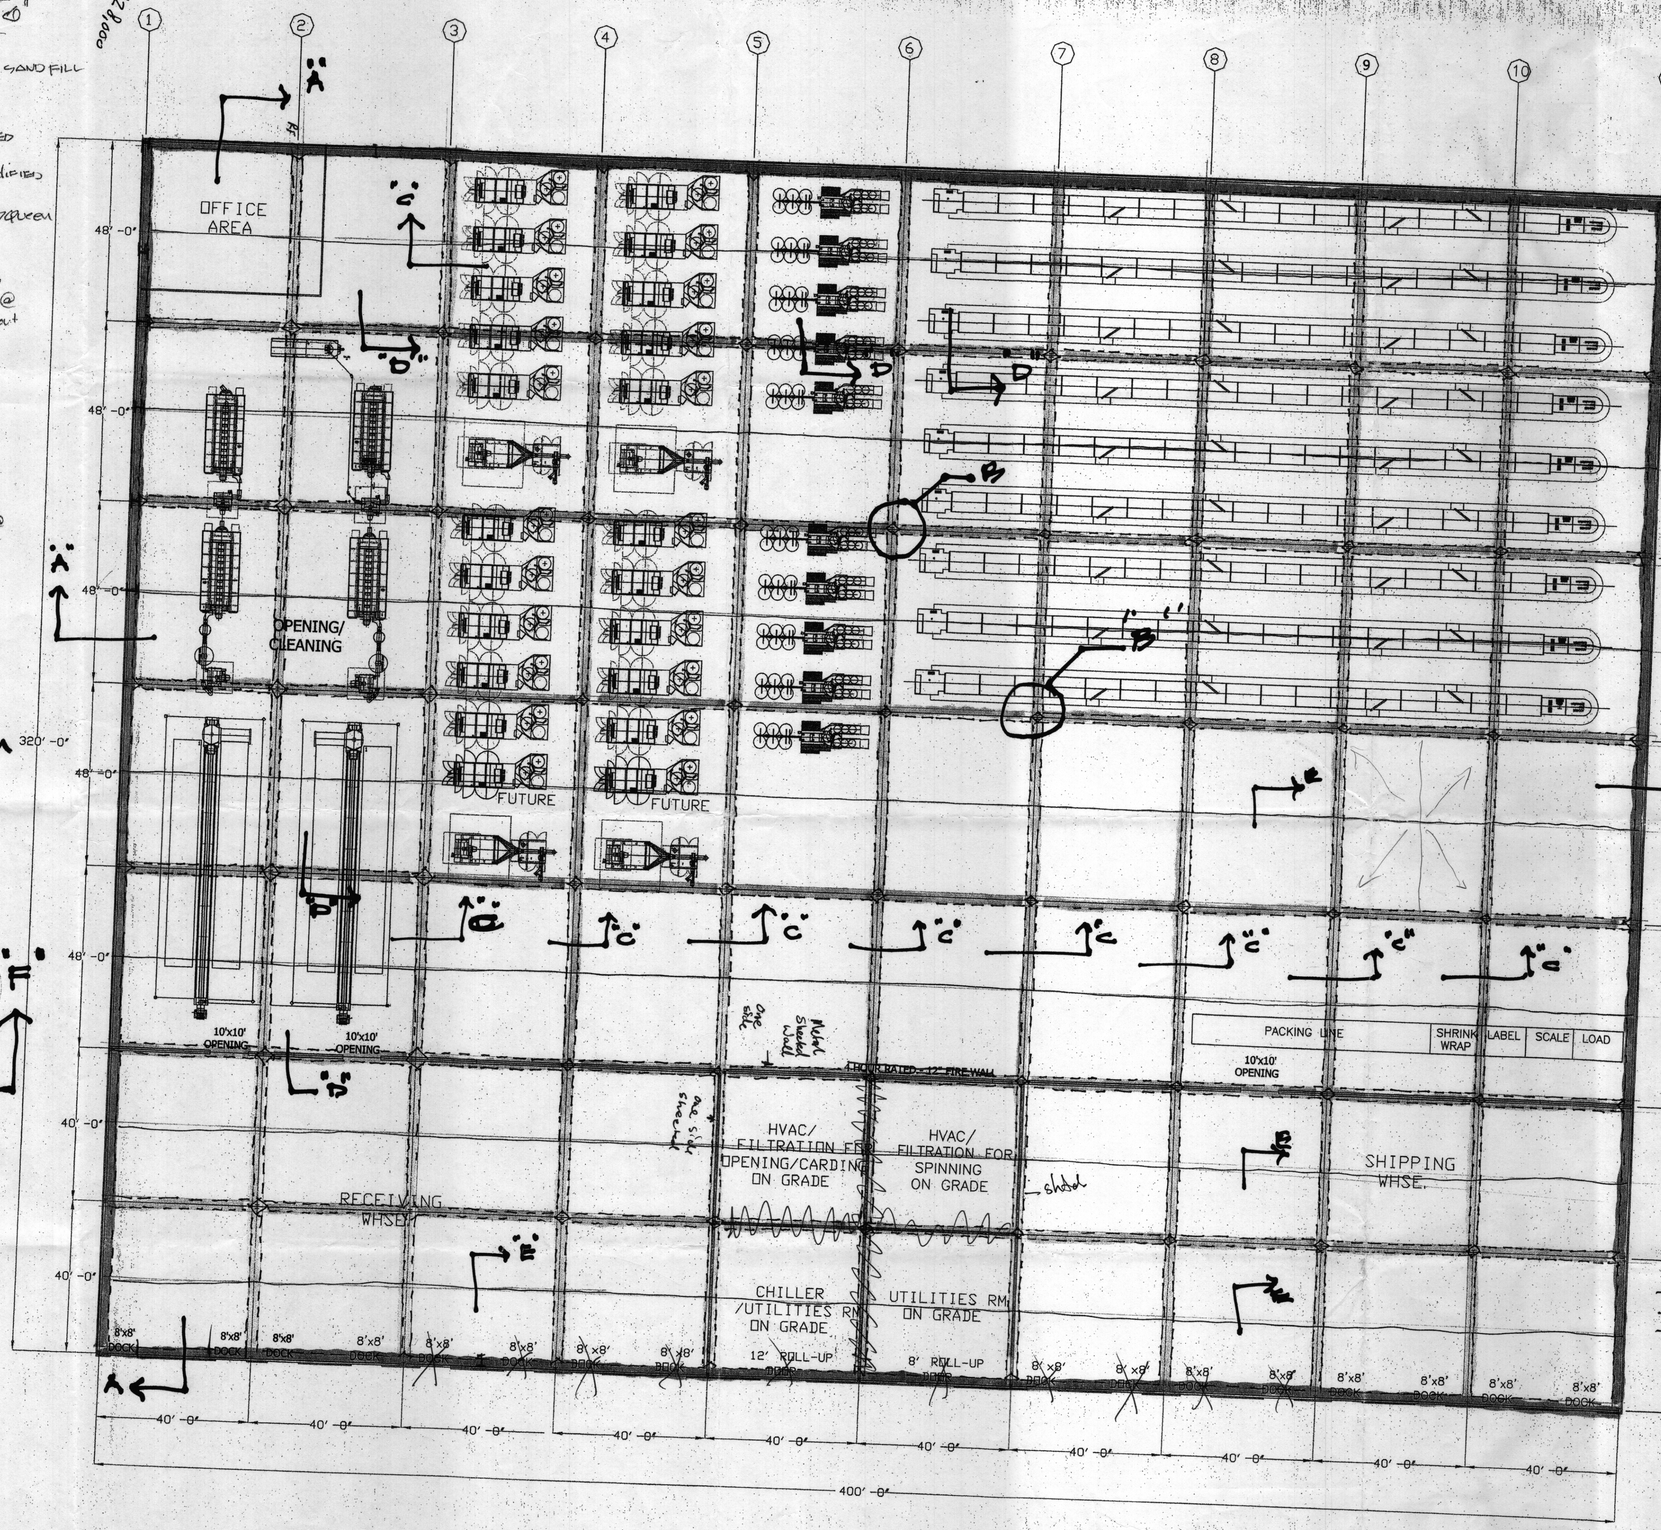

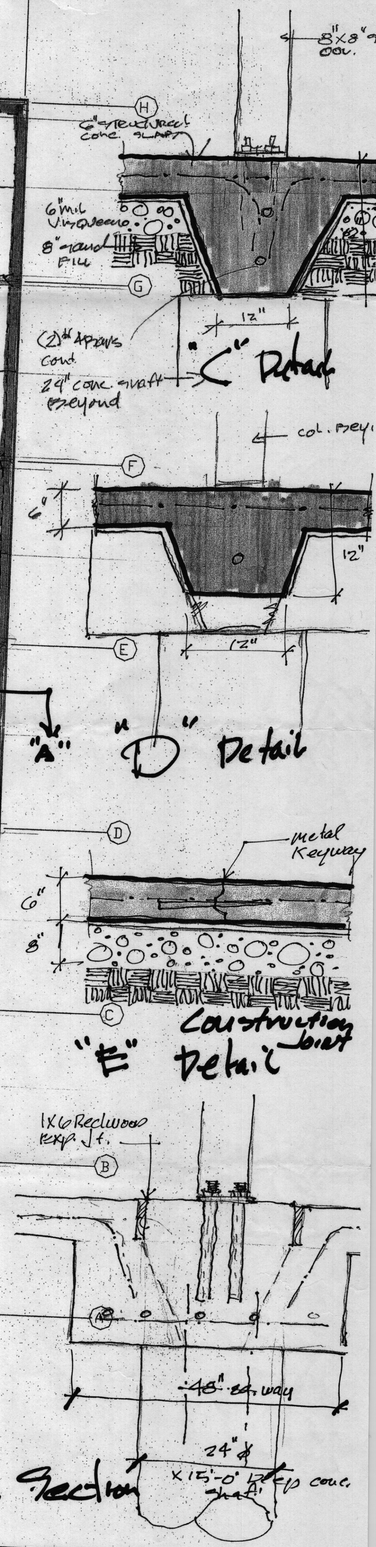

"C" Detail

"D" Detail

"E" Detail

"F" Detail Section