


NOT IN A FLOOD PRONE AREA.
 IS LOCATED IN FLOOD ZONE C

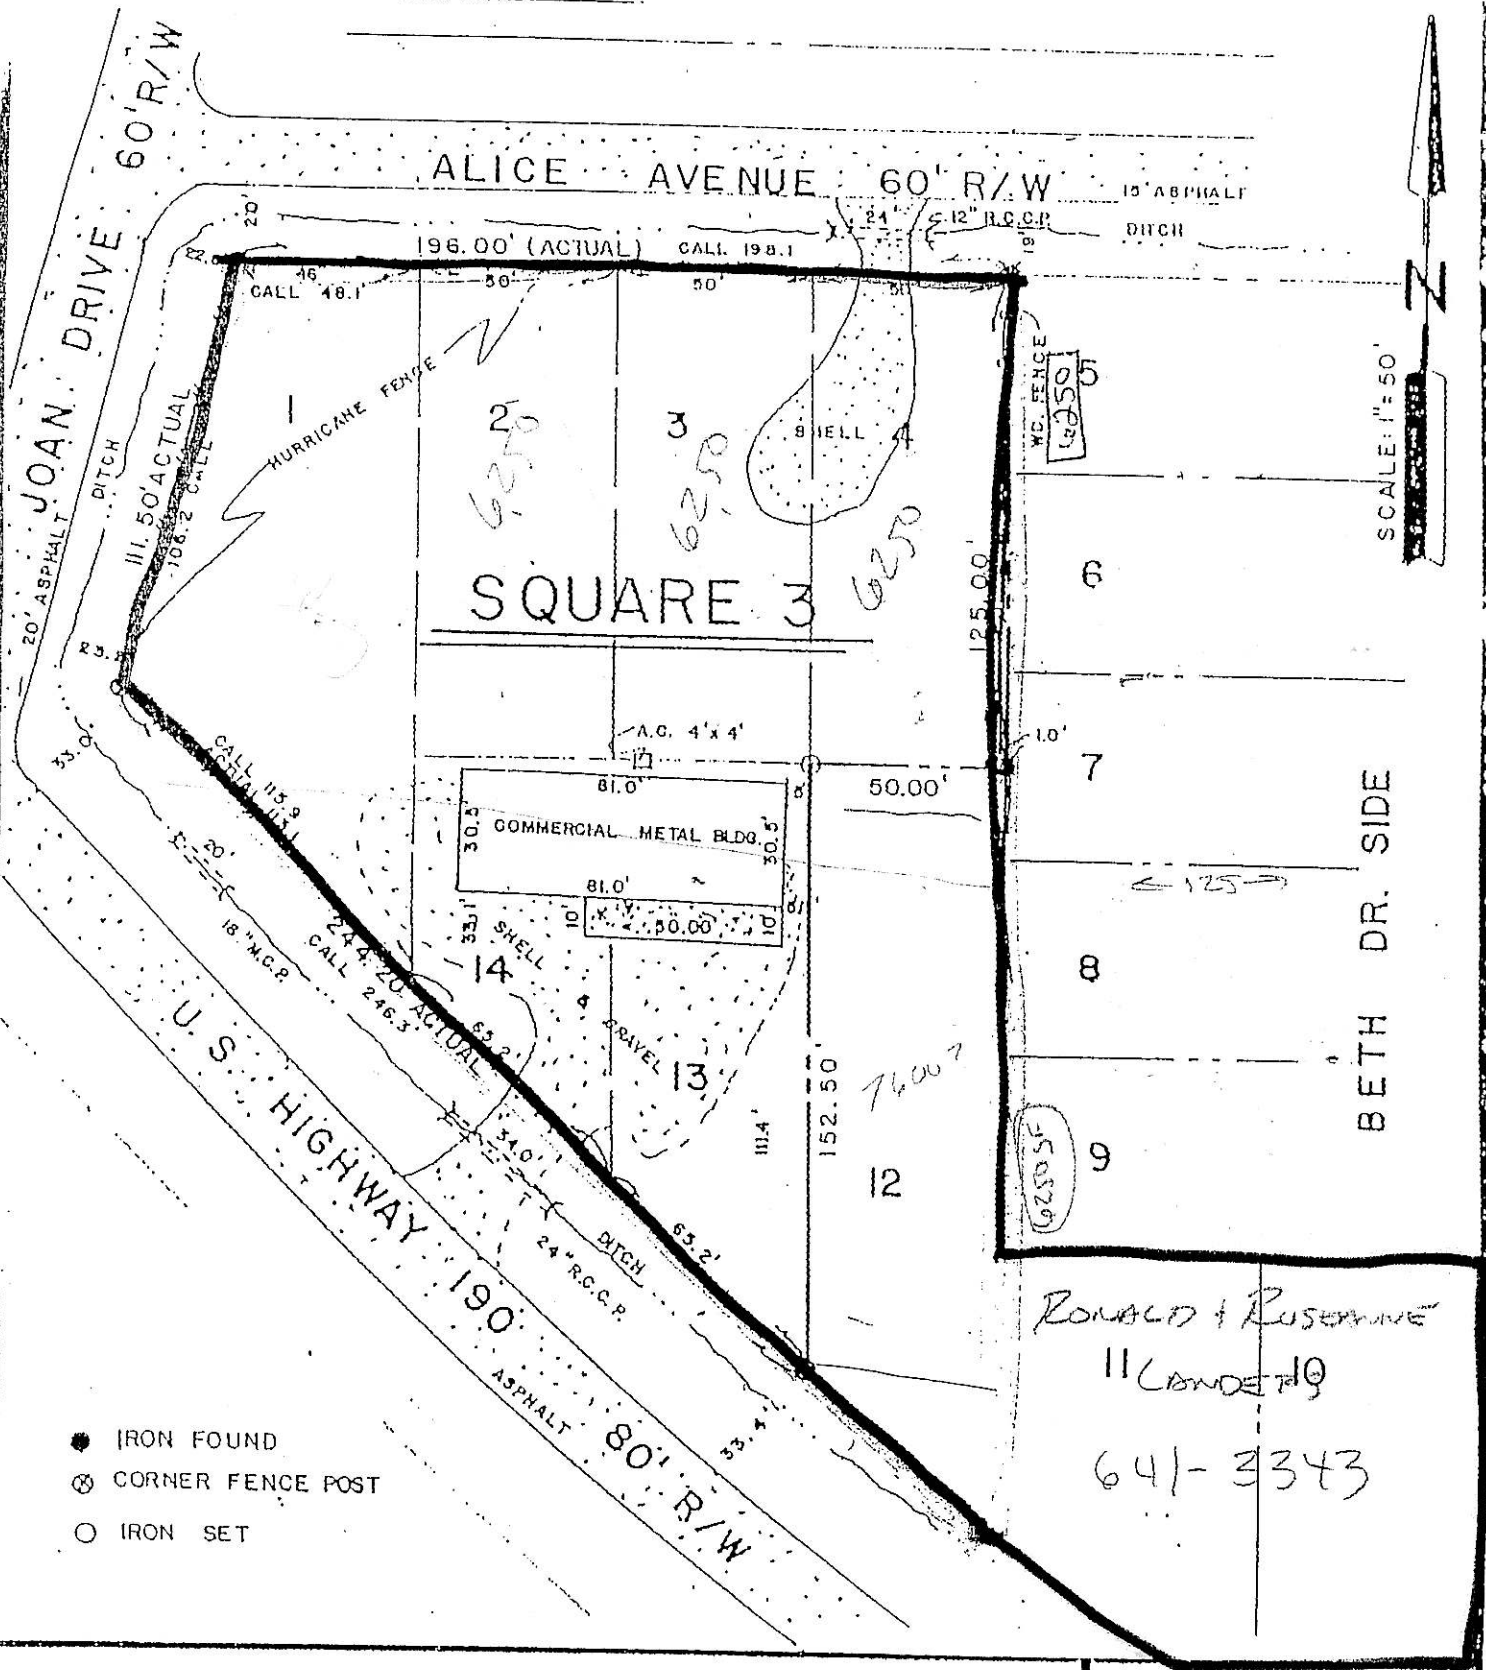

- IRON FOUND
- ⊗ CORNER FENCE POST
- IRON SET

SCALE: 1" = 50'

RONALD + ROSEMARIE
 11 LANDERS DR
 641-3343

MAP SHOWING SURVEY OF LOT NO. 1, 2, 3, 4, 13 & 14, SQ. 3
 SUBDIVISION PINE SHADOWS
 LOCATED IN SEC. II, T9S-R14E, G.L.D.
 NEAR SLIDELL, ST. TAMMANY PARISH

