
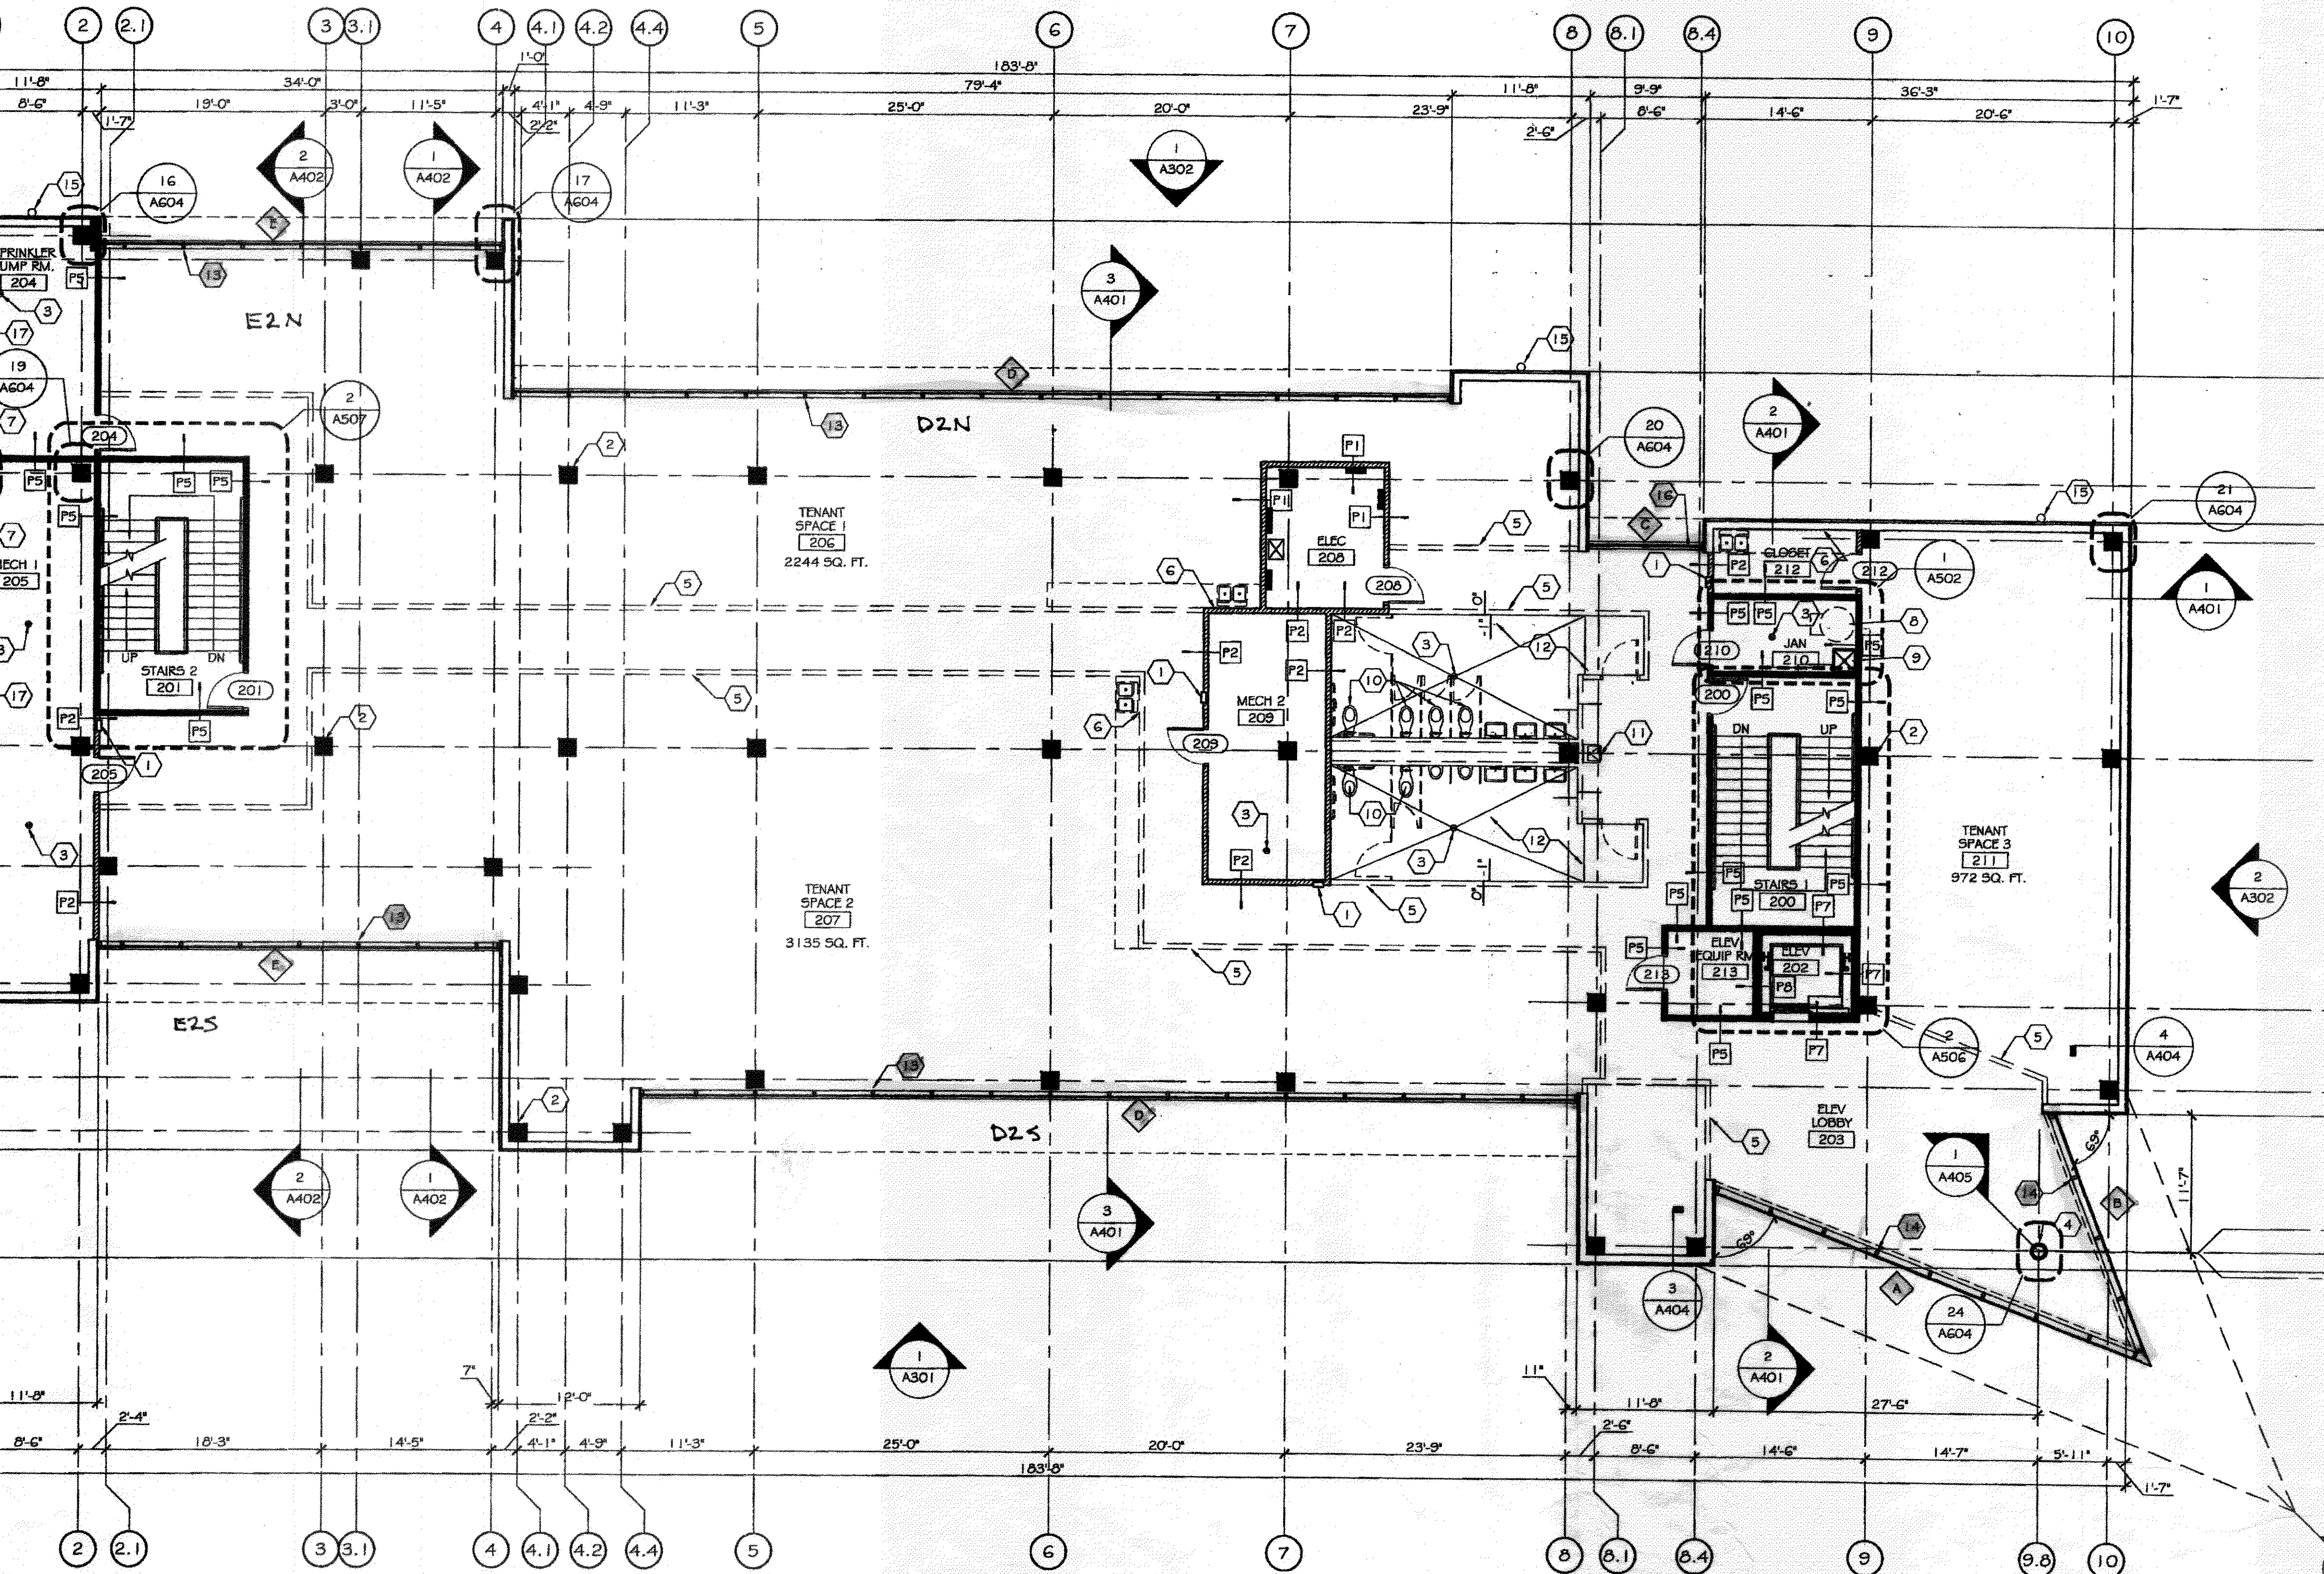


A707
 FINISH SCHEDULE SHEET A702
 AN 1/A205
 THEY MEET THE SLAB
 SHOWN AS CUT 3' ABOVE THE SLAB
 FULLY FINISHED GYPSUM BOARD AND PAINTED.
 R WALLS TO BE LEVEL 2 GYPSUM BOARD,
 H SCHEDULE SHEET A701.

SPECIFIC NOTES (THIS SHEET ONLY):

- 1 FIRE EXTINGUISHER & CABINET
- 2 CONCRETE COLUMN, TYPICAL (RE: STRUCTURAL DRAWINGS)
- 3 FLOOR DRAIN (RE: MECHANICAL DRAWINGS)
- 4 STRUCTURAL STEEL COLUMN (RE: STRUCTURAL DRAWINGS); ONE-HOUR FIRE-PROTECTED WITH INTUMESCENT PAINT; SHOWN AT SLAB LOCATION. PROVIDE 2 PIECE ALUMINUM (CLEAR ANODIZED) COLUMN COVER FROM FLOOR TO CEILING.
- 5 FUTURE WALLS, TO BE DETERMINED DURING FUTURE TENANT BUILDOUTS, NIC
- 6 FUTURE PLUMBING WALLS FOR FUTURE BREAKROOMS (RE: PLUMBING DRAWINGS); TO BE DETERMINED DURING FUTURE TENANT BUILDOUTS, NIC
- 7 FIRE-RATED PARTITION FOR SEPARATION OF FIRE-RATED SPRINKLER PUMP ROOM; CONTRACTOR TO BUILD 1-HR RATED PARTITION AT INTERIOR OF LOUVER AS SHOWN TO MAKE LOUVER INOPERABLE.
- 8 FUTURE WATER HEATER LOCATION
- 9 MOP SERVICE BASIN
- 10 FUTURE TOILET ROOM FIXTURE LOCATIONS (RE: PLUMBING DRAWINGS)
- 11 FUTURE WATER COOLER LOCATION
- 12 SLOPE CONCRETE SLAB 1/4" PER FOOT TO FLOOR DRAIN AT FUTURE TOILET ROOMS (RE: STRUCTURAL DRAWINGS)
- 13 ALUMINUM CURTAIN WALL SYSTEM, 6" DEEP FRAME, TYPICAL
- 14 ALUMINUM CURTAIN WALL SYSTEM, 8" DEEP FRAME, TYPICAL
- 15 8" Ø METAL DOWNSPOUT, COLOR TO MATCH METAL PANELS
- 16 EXTERIOR ALUMINUM STOREFRONT DOOR SYSTEM FOR HIGH WATER INGRESS / EGRESS; KEYED CYLINDER LOCK AT INTERIOR AND EXTERIOR
- 17 PROVIDE RIGID INSULATION BOARD AT INTERIOR SIDE OF ALL LOUVERS NOT DUCTED TO MECHANICAL EQUIPMENT (RE: MECHANICAL DRAWINGS)

WALL HATCH LEGEN

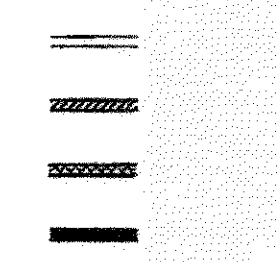

1 2ND FLOOR
 A202 SCALE: 1/8"

NO.	DATE	BY	DESCRIPTION	NO.	DATE	BY	DESCRIPTION	NO.	DATE	BY	DESCRIPTION
1				1				1			