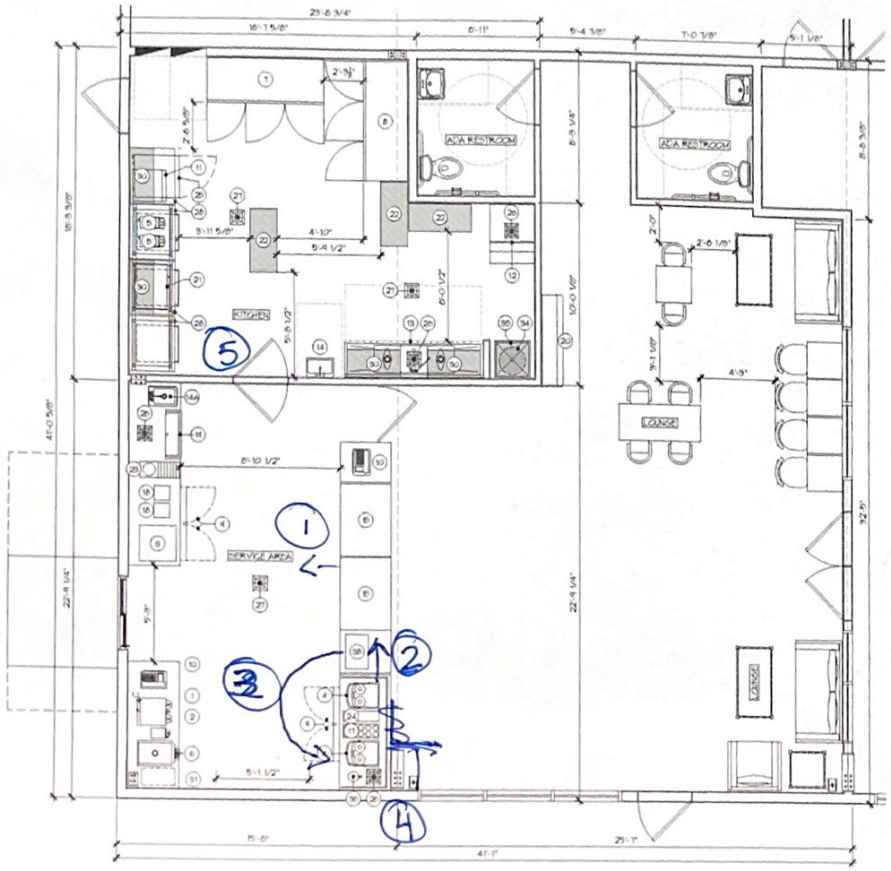

2 PJ'S FLOOR PLAN

EQUIPMENT LIST		
ITEM No.	ITEM DESCRIPTION	NOTES
1	TWIN COFFEE BREWER	
2	SATELLITE WARMER STAND	
3	MERRY CHEF MICROWAVE OVEN	
4	ESPRESSO/CAPPUCCINO MACHINE	
5	COFFEE GRINDER	
6	GRANITA FROZEN DRINK MACHINE	
7	REACH-IN REFRIGERATOR	
8	REACH-IN FREEZER	
9	UNDERCOUNTER REFRIGERATOR	
10	P.O.S. SYSTEM	BY OWNER
11	VENTLESS FRYER (BEIGNET MACHINE)	
12	ICE MACHINE W/ BIN & FILTER	
13	THREE COMPARTMENT SINK 93" L.	
14	HAND SINK W/ FAUCET	
14A	DROP-IN SINK	
15	SELF-SERVE MERCHANDISER 48"L.	
16	SINGLE ROW SYRUP RACK	
17	SYRUP RACK-LARGE	BY OWNER
18	BLENDER	
19	ICE BIN	
20	RETAIL MERCHANDISE CASE 60"L. x 8"H.	SEE 7/A501
21	CONVECTION OVEN - HALF SIZE	
22	WIRE SHELVING	
23	BLENDER CONTAINER RINSER	
24	ROW OF CUPS	
25	UNDERCOUNTER FREEZER	
26	HUB DRAIN	SEE PLUMBING
27	FLOOR DRAIN	SEE PLUMBING
28	MOBILE WORKTABLE, 36"	
29	MOBILE WORK TABLE, 24"	
30	WALL SHELF, 36"	
31		
32	WATER FILTRATION SYSTEM	
33		
34	35GAL WATER HEATER ABOVE MOP SINK	SEE PLUMBING
35	MOP SINK W/ FAUCET	SEE PLUMBING
36	DIPPER WELL W/ FAUCET	
37	UNDER COUNTER SLIM JIM - TRASH CAN	
38	PICK UP/DROP OFF AREA	

1. Move front counter back 4'6" between counters.
2. Shift espresso station plan North
3. Shift P/V area plan south
4. Wrap Counter to storefront
5. flip double acting door swing

DAMMON ENGINEERING INC
LOUISIANA & MISSISSIPPI

NOLA ATHLETIC CLUB
PJ'S COFFEE

SHEET TITLE: FLOOR PLAN

DRAWING NUMBER: A101