


RAMPART STREET ARCADE ENTRANCE ELEVATION | 1/2" = 1'-0" | 11




CANAL STREET ARCADE ENTRANCE ELEVATION | 1/2" = 1'-0" | 04

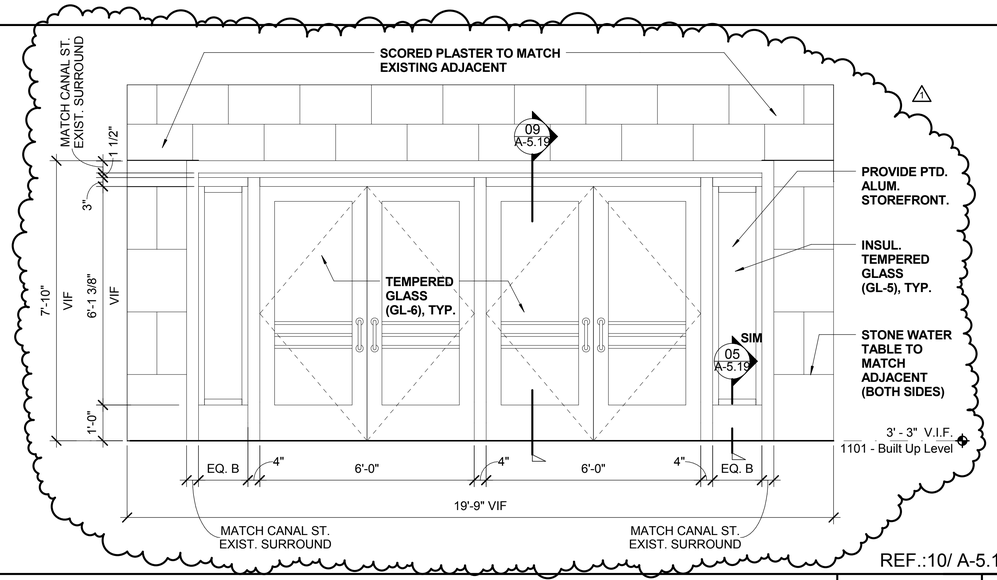


RAMPART STREET PLAN DETAIL | 1/2" = 1'-0" | 10

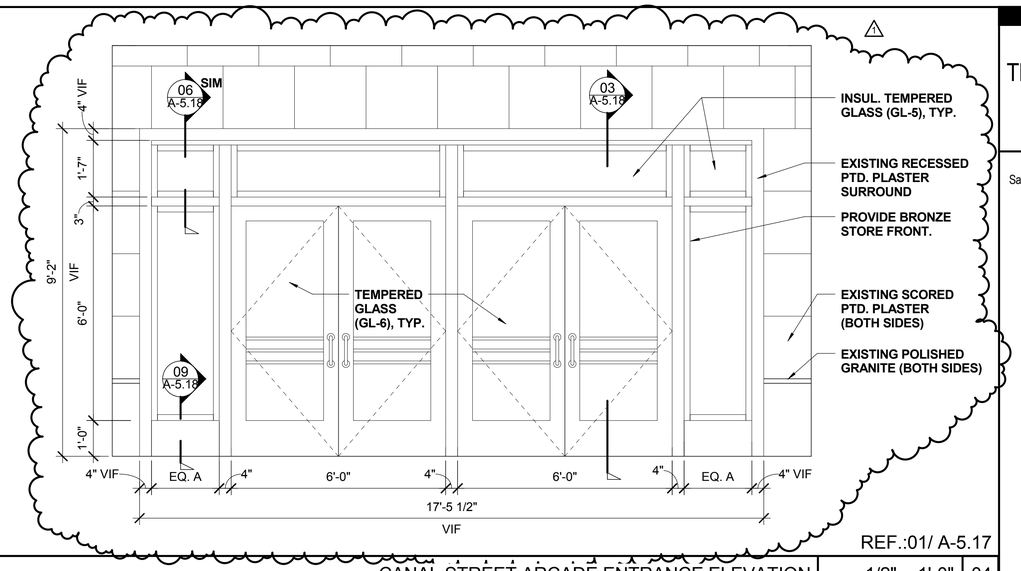


BASIN STREET PLAN DETAIL | 1/2" = 1'-0" | 09

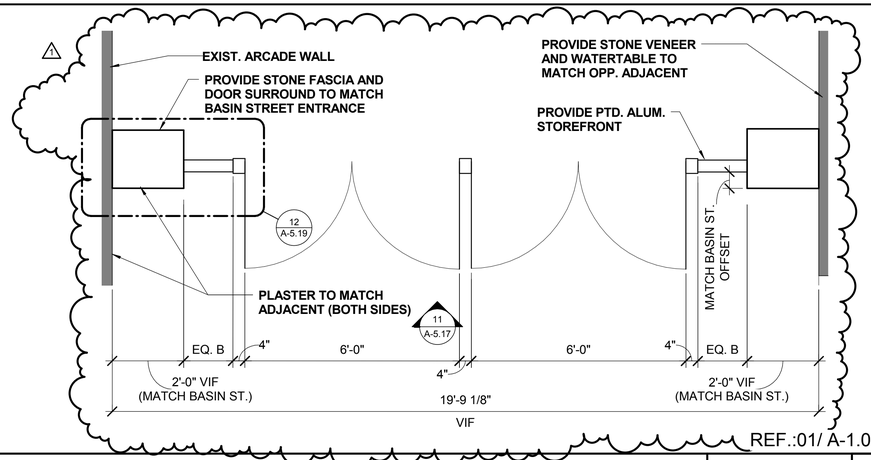


BASIN STREET ARCADE ENTRANCE ELEVATION | 1/2" = 1'-0" | 05

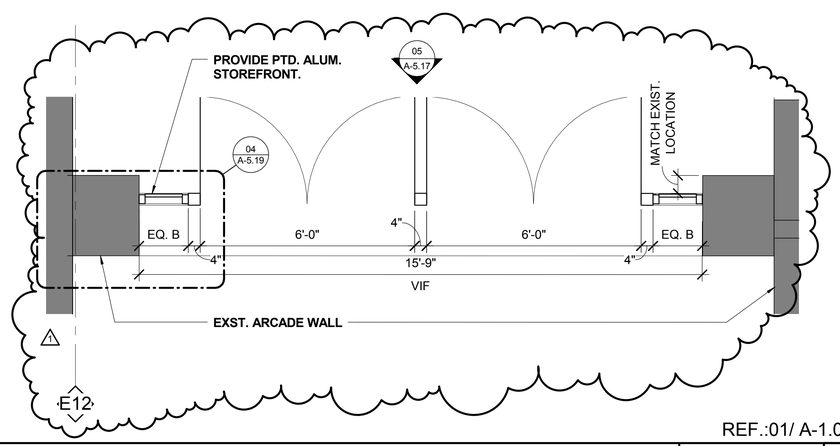


CANAL ST. PLAN DETAIL | 1/2" = 1'-0" | 01

# THE SAENGER THEATRE RENEWAL PROJECT

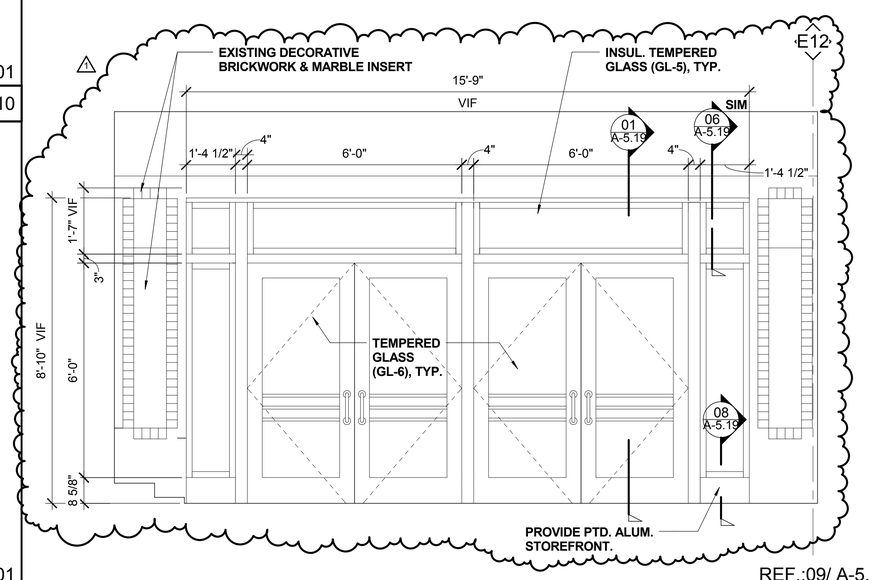142 North Rampart Street
New Orleans, LA


Client
Saenger Theatre Redevelopment Company
1800 Post Oak Boulevard, 6 Boulevard Place, Suite 450, Houston, TX 77056

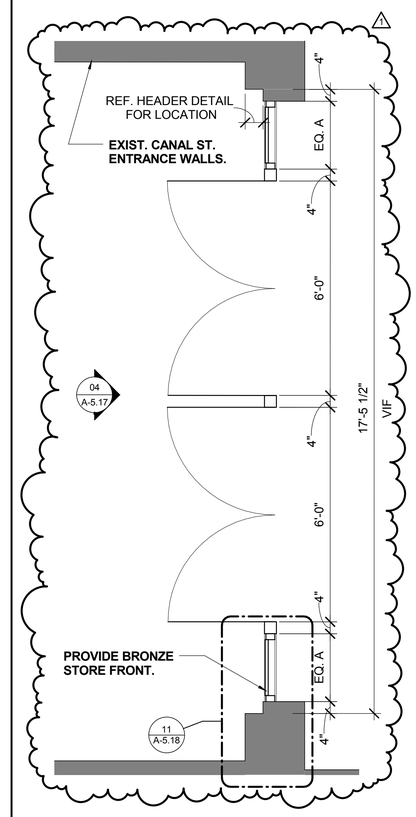Architect
MARTINEZ+JOHNSON ARCHITECTURE
**1412 Eye St., NW**
**Washington, DC 20005**
**202.333.4480**

Structural Engineer
Lundy & Franke Engineering, Inc.
549 Heimer Road, San Antonio, TX 78232
210.979.7900

Theatre Consultant
Schuler Shook
123 Third Street North #210, Minneapolis, MN 55401
612.339.5958

Acoustical Engineer
Akustiks
93 North Main Street, South Norwalk, CT 06854
203.299.1904

MEP Engineer
JBA Consulting Engineers, Inc.
3525 N. Causeway BLVD. Suite 500 Metairie, LA 70002
504.830.0139

Civil Engineer
Linfield, Hunter, & Junius, Inc.
3608 18th Street Suite 200, Metairie, LA 70002
504.833.5300

Architectural Historian
EHT Traceries, Inc.
1121 Fifth Street NW Washington, DC 20001
202.393.1199



THESE DRAWINGS, SPECIFICATIONS, AND OTHER DOCUMENTS, (COLLECTIVELY, THE "DOCUMENTS") INCLUDING WITHOUT LIMITATION ELECTRONIC VERSIONS THEREOF AND THE IDEAS, DESIGNS, AND ARRANGEMENTS REPRESENTED THEREBY, ARE AND SHALL REMAIN THE PROPERTY OF MARTINEZ & JOHNSON ARCHITECTURE PC, AS DEFINED BY APPLICABLE CONTRACTUAL AGREEMENTS ("THE AGREEMENTS") AND AS PROTECTED BY THE COPYRIGHT STATUTES OF THE UNITED STATES. USE OF THE DOCUMENTS SHALL BE STRICTLY LIMITED TO THE PROJECT FOR WHICH THEY WERE PREPARED AND DEVELOPED ("THE PROJECT") PER THE TERMS OF THE AGREEMENTS. NO PART OF THE DOCUMENTS SHALL BE COPIED, DISCLOSED TO OTHERS, OR USED IN CONNECTION WITH ANY OTHER WORK OR PROJECT, OR BY ANY OTHER PERSONS FOR ANY PURPOSES, OTHER THAN THE COMPLETION OF THE PROJECT, WITHOUT THE SPECIFIC WRITTEN AUTHORIZATION OF MARTINEZ & JOHNSON ARCHITECTURE PC. THE DOWNLOADING, OPENING, OR VIEWING OF DIGITAL VERSIONS OR ANY PRINTED DOCUMENTS OR ORIGINALS CONTACTED WITH ANY PRINTED FORM THEREOF SHALL CONSTITUTE CONCLUSIVE EVIDENCE OF ACCEPTANCE OF THESE RESTRICTIONS.
7502


| DATE: | No.: | REVISION: |
|---|---|---|
| 06.16.10 | 1 | PERMIT REVISION |

| DATE: | ISSUE: |
|---|---|
| 02.19.10 | PERMIT SET |
| 04.02.10 | GMP CONTRACT SET |
| 11.11.10 | CONTRACT SET |

SHEET TITLE:
ENLARGED DOOR PLANS AND DETAILS

**A-5.17**

© 2010 M+J