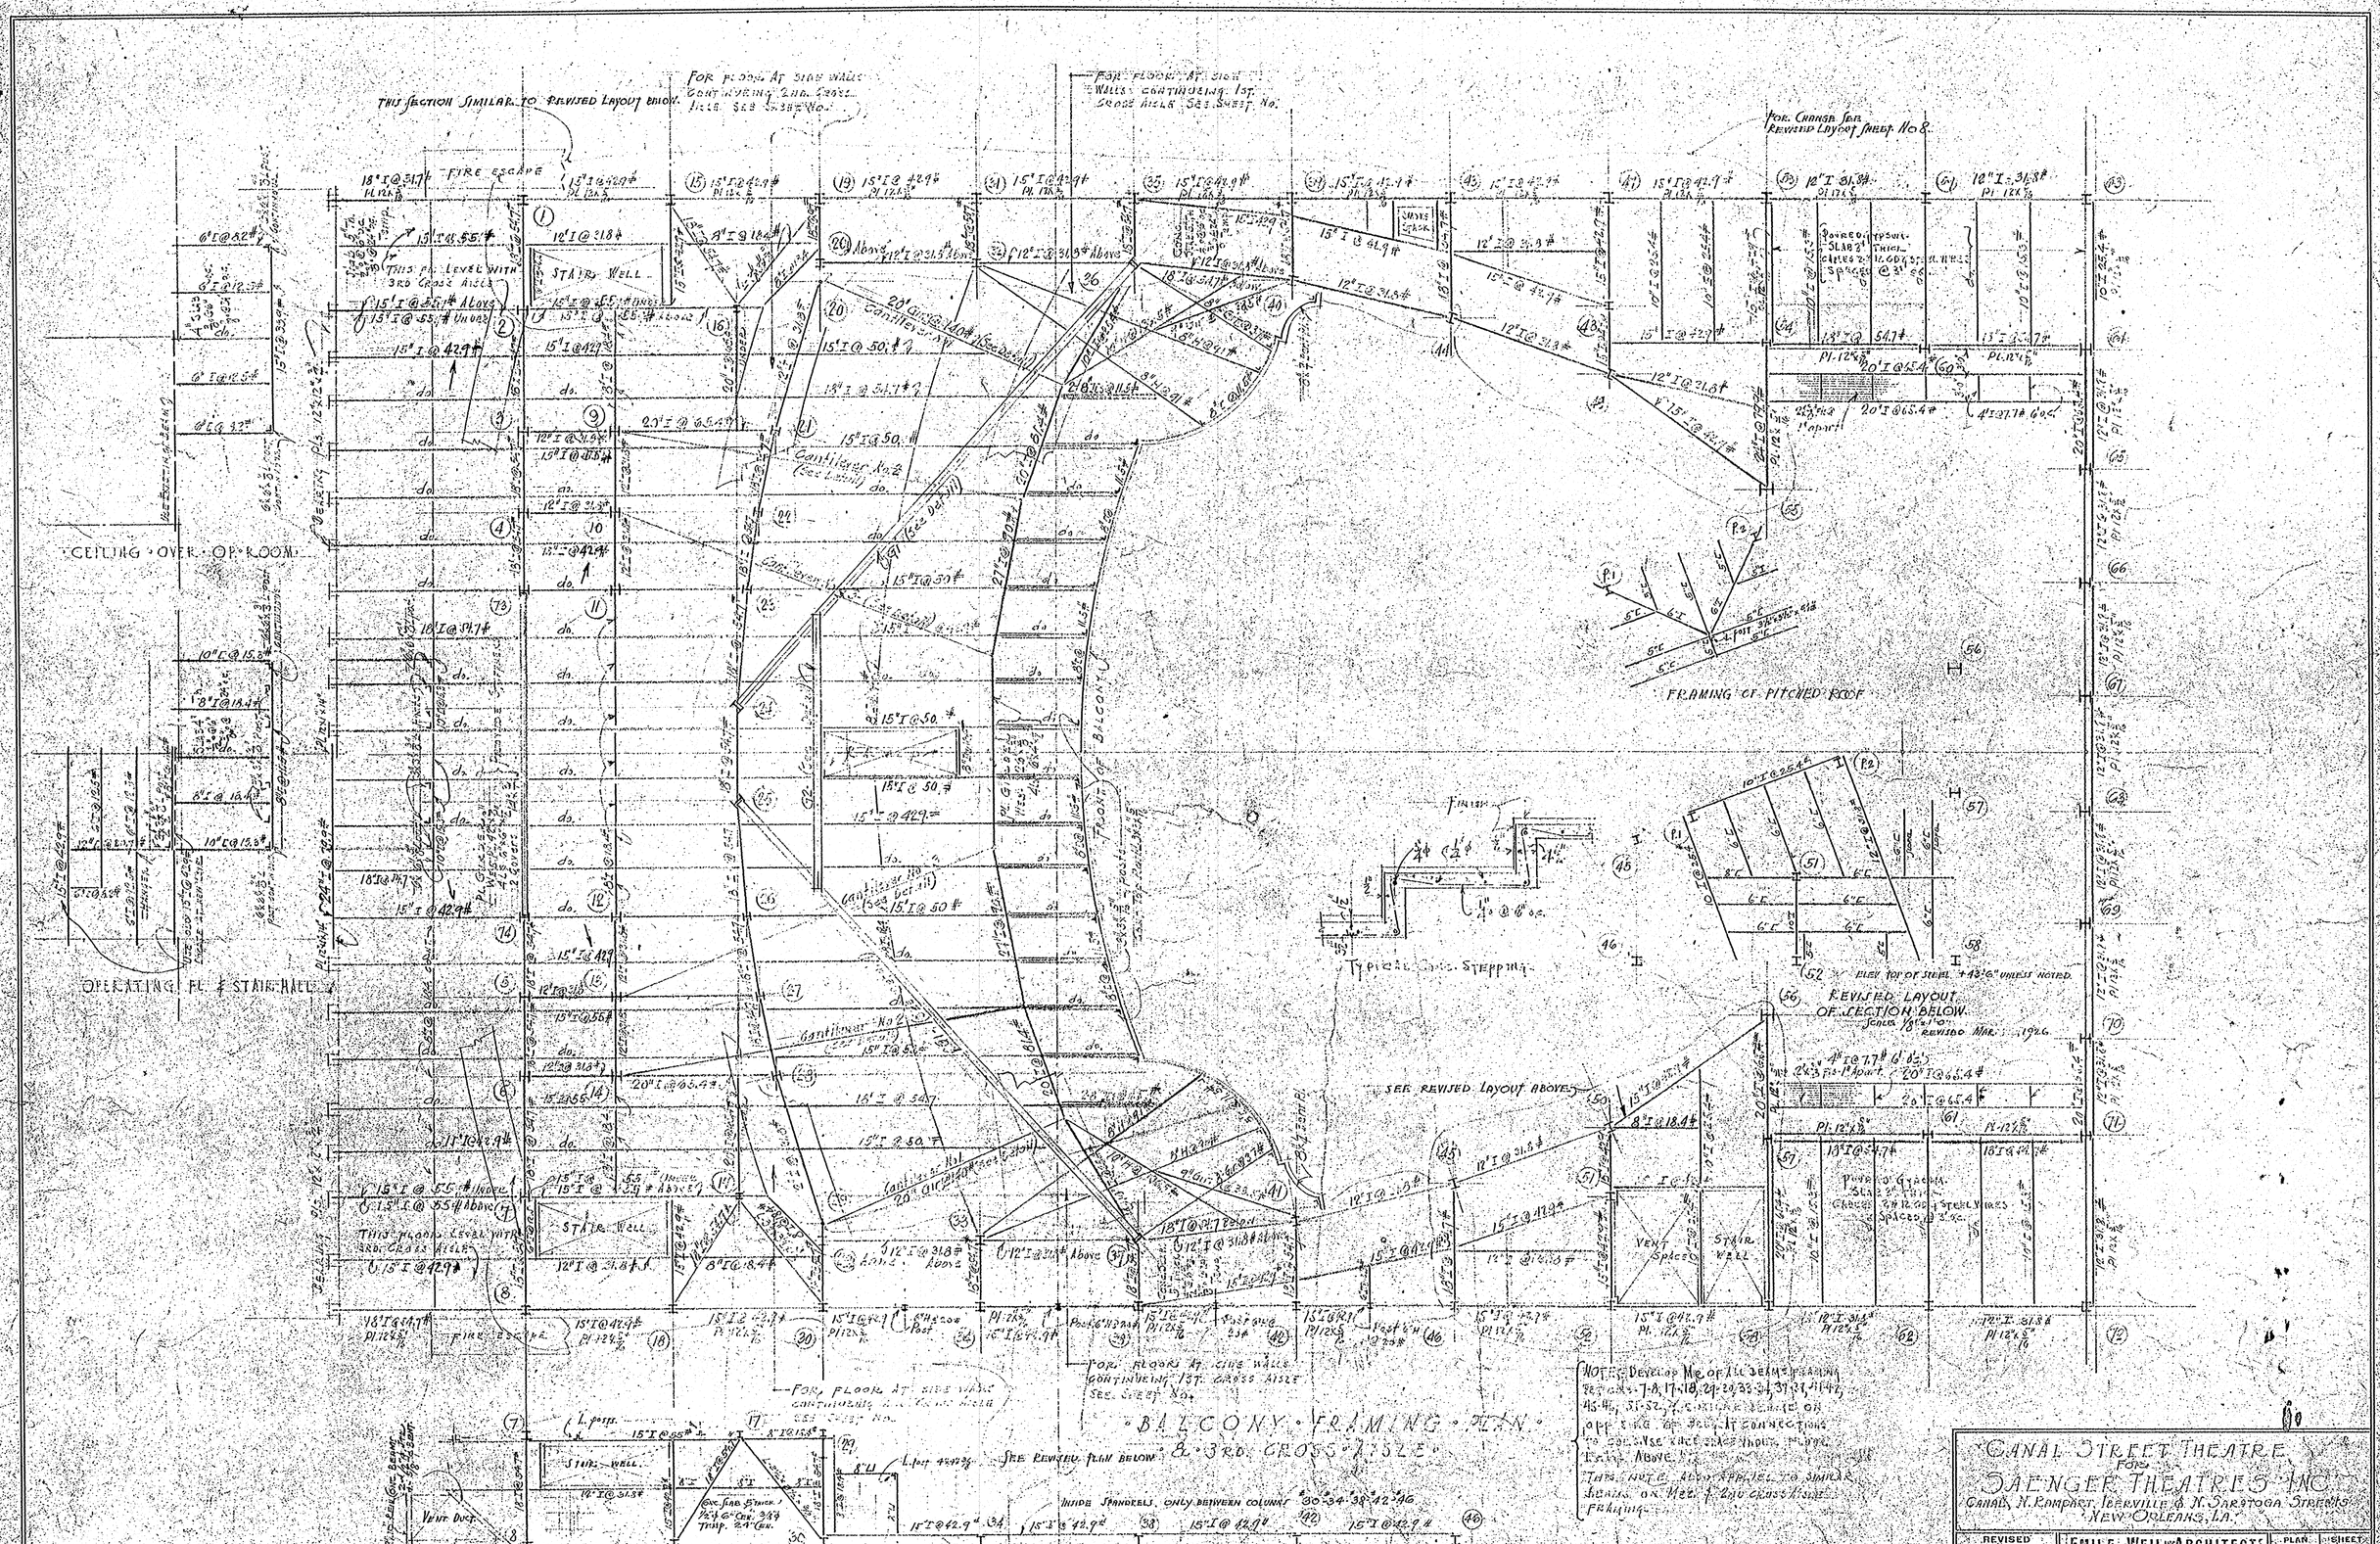
CEILING OVER OP. ROOM
OPERATING RL & STAIR HALL
FIRE ESCAPE
STAIR WELL
BALCONY
Cantilever No. 1
Cantilever No. 2
Cantilever No. 3
Typical Cross Stepping
FRAMING OF PITCHED ROOF
REVISED LAYOUT OF SECTION BELOW
SEE REVISED LAYOUT ABOVE
VENT SPACE
BALCONY FRAMING PLAN & 3RD CROSS AISLE
SEE REVISED PLAN BELOW
REVISED LAYOUT OF SECTION ABOVE
CANAL STREET THEATRE
FOR
SAENGER THEATRES INC.
CANAL, N. ROMPART, IBERVILLE & N. SARATOGA STREETS
NEW ORLEANS, LA.
REVISED DEC. 30th 1925
MARCH 26, 1926
EMILE WEIL INC. ARCHITECTS
WHITNEY CENTRAL BUILDING
NEW ORLEANS, LA.
PLAN 894
SHEET 10
DATE NOV. 3rd 1925