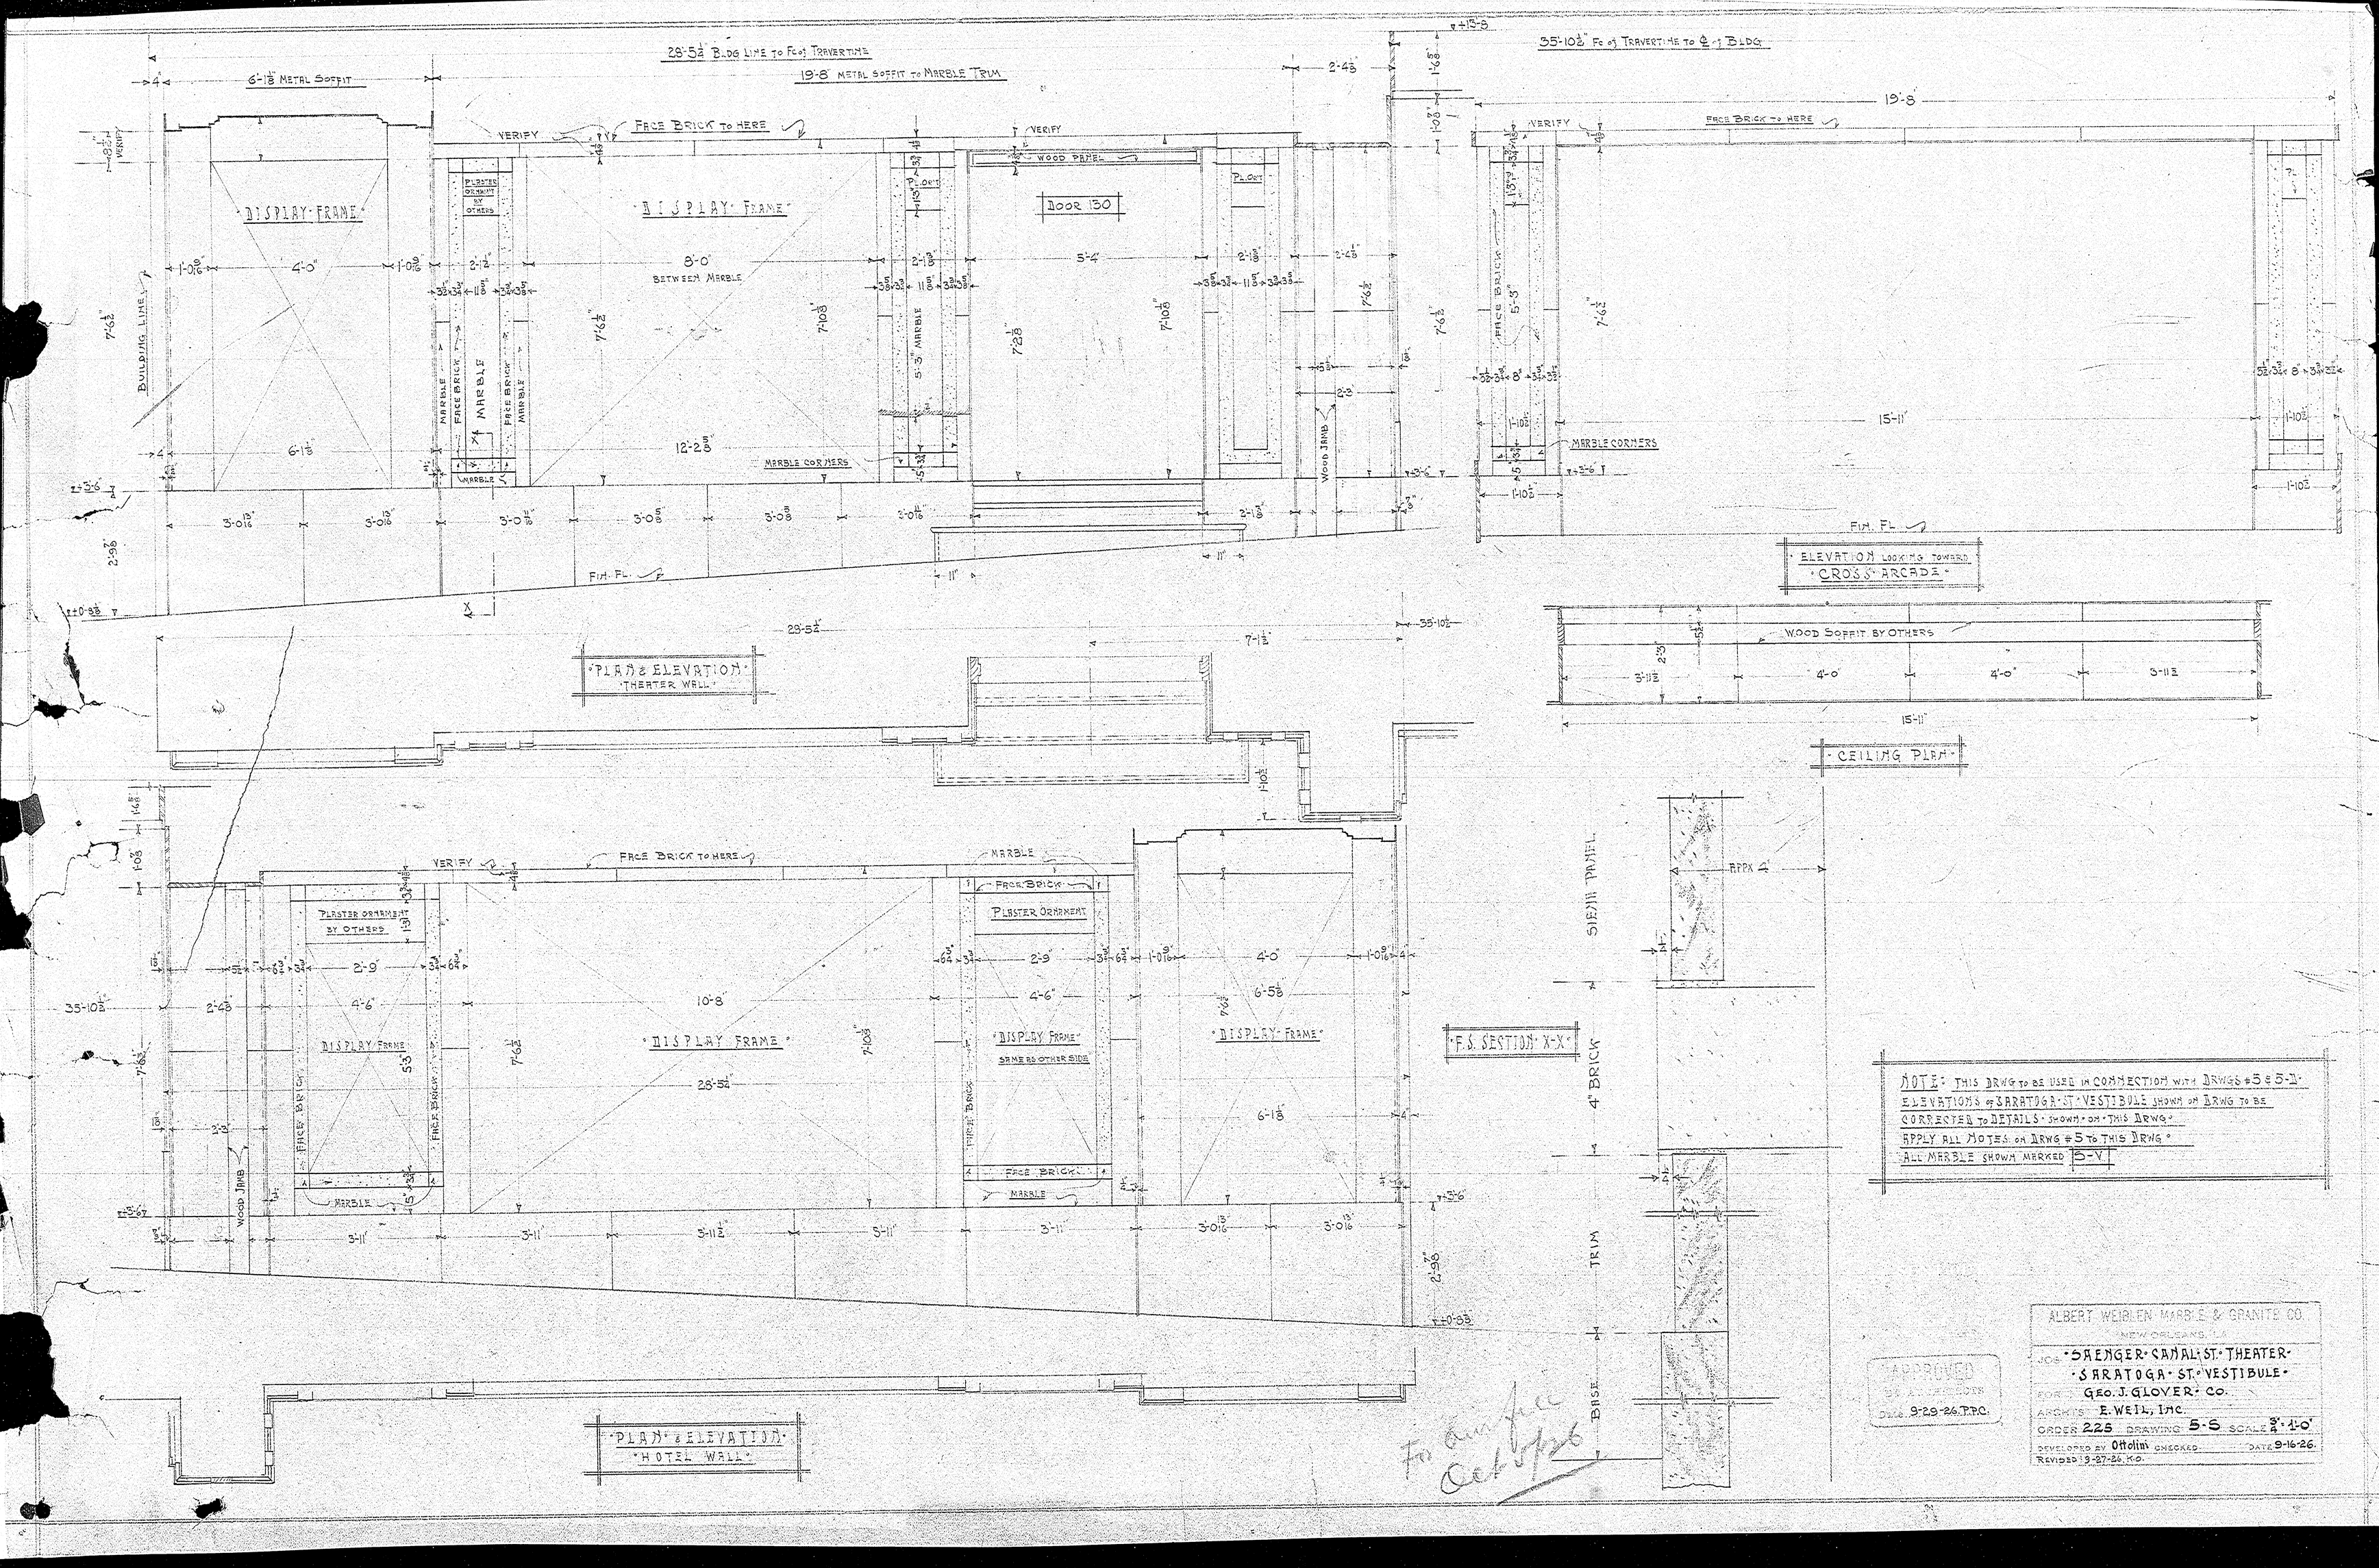

NOTE: This drwg to be used in connection with Drwgs #5 & 5-A. Elevations of Saratoga St. Vestibule shown on drwg to be corrected to details shown on this drwg. Apply all notes on drwg #5 to this drwg. All marble shown marked B-V

APPROVED
Date 9-29-26 T.P.C.

For Surface Oct 1/26

ALBERT WEIBLEN MARBLE & GRANITE CO.
NEW ORLEANS, LA.

JOB: "Saenger Canal St. Theater"
"Saratoga St. Vestibule"
FOR: Geo. J. Glover Co.
ARCHITS: E. Weil, Inc.
ORDER 225 DRAWING 5-6 SCALE ¾" = 1'-0"
DEVELOPED BY Ottolini CHECKED DATE 9-16-26
Revised 9-27-26 K.O.