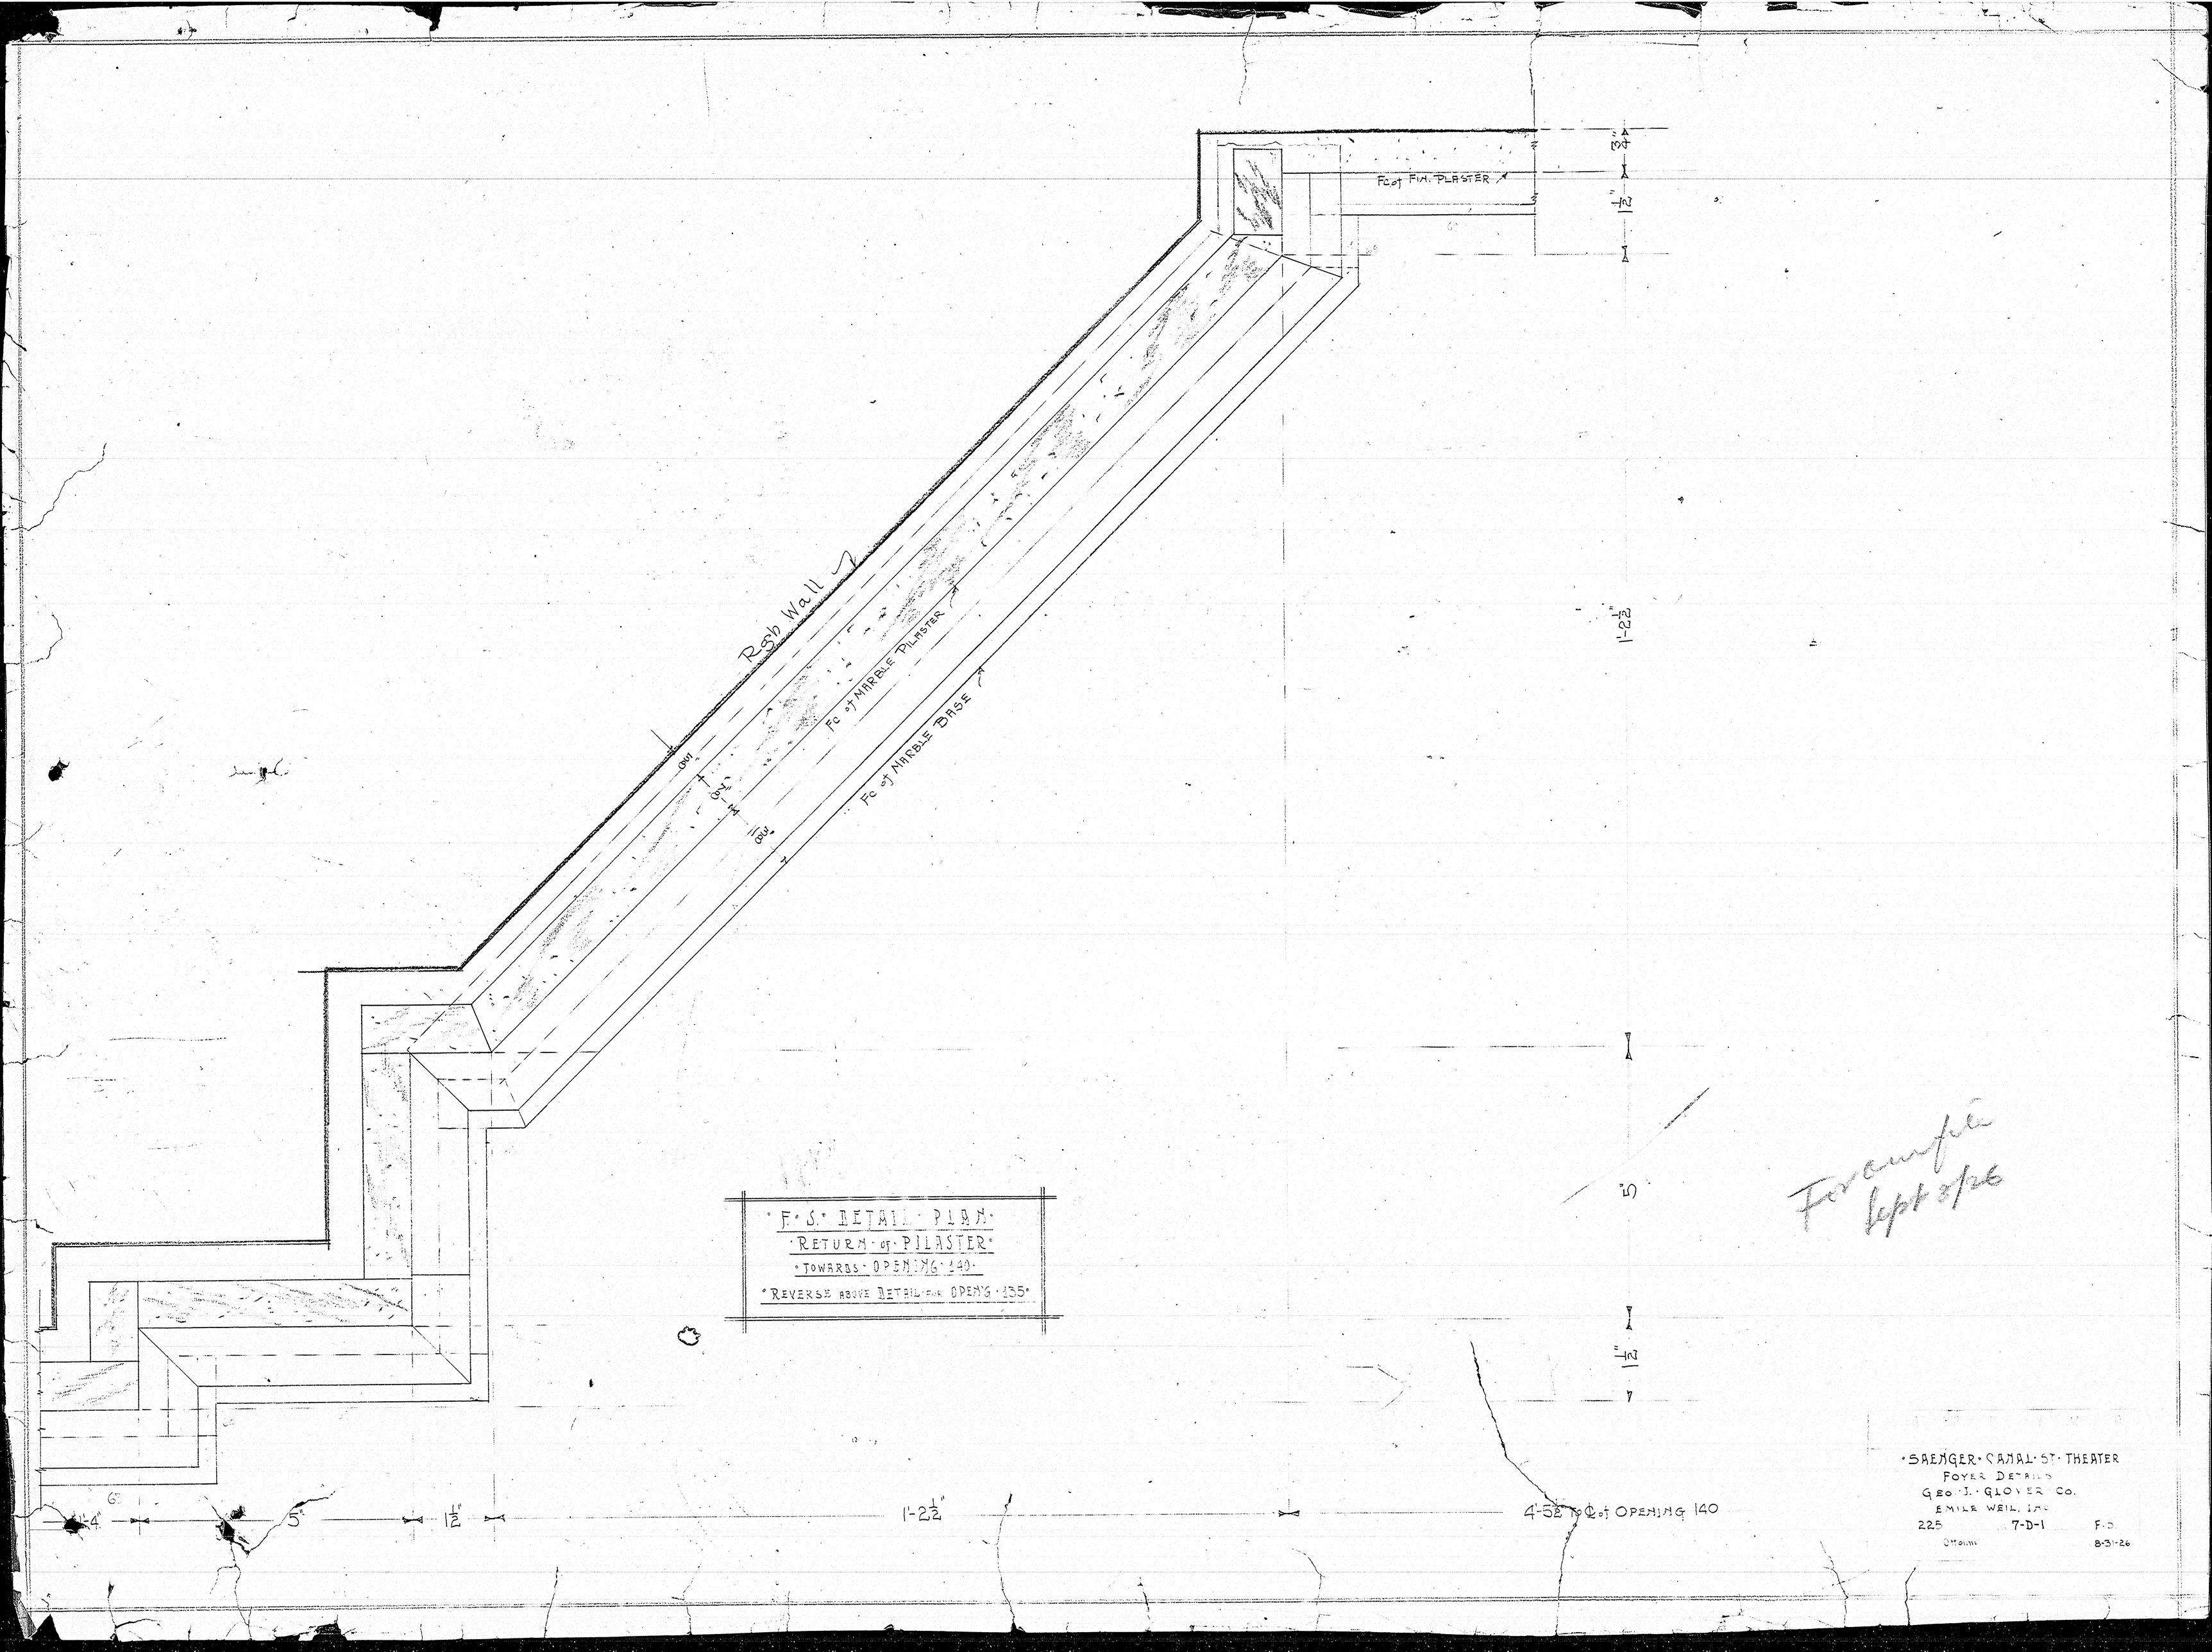
Face Fin. Plaster
Rob Wall
Face of Marble Pilaster
Face of Marble Base
1'-2½"
5"
1'-4"
6"
5"
1½"
1'-2½"
4'-5¾" to ℄ of Opening 140
F.S. Detail Plan
Return of Pilaster
Towards Opening 140
Reverse above Detail for Opening 135
Foremen file Sept 8/26
Saenger Canal St. Theater
Foyer Details
Geo. J. Glover Co.
Emile Weil, Inc.
225
7-D-1
F.D.
8-31-26