


ST. TAMMANY
PARISH Library

Rest Room
Addition

2-18-10

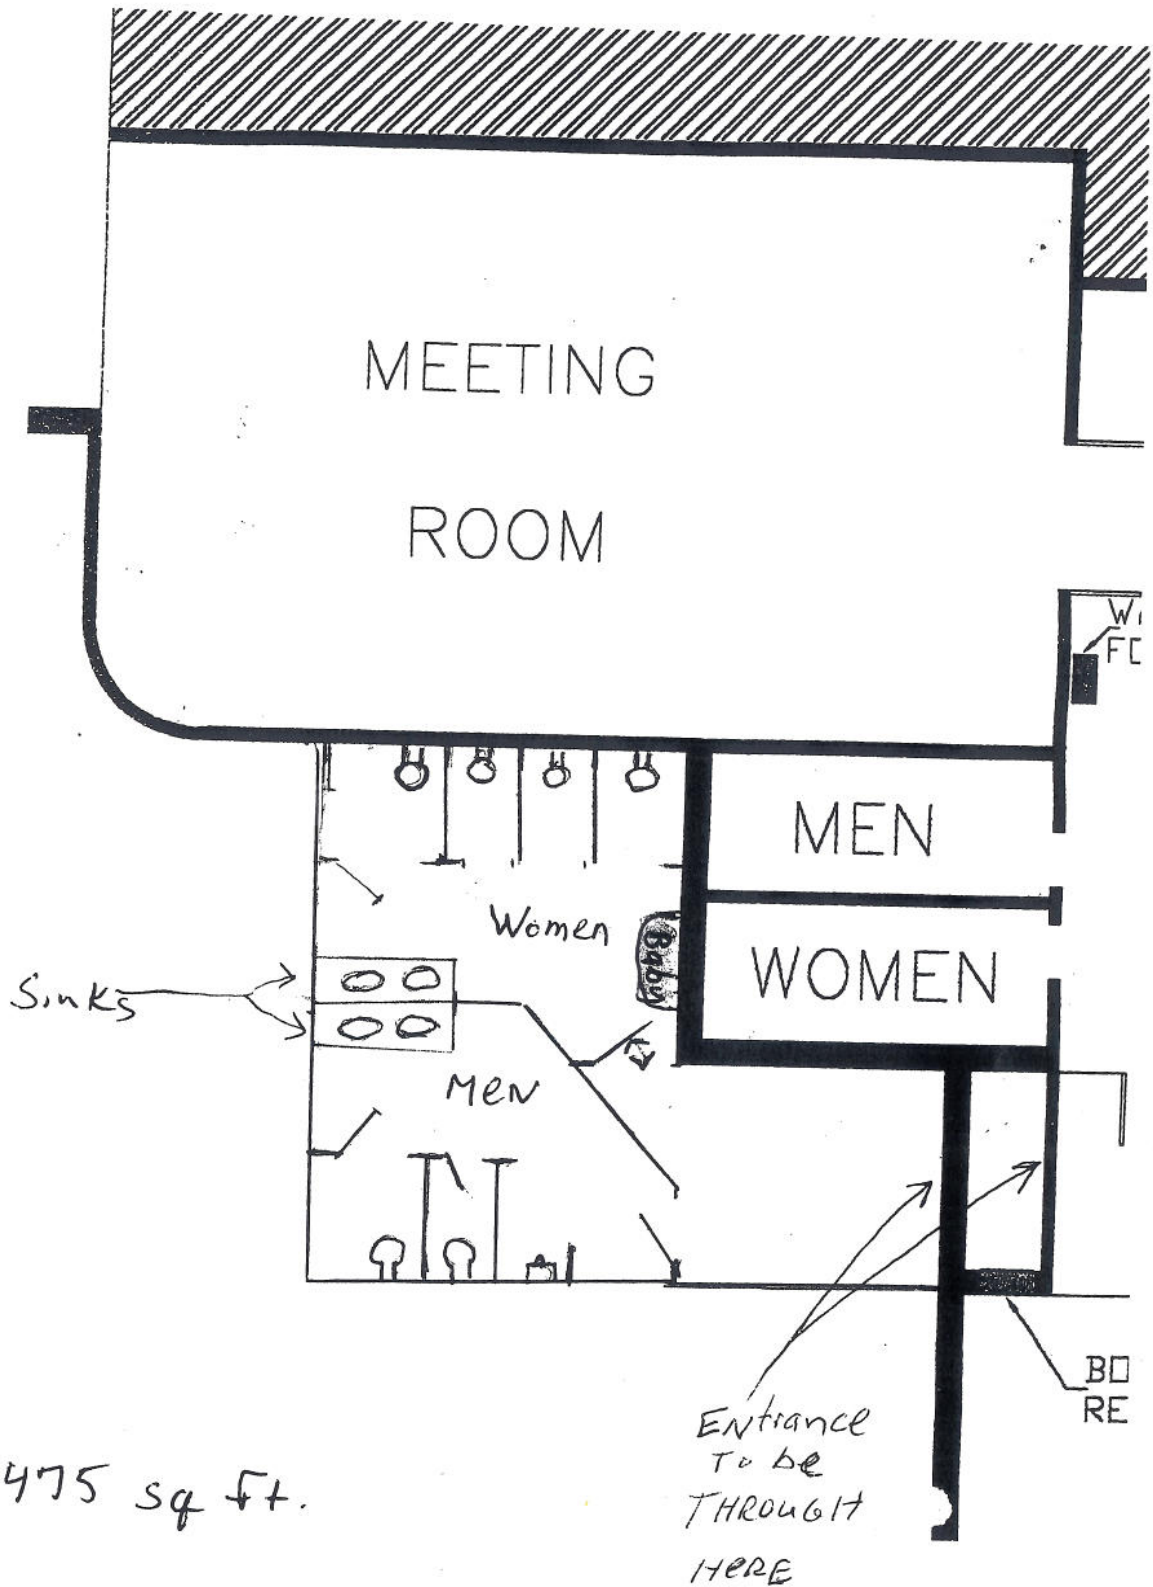

Approx 475 sq ft.

1/8" scale