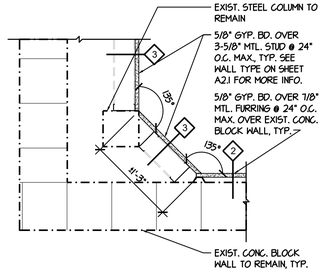

4 / A1.0 COLUMN/ WALL INTERSECTION DET.

SCALE: 1" = 1'-0"

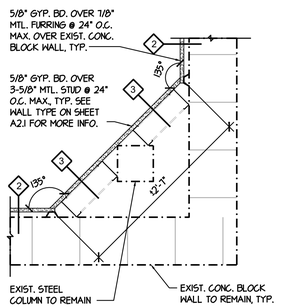

5 / A1.0 COLUMN/ WALL INTERSECTION DET.

SCALE: 1" = 1'-0"

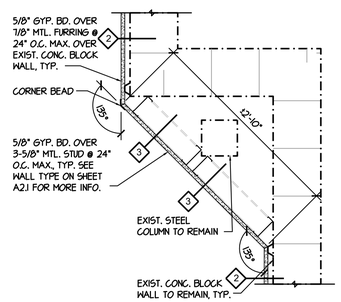

6 / A1.0 COLUMN/ WALL INTERSECTION DET.

SCALE: 1" = 1'-0"

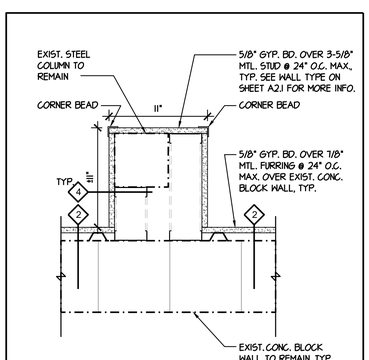

7 / A1.0 COLUMN ENCLOSURE DET.

SCALE: 1-1/2" = 1'-0"

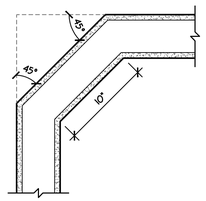

2 / A1.0 TYP. PTN. CORNER DET.

SCALE: 1-1/2" = 1'-0"

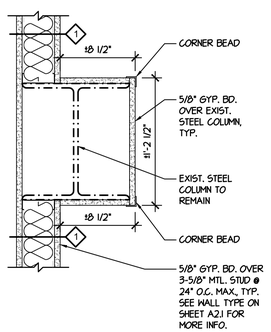

3 / A1.0 COLUMN/ WALL INTERSECTION DET.

SCALE: 1-1/2" = 1'-0"

LINE TYPES LEGEND

SYMBOL	DESCRIPTION
	EXISTING
	DEMO
	NEW WALL
	NEW

FLOOR PLAN LEGENDS

	CAPPED WATER & SEWER STUB-UP, SEE PLUMB. DWGS		
⊠P.V.	VENT FOR PEDICURE STATION , TYP.	⊠N.V.	VENT FOR MANICURE STATION , TYP.
◇ #	WALL TYPE. SEE WALL TYPE ON SHEET A2.1		
#	WINDOW TYPE. SEE WINDOW SCHED. ON SHEET A2.1		
#	DOOR TYPE. SEE DOOR SCHED. ON SHEET A2.1		

LIFE SAFETY LEGENDS

EXIT	NEW EXIT SIGN
	EGRESS PATH
FE	NEW FIRE EXTINGUISHER

LIFE SAFETY NOTES

1. REFER TO A2.0 FOR ROOM FINISH SCHEDULE.
2. ADDITIONAL EXIT SIGNS & EMERGENCY LIGHTS MAY BE REQUIRED BY THE FIRE INSPECTOR AT THE TIME OF THE FIRE FINAL.
3. FIRE EXTINGUISHERS SHALL BE MOUNTED AT 48" A.F.F. AND SHALL BE CURRENTLY DATED AND TAGGED BY LICENSED FIRE EQUIPMENT COMPANY.
4. NUMERICAL ADDRESS WILL BE PROVIDED ON ALL EXTERIOR DOORS AS PER CITY ORDINANCE 52.10 WITH 6 INCH NUMBER, WATERPROOF, AND CONTRASTING COLORS. IF THE ADDRESS IS TO BE PLACED ON A WINDOW THE NUMBER SHALL BE COLOR WHITE, IF THEY ARE TO BE ON A LIGHT COLORED BACKGROUND THEY SHALL BE BLACK.
5. SEPARATE FIRE SPRINKLER SHOP DRAWINGS DESIGNED BY A LICENSED AND CERTIFIED FIRE SPRINKLER CONTRACTOR WILL BE REQUIRED & PROVIDED BY THE FIRE SPRINKLER SUBCONTRACTOR PRIOR TO INSTALLATION OF SUCH.
6. ALL DOORS IN THE MEAN OF EGRESS SHALL BE SINGLE ACTION RELEASE AND SHALL NOT REQUIRE THE USE OF A KEY, TOOL, OR SPECIAL KNOWLEDGE TO OPEN FROM EGRESS SIDE SHALL COMPLY WITH NFPA 101:7.2.1.5.1 AND NFPA 101:7.2.1.5.2.
7. ON FLOOR IN FRONT OF THE ELECTRICAL BREAKER PANELS, YELLOW STRIPING/ HASH MARKS WILL BE PAINTED OUT 3 FEET FROM THE WALL AND EXTENDING 1 FOOT PAST EACH SIDE OF THE ELECTRICAL PANEL(S), WITH THE WORDING "NO STORAGE, DO NOT BLOCK"

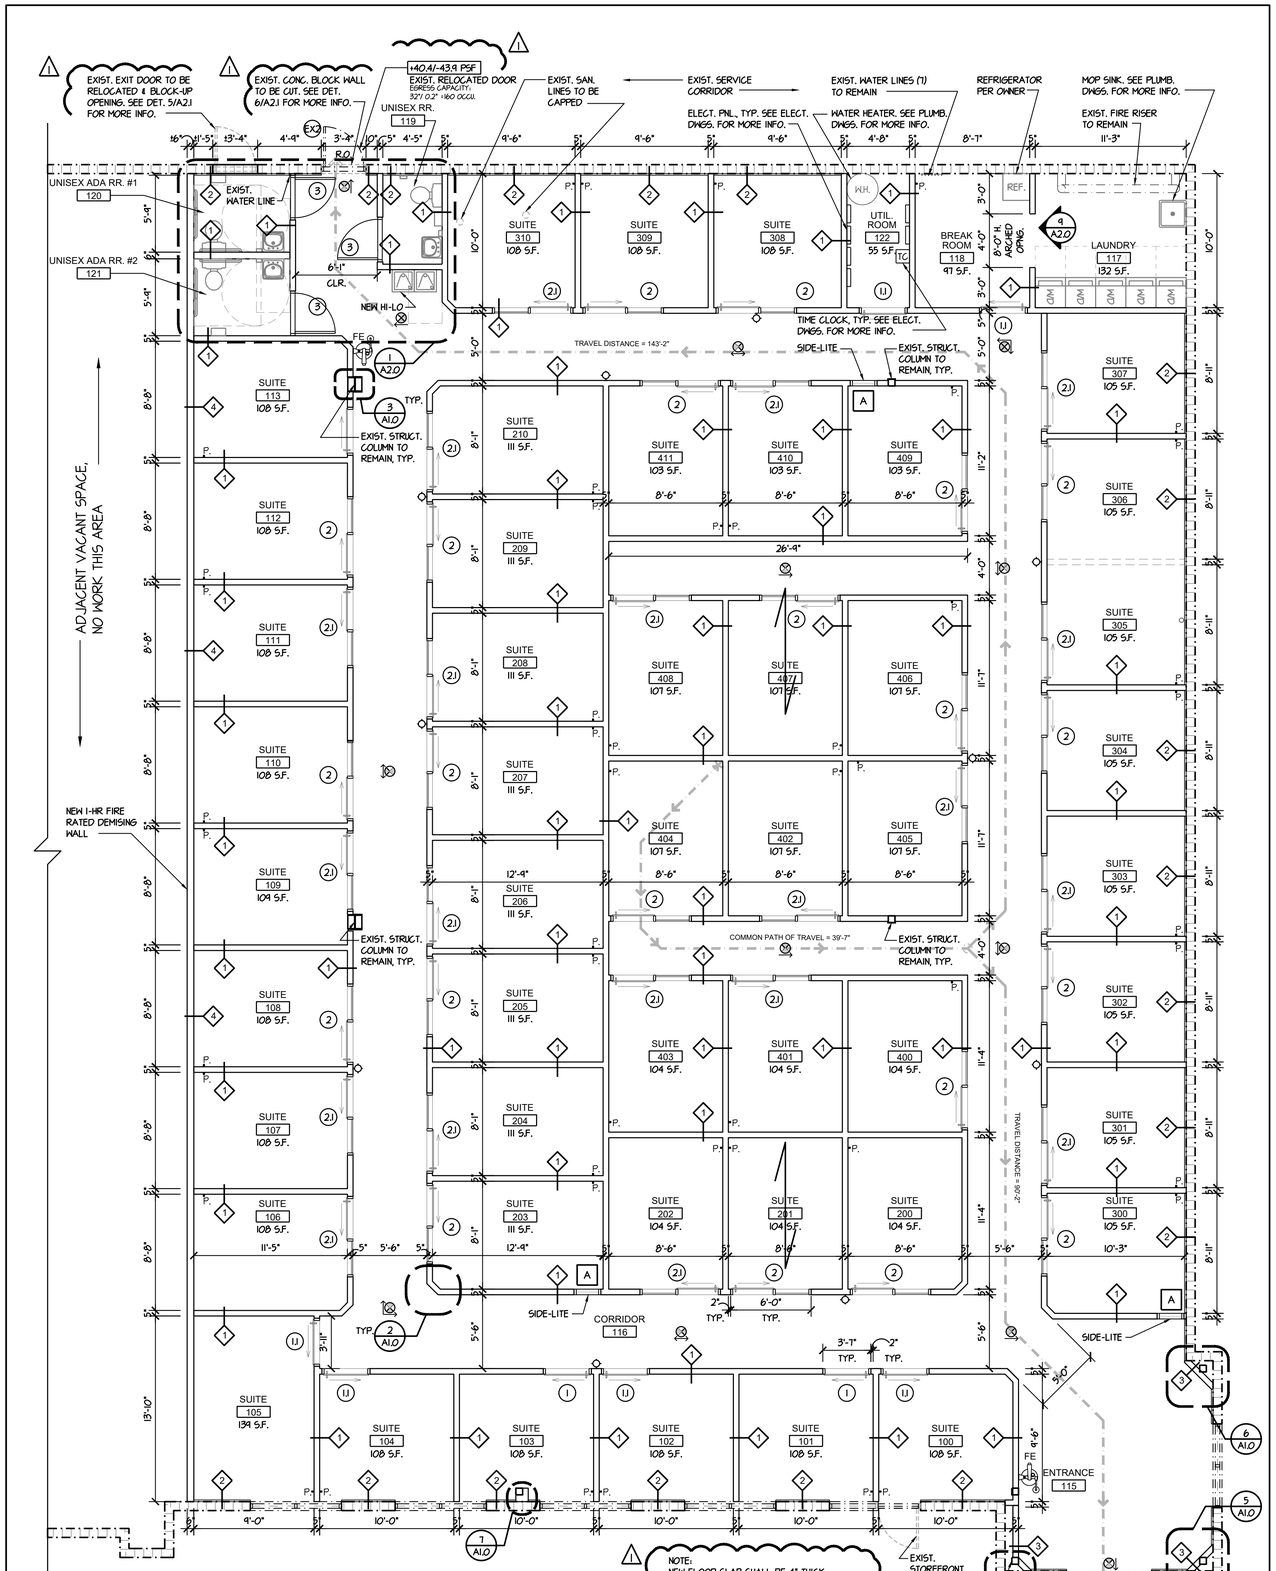

1 / A1.0 PROPOSED FLOOR PLAN

SCALE: 3/16" = 1'-0"

48 SUITES

TOTAL AREA: 7623 S.F.

N

PROPOSED SALON SUITES AT TREASURE COAST SQUARE

3174 N.W. FEDERAL HIGHWAY UNIT 3490

JENSEN BEACH, FL. 34957

SALTZ MICHELSON ARCHITECTS
3501 Griffin Road
Ft. Lauderdale, FL 33312
(954) 266-2700 Fx: (954) 266-2701
sma@saltzmichelson.com

AA-0009976

STATE OF FLORIDA
CHARLES MICHELSON
AR9976
REGISTERED ARCHITECT

Charles Michelson AR0009976

Project No.: 2022-203
Drawn By: YC
Checked By: MA
Date: 02/03/23

REVISIONS

1 GEN. COORD. 06/14/2023

Drawing name: S:\Projects\2022\2022-203\Drawings\01 CD\A01 Interior Comp\2022-203 A01.PTP 1:50.dwg Layout Name: A1.0 Plotted by: gloria Plotted on: Jun 23, 2023 - 10:45am

PROPOSED FLOOR PLAN

A1.0