I CERTIFY THAT THIS PLAT REPRESENTS AN ACTUAL GROUND SURVEY AND THAT TO THE BEST OF MY KNOWLEDGE NO ENCROACHMENTS EXIST EITHER WAY ACROSS ANY OF THE PROPERTY LINES, EXCEPT AS SHOWN.

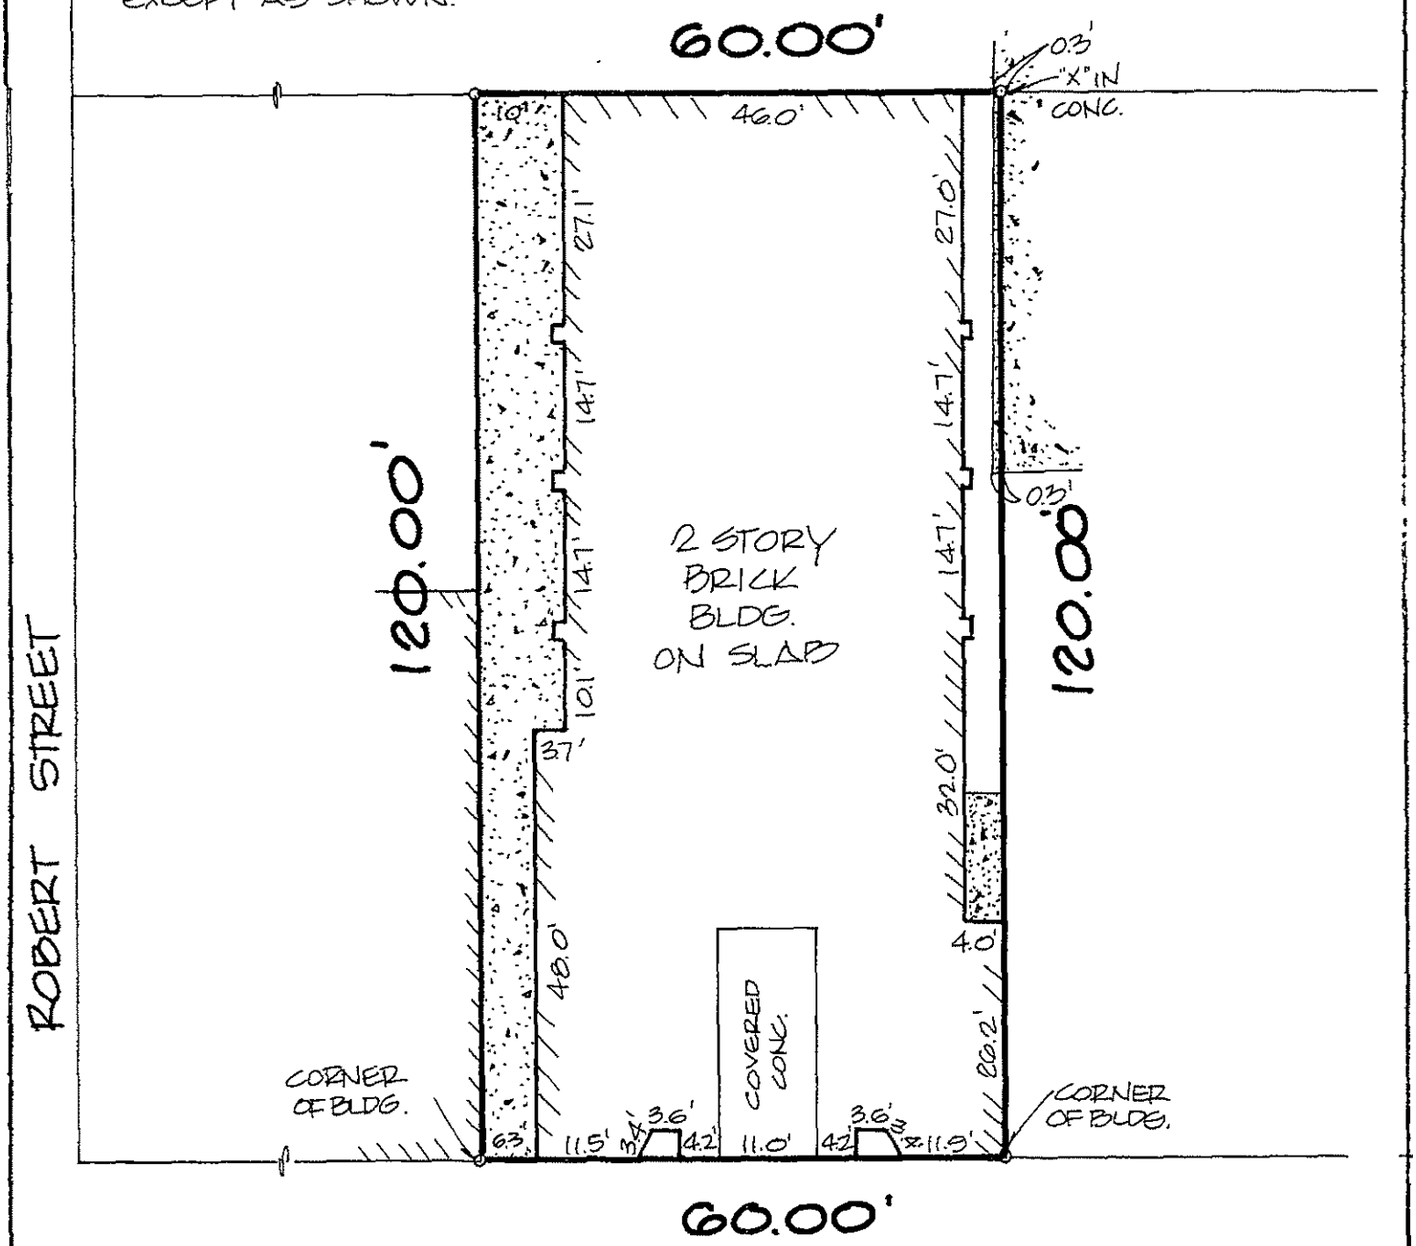

CAREY STREET

MUNICIPAL ADDRESS: 2247, 2249, 2251 CAREY STREET

PANEL 220204 0005 B

FLOOD HAZARD ZONE A4.

SURVEY N° 940538	**J. V. BURKES & ASSOC., INC.**	DWN. BY: CAD
DATE: 5-13-1994	P.O. BOX 1568 SLIDELL, LA. 70459	

SURVEY MAP OF: LOT 13 · SQ. A

LOCATED IN: TOWN OF SLIDELL

ST. TAMMANY PARISH, LA.

CERTIFIED TO:

VINTAGE SQUARE, INC.

SURVEYED BY:
J.V. BURKES III
LA. REG. N° 840
SLIDELL, LA

SCALE: 1"=20'