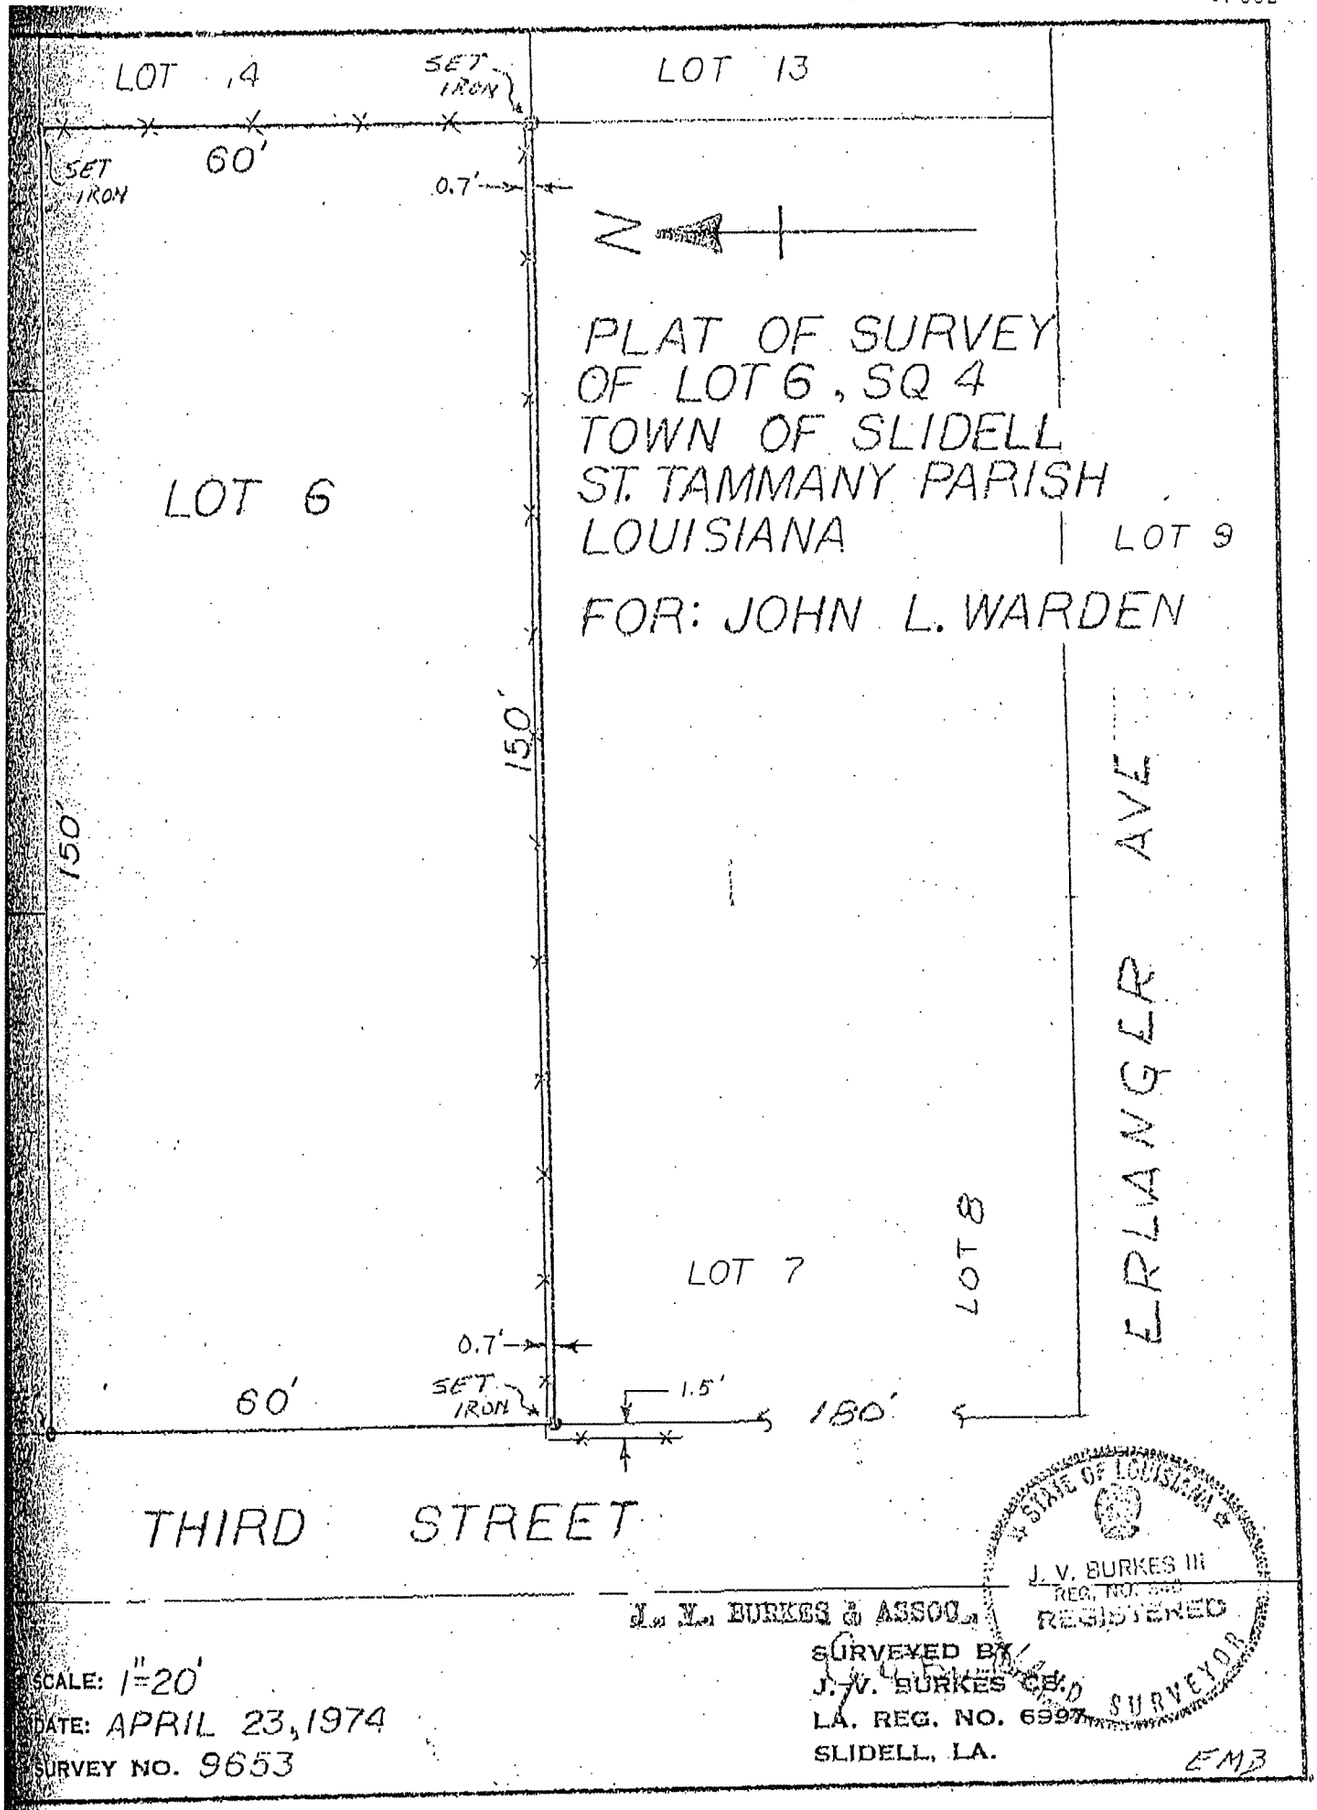

J. V. BURKES & ASSOC.

SCALE: 1"=20'

DATE: APRIL 23, 1974

SURVEY NO. 9653

SURVEYED BY:
J. V. BURKES JR.
LA. REG. NO. 6997
SLIDELL, LA.

STATE OF LOUISIANA
J. V. BURKES III
REG. NO. 6997
REGISTERED
PROFESSIONAL LAND SURVEYOR

EMB

NEW ORLEANS BLUE 6-73