




24x 1/2'

STAD 14


31" TIE Hoop Down

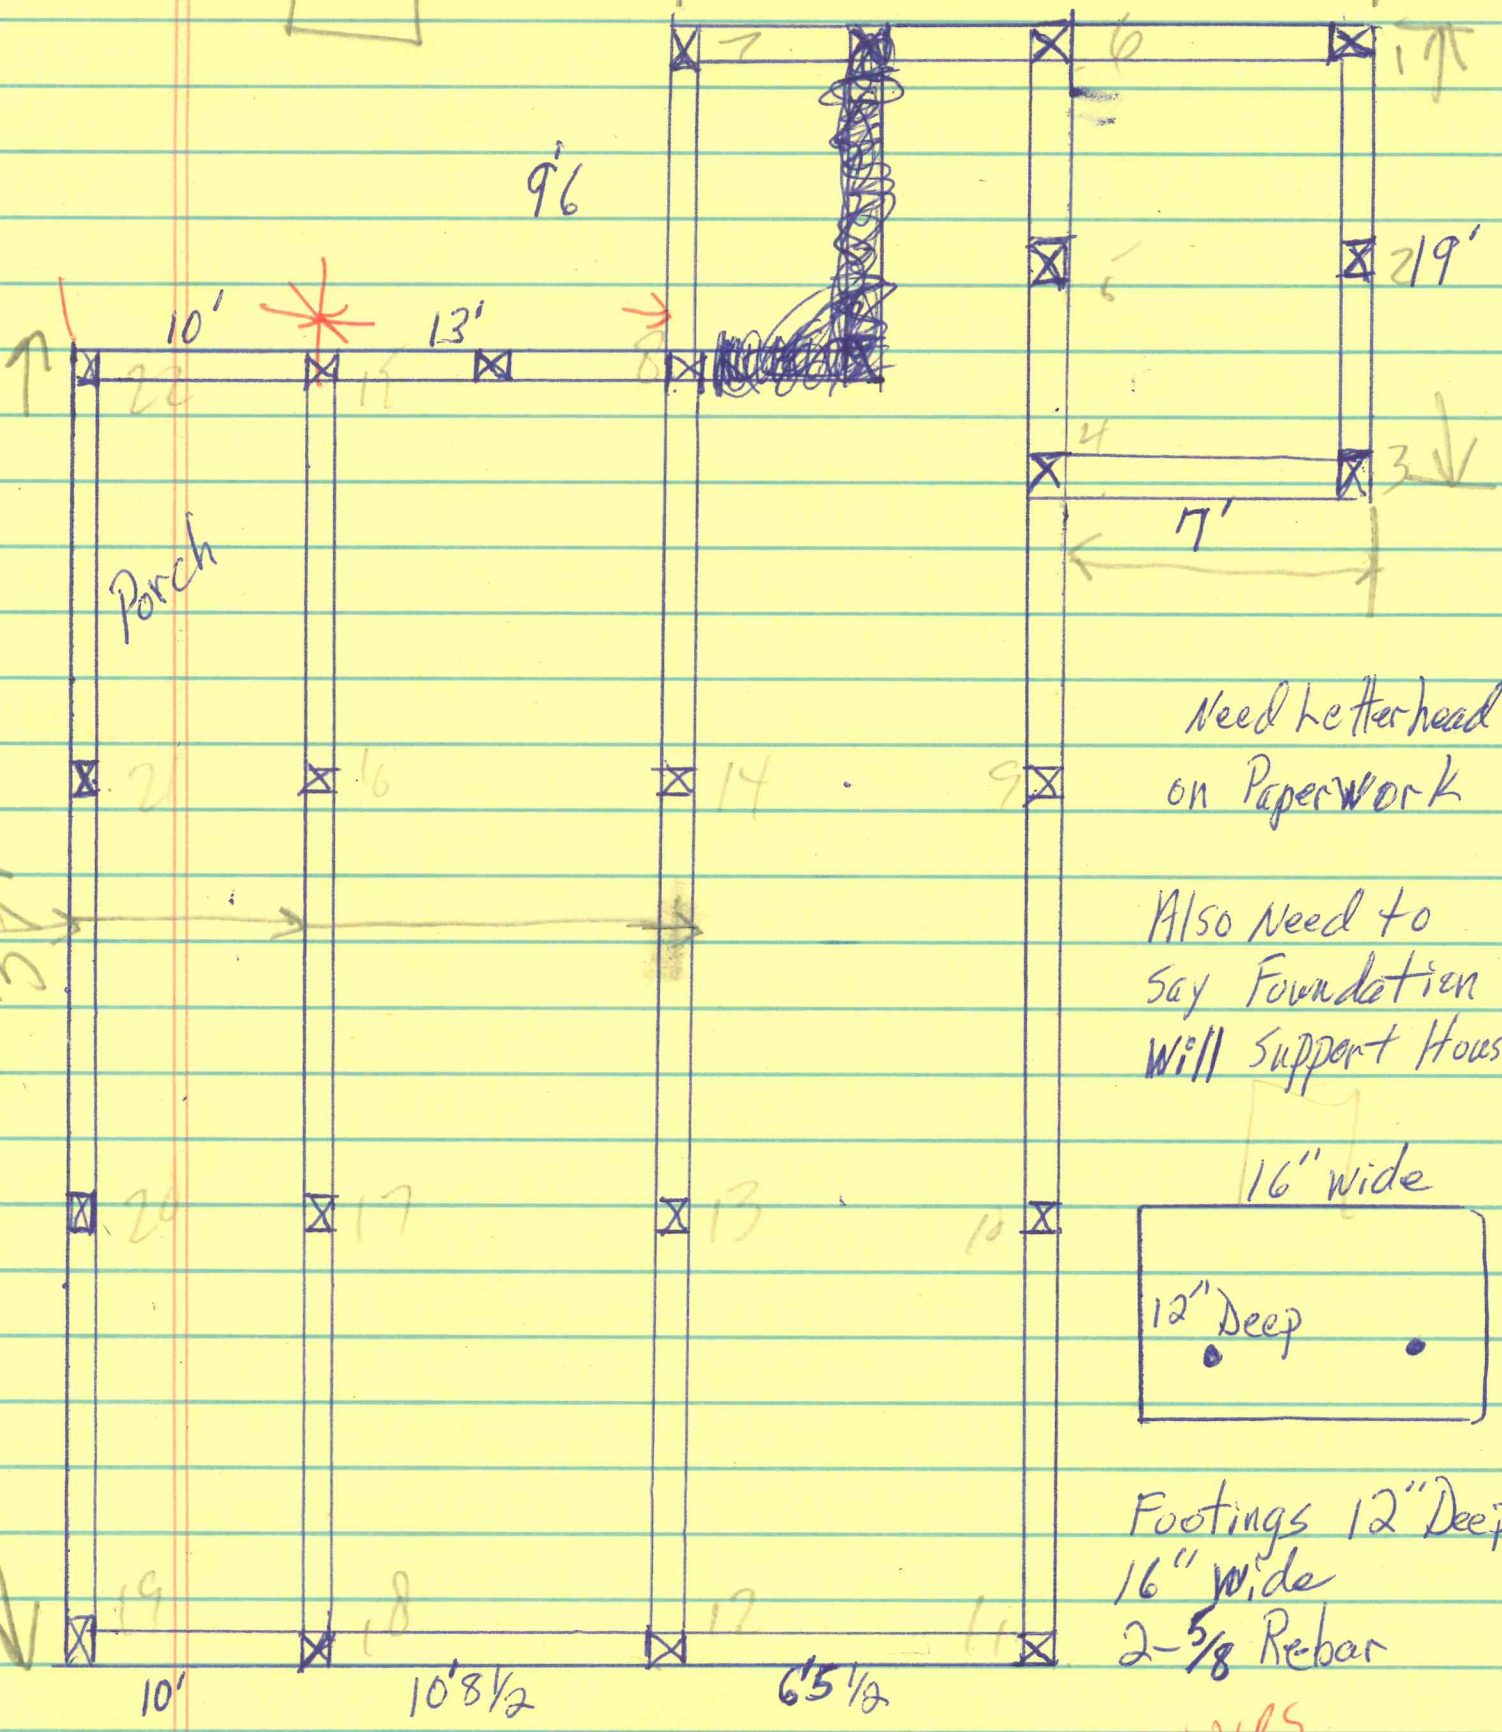

Porch

Need letterhead on Paperwork

Also Need to say Foundation Will support House

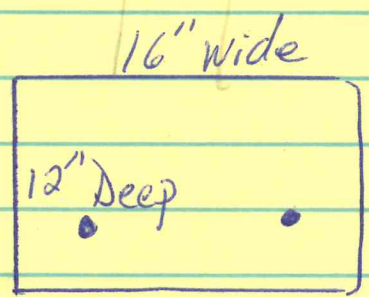

Footings 12" Deep
16" wide
2-5/8 Rebar

2X10 Floor Joist

CHAIRS

8x16 Boards 1000 PS Fiberglass