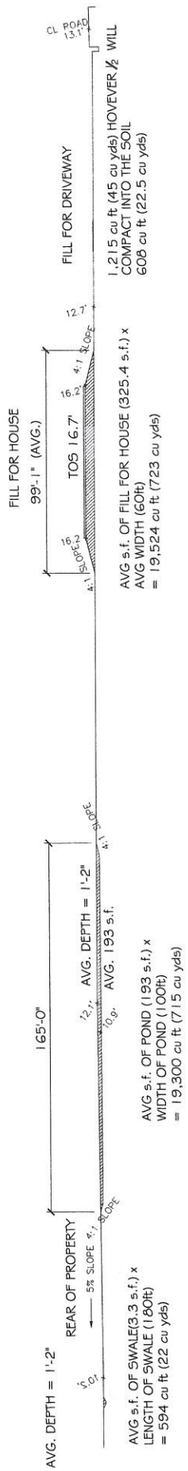

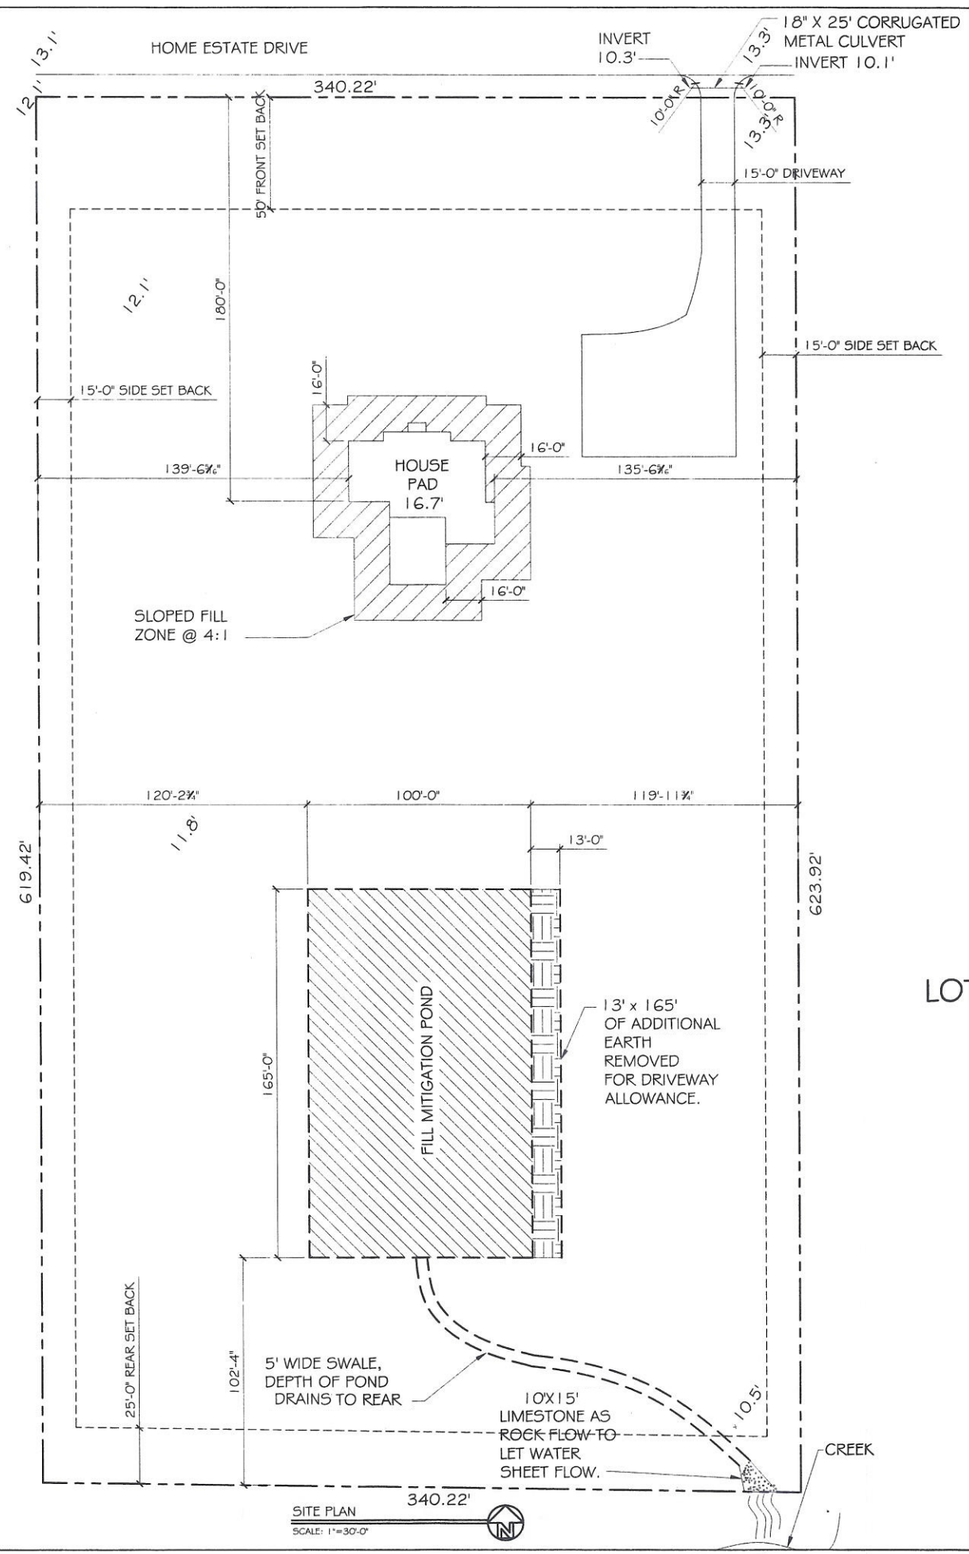

AVG. DEPTH = 1'-2"
AVG s.f. OF POND (107 s.f.) x LENGTH OF POND (165ft) = 17,655 cu ft (654 cu yds)

LOT Q HOME ESTATES ACRES
ST.TAMMANY PARISH

DRIVEWAY	1,215
RESIDENCE	19,524
FILL MIDIGATION	-19,300
SWALE	- 594
AMOUNT REMAIN	+2033 CU FT

SITE LEGEND
PROPERTY LINE
SETBACK MINIMUM

AS-BUILT
02/19/2015

DAMMON ENGINEERING INC
Architects & Engineers

dammoneng@bellsouth.net
PHONE: 985-649-5832
FAX: 985-641-1959

CHIEF ENGINEER: BRIAN MISTICH, P.E.
CHIEF ARCHITECT: KEVIN KINCHEN
554 OLD SPANISH TRAIL
SLIDELL, LA 70458

The above plans and specifications, ideas and designs herein are the property of Dammon Engineering, Inc. and shall not be used for other projects, sold, or reproduced without the written consent of Dammon Engineering, Inc. Dimensions shall take precedence over scaled measurements. Contractor shall verify all dimensions and be responsible for same. Architect/Engineer shall be notified of any discrepancies before proceeding with work.

DUSTIN & RAVEN MAURER
35562 HOME ESTATE DRIVE
SLIDELL, LOUISIANA 70460

JOB No:	2214	DATE:	10-03-2014
DRAWN BY:	CKD	CHECKED BY:	DPD

REVISIONS

#	DESCRIPTION	DATE
	RELOCATED POND AND PAD	10-16-14

STATE OF LOUISIANA
BRIAN A. MISTICH
License No. 30187
PROFESSIONAL ENGINEER
2/18/2015

SITE PLAN

SHEET No: 01 OF 01

C1