


MOONRAKER DRIVE

(60' R/W)

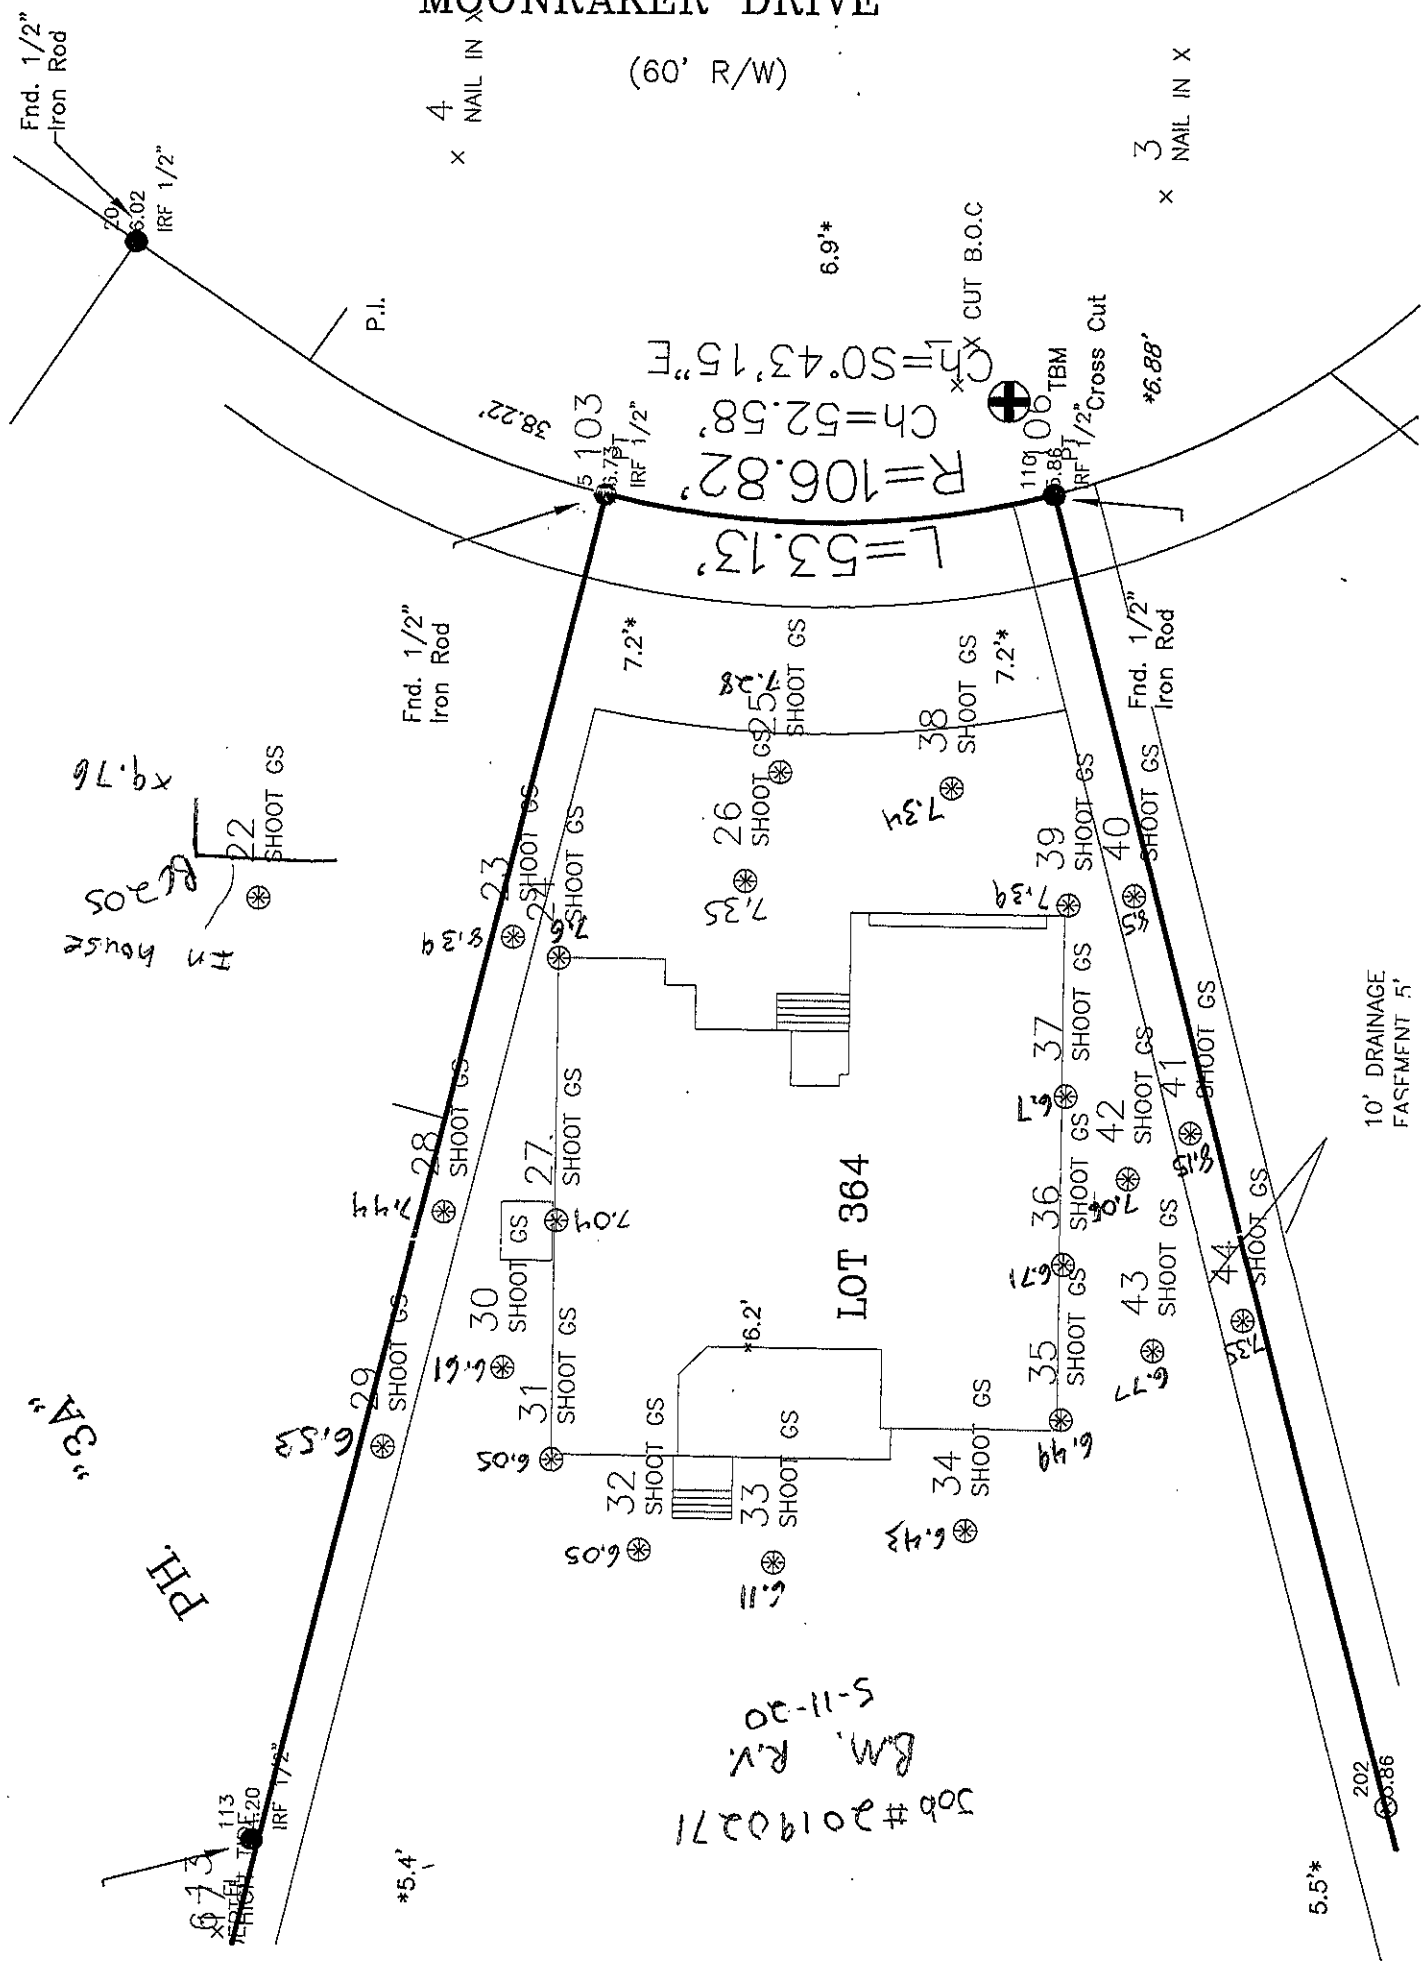

4 NAIL IN X

3 NAIL IN X

$R=106.82'$
 $L=53.13'$
 $Ch=52.58'$
 $Ch=50.43'15''E$

PH. 3A
In house
2205
x9.76

Job # 20190271
B.M. R.V. 5-11-20

10' DRAINAGE FASFMNT 5''

Fnd. 1/2" Iron Rod
IRF 1/2"

Fnd. 1/2" Iron Rod

Fnd. 1/2" Iron Rod

PH. 3A

LOT 364

5.5'

5.4'

6.9'

6.88'

113
IRF 1/2"

202
IRF 1/2"

P.I.

CUT B.O.C.

IRF 1/2" Cross Cut

29 SHOOT GS

28 SHOOT GS

35 SHOOT GS

34 SHOOT GS

33 SHOOT GS

32 SHOOT GS

31 SHOOT GS

30 SHOOT GS

36 SHOOT GS

35 SHOOT GS

37 SHOOT GS

38 SHOOT GS

