



1 GRAVEL DRIVEWAY SECTION
 NOTE: DRIVEWAY SECTION IS DIAGRAMATIC IN NATURE. LANDSCAPE OR CIVIL DESIGN SHALL TAKE PRIORITY.
 SCALE: 1/2" = 1'-0"

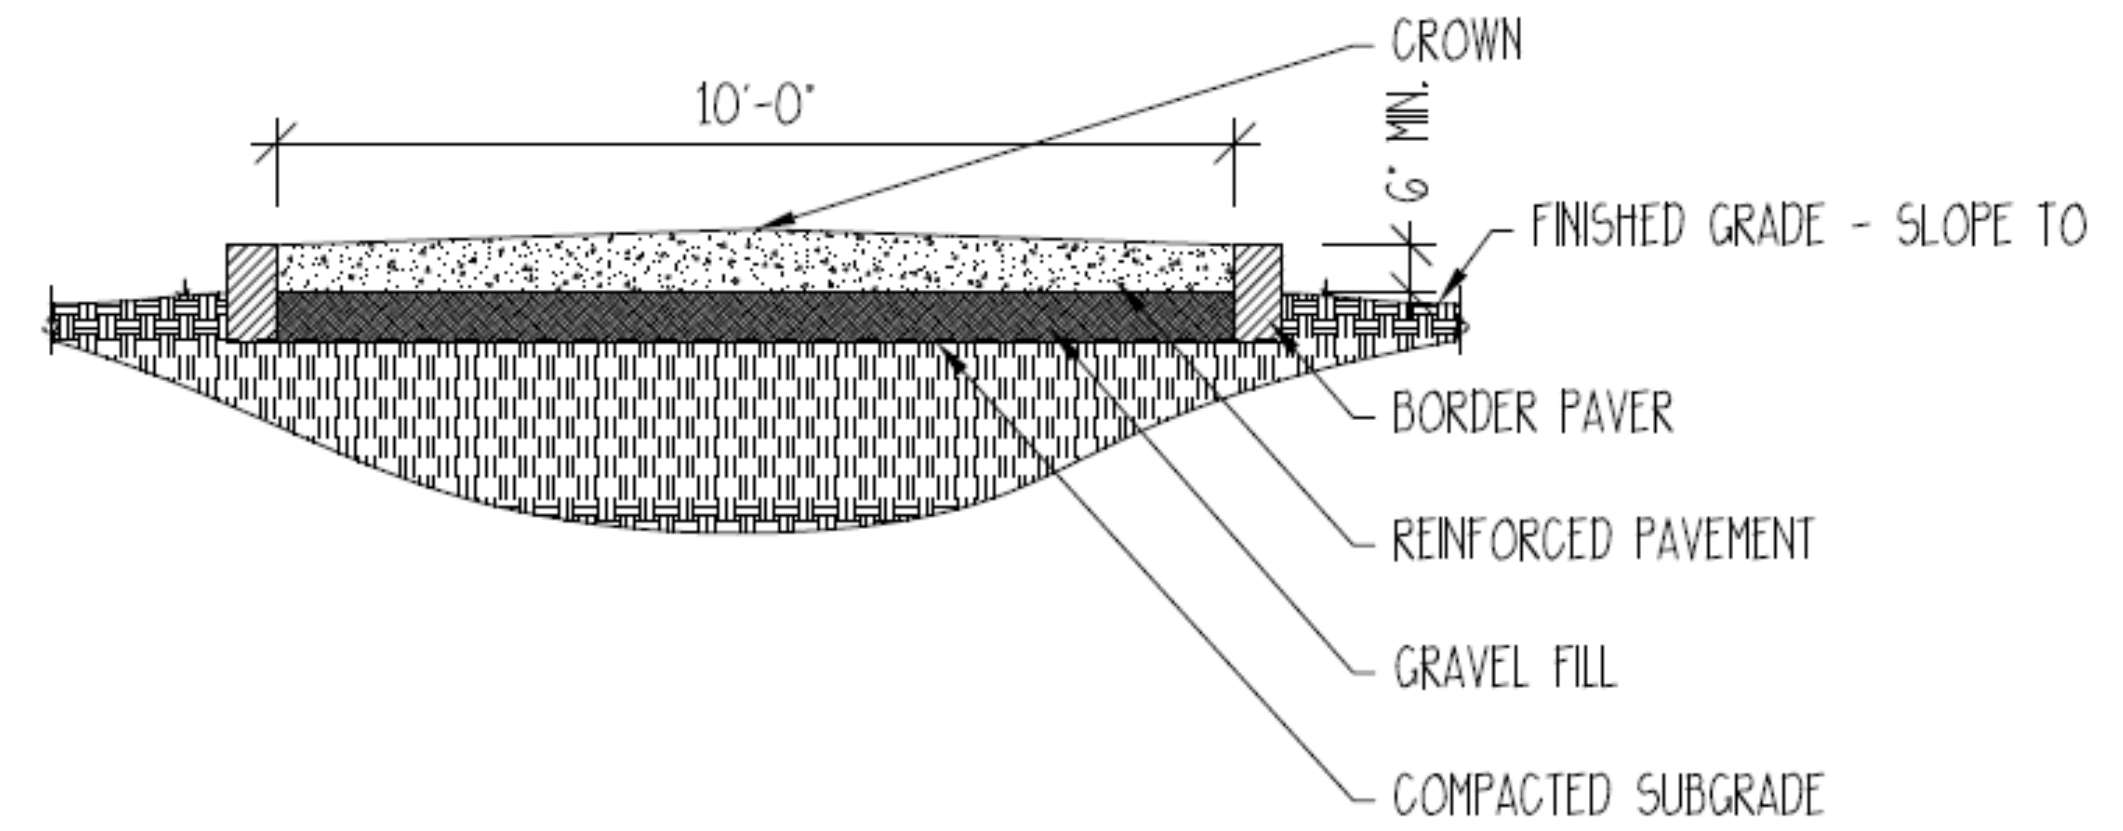

2 PAVED DRIVEWAY SECTION
 SCALE: 1/2" = 1'-0"

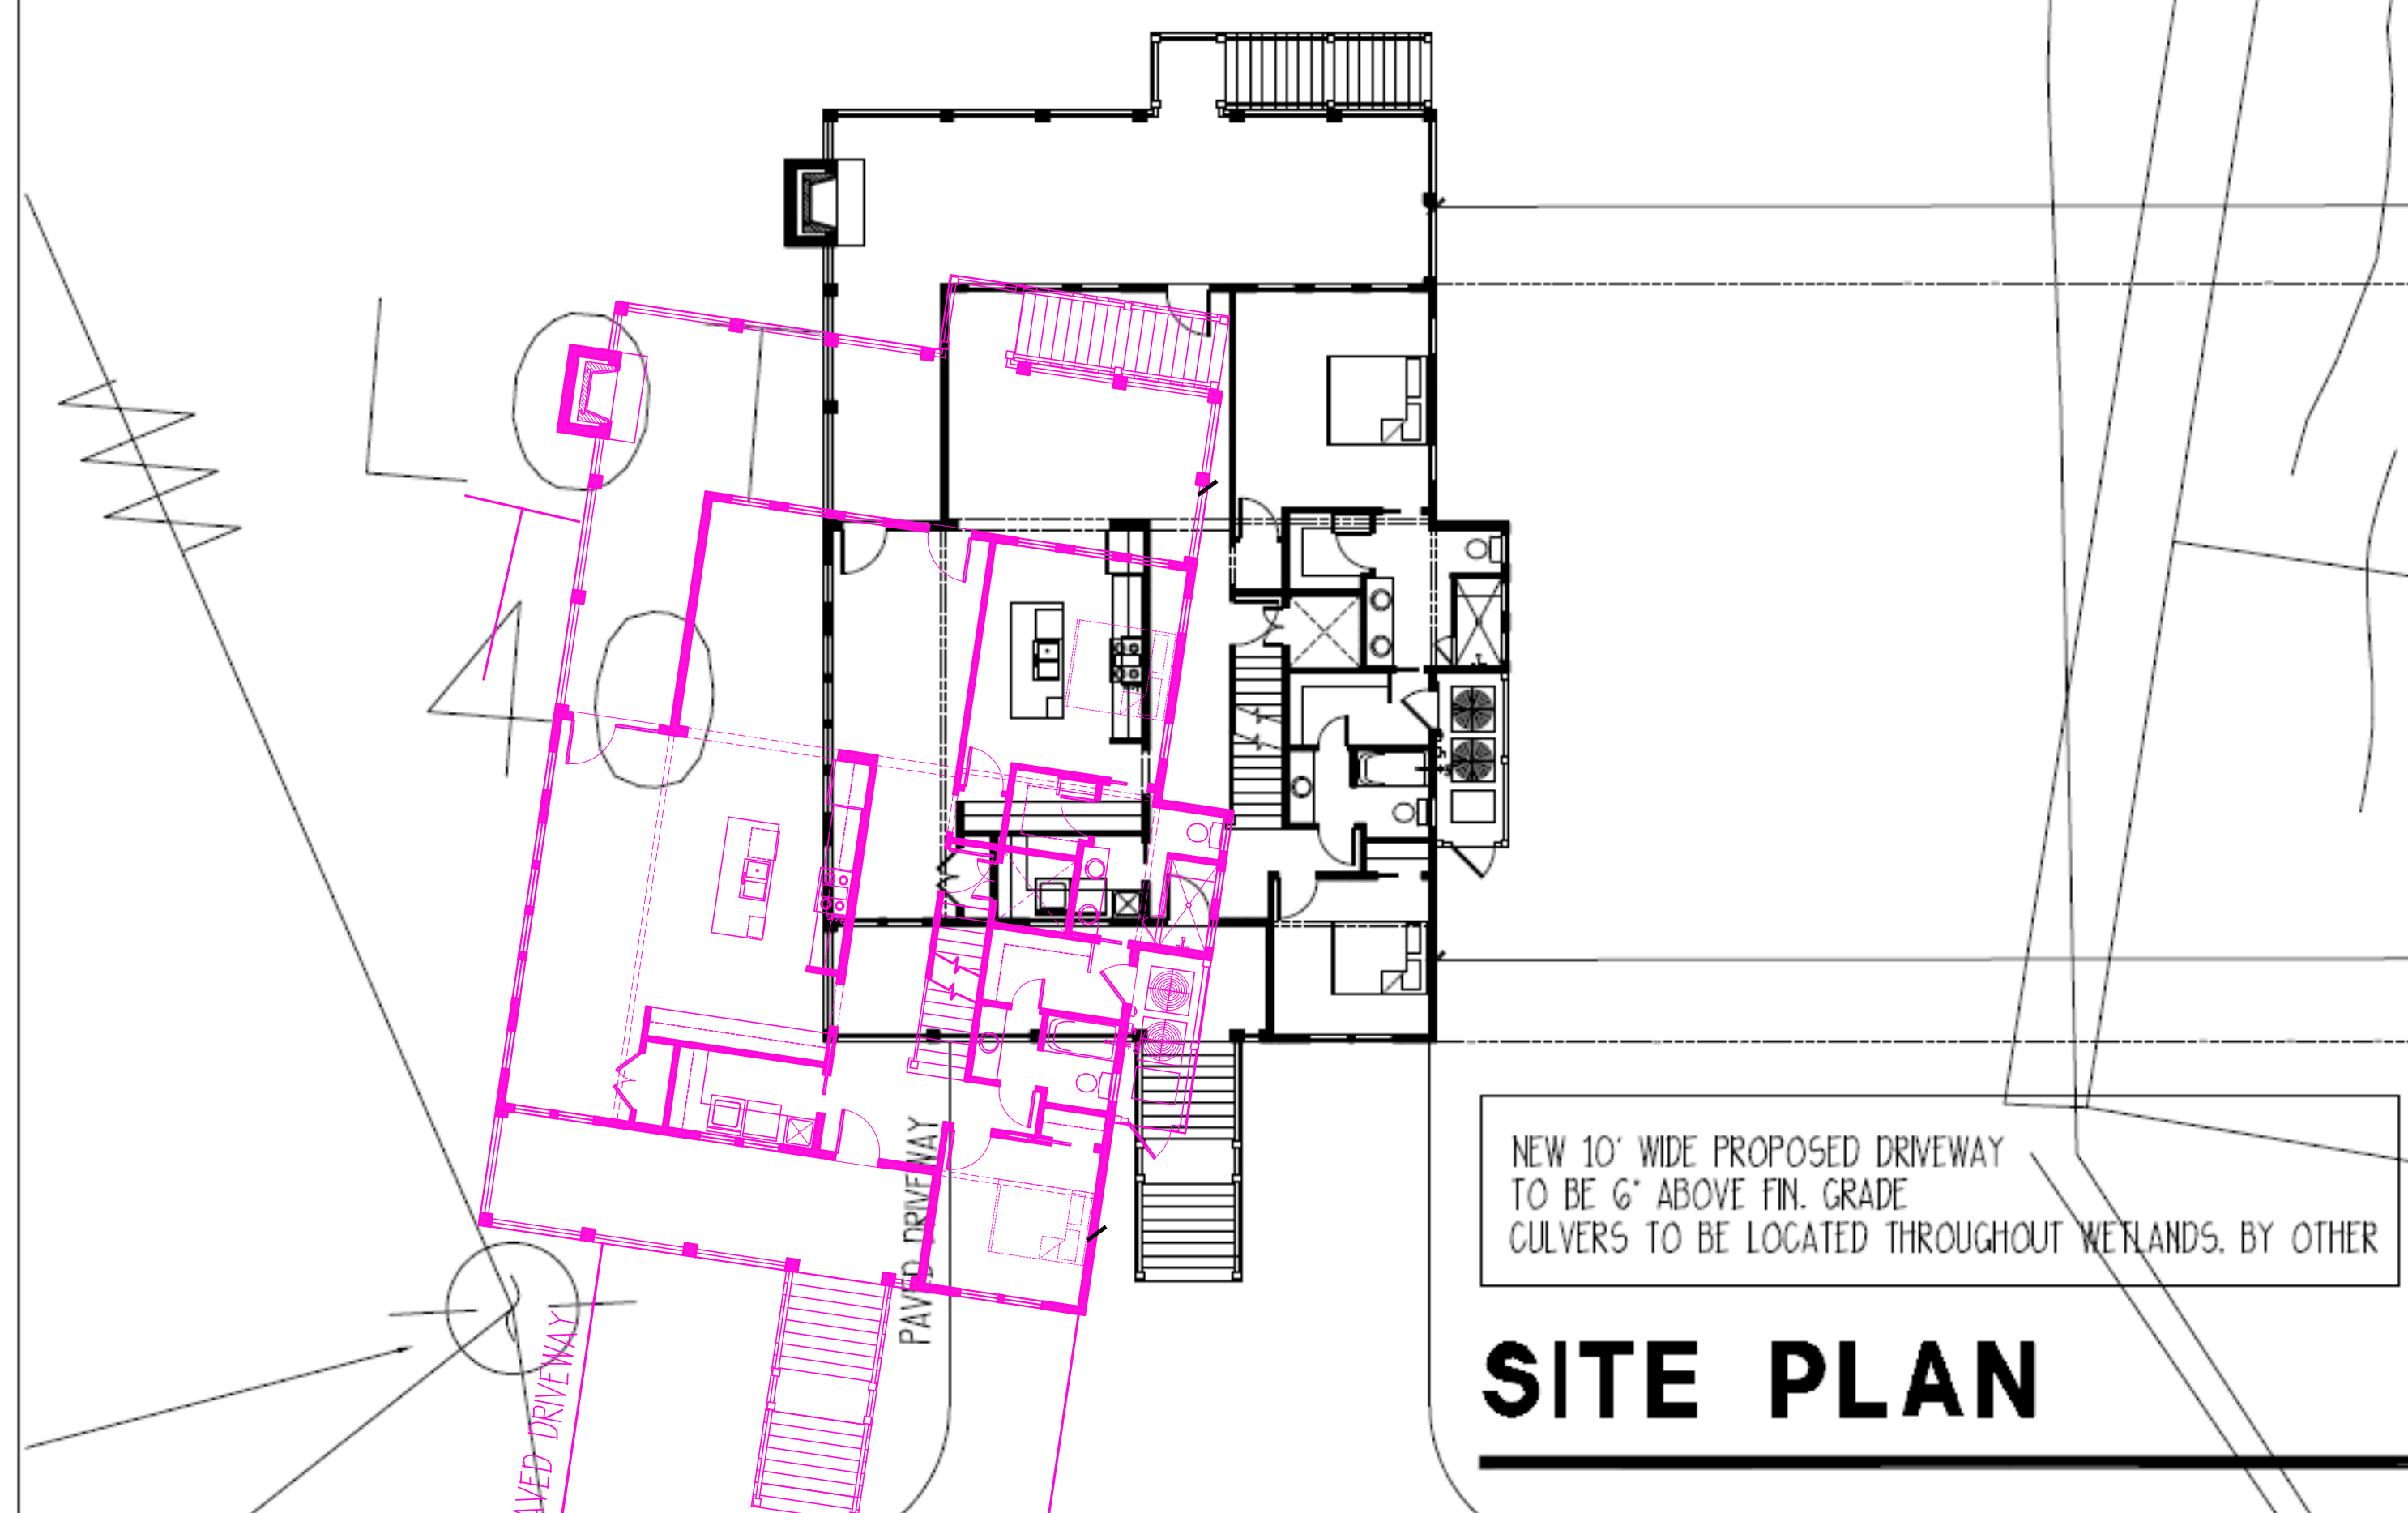

SITE PLAN

245.03

BOAT SLIP

383.03

N 42.01'

LOT 39

**NOTE: COORDINATE ALL WALKS, DRIVEWAY, PARKING, AND FENCES WITH LANDSCAPER
 **NOTE: CONTRACTOR TO VERIFY ALL PROPERTY LINES, SETBACKS, EASEMENTS, FEMA REQUIREMENTS, AND TREE SIZES AND LOCATIONS PRIOR TO CONSTRUCTION


SCALE: 3/32" = 1'-0"

BRINK RESIDENCE
 REUSE OF 19311 - ST. HELENA
 LOT 40B, 51. TAMMANY PARISH, LA

ALLISON RAMSEY ARCHITECTS
 Architects Inc. creating sustainable timeless design
 1003 Choctaw St.
 Baton Rouge, LA 70802
 (504) 984-4559
 www.allisonramseyarchitect.com

THE DATA AND INFORMATION ON THIS PLAN ARE THE PROPERTY OF ALLISON RAMSEY ARCHITECTS, INC. AND ARE TO BE USED ONLY FOR THE PROJECT AND SITE SPECIFICALLY IDENTIFIED HEREON. ANY REUSE OR REPRODUCTION OF THIS PLAN WITHOUT THE WRITTEN CONSENT OF ALLISON RAMSEY ARCHITECTS, INC. IS STRICTLY PROHIBITED. ALL INFORMATION IS TO BE VERIFIED BY THE USER. ALL INFORMATION IS TO BE VERIFIED BY THE USER. ALL INFORMATION IS TO BE VERIFIED BY THE USER.

DATE:	04/28/2021
JOB NO.:	20380
DATE: BY:	ER
DWG. NAME:	20380.DWG

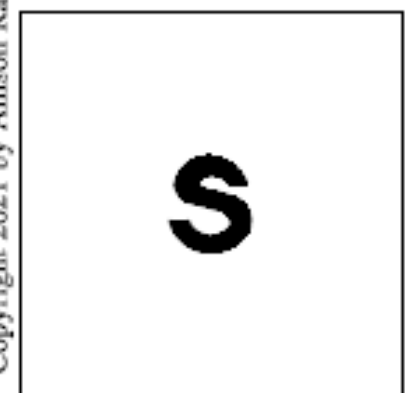

S

Copyright © 2021 by Allison Ramsey Architects, Inc. All rights reserved.