



# Plot Plan

LOTS 364, 366 AND THE SOUTH 1/2 OF LOT 362, THIRD WARD, CITY OF BAY ST. LOUIS, HANCOCK CO., MS

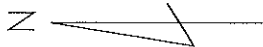

- NOTES:**
- All work shall be performed in accordance with all applicable national, state, and local codes, regulations, and ordinances.
  - It is the responsibility of the owner and/or general contractor to check all dimensions for the job before construction.
  - Contractor shall insure compatibility of the building with all site requirements.
  - Contractor shall be responsible for obtaining and securing all structural permits and conditions to meet all local codes and to insure a quality and safe structure.
  - Contractor shall be responsible for obtaining all necessary permits and shall be held responsible for the building and shall take preference over anything shown, including, but not limited to, any utility.

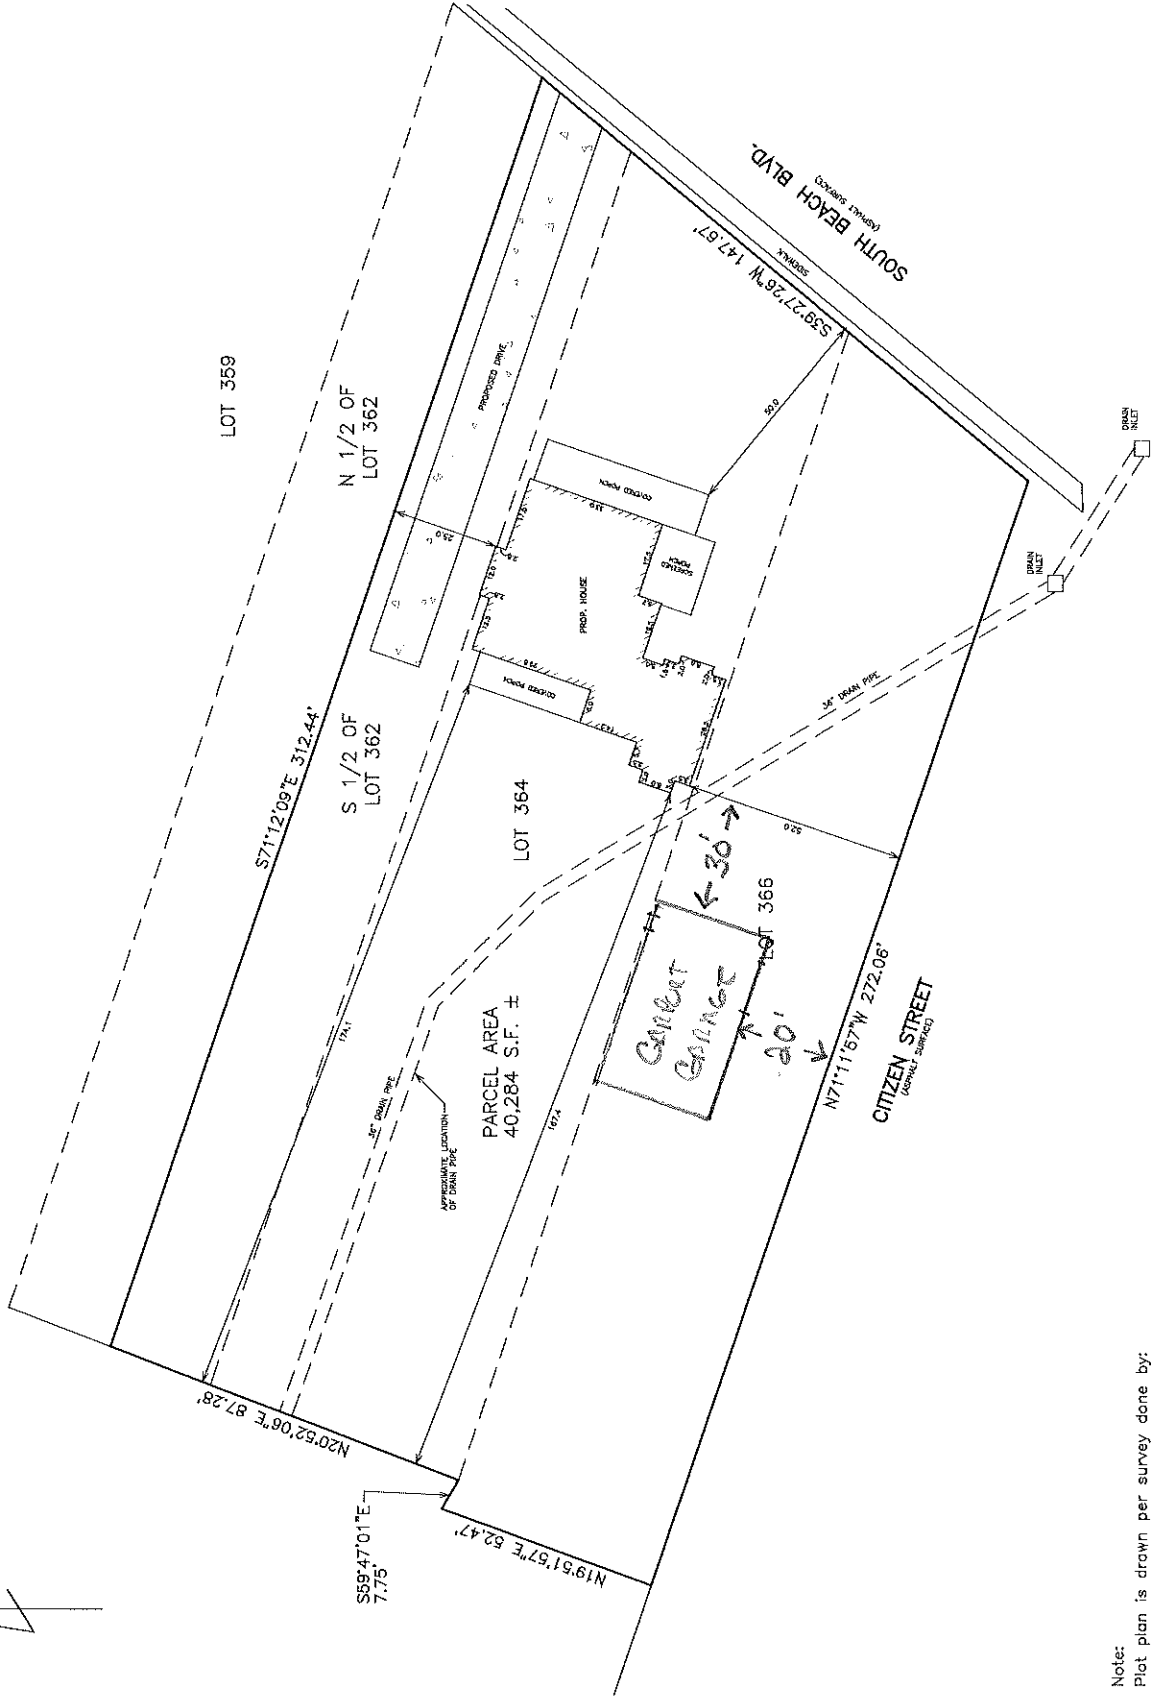

Note:  
 Plot plan is drawn per survey done by:  
 DUKE LEVY & ASSO., P.A., Dated: 3/18/2022,  
 DWG: W0# 2022-054

Scale: 1"=20'  
 W.O. #: 71222  
 Date: 07/12/22  
 Drawn by: TJP  
 Sheet: P

Prepared For:  
 Marty & Kelly Hopkins  
 612 South Beach Blvd.  
 Bay St. Louis, MS 39520

Techni-CAD Drafting Service  
 17121 Fenton-Dedaux Road  
 Kin, MS 39556  
 Ph: 228-326-4232 email: atoashomement@aol.com



Plot Plan