


CANAL

12'

120'

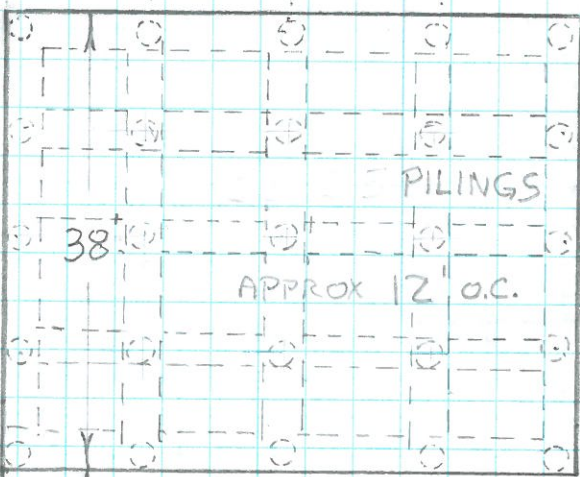

50'

LOT 63
(MUN. NO. 258)

LOT 64
(MUN. NO. 260)

10' EASMENT

60'
48'

