


(2) 1000S162-68 @ 6' doors
 (2) 1000S162-54 @ 3' doors

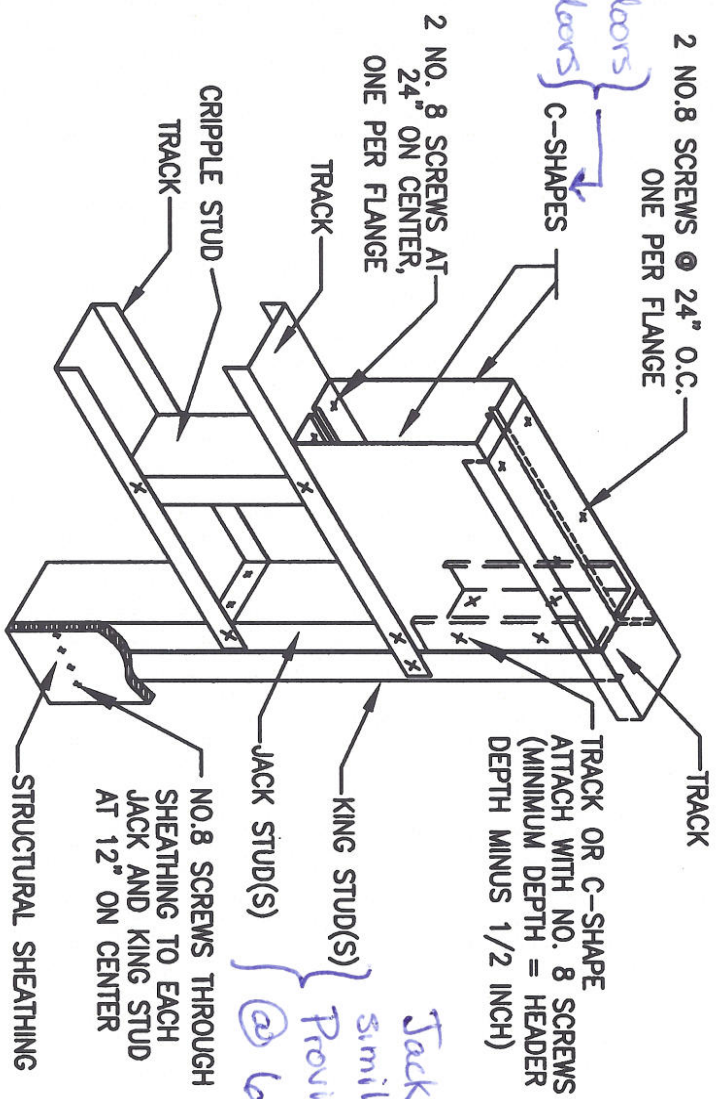

Jack and King studs similar to respective wall stud. Provide 2 King stud @ 6' door jamb.

Figure 6.10
 Box-Beam Header Detail