


ROOF PLAN - HVAC




1
M-04

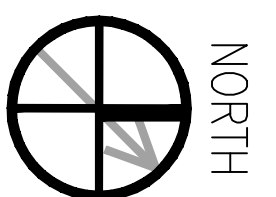

HUSEMAN & Associates
 ARCHITECTURAL & MECHANICAL PLUMBING ENGINEERING
 3925 N. H. D. SERVICE RD
 SUITE 2019, METairie, LA 70002
 Phone: (504) 456-3119
 Fax: (504) 456-3122
 Drawn By: RP
 Designed By: JL
 Checked By: GB

WALDEMAR S. NELSON AND COMPANY
 ENGINEERS AND ARCHITECTS
 1200 ST. CHARLES AVE
 NEW ORLEANS, LA

RECORD DRAWING DATE: 08/22/08
 CODE ID NO.: D
 DRAWING SIZE: D
 SPEC. NO./OR: -
 CONSTR. CONTR. NO.: -
 NAVFAC DRAWING NO.: 1000277
 SHEET: 8 OF 15
 M-04

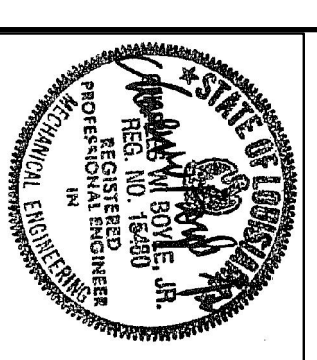

NAVFAC
 Naval Facilities Engineering Command
 Southeast Division, Jacksonville, FL

NAS JRB New Orleans Belle Chase, Louisiana
NAVAIRSEFAC CALIBRATION BLDG.
 HVAC ROOF PLAN
 APPROVED DATE: AUGUST 22, 2008 EPD FOR COMMANDER, NAVFAC

DRAWING REVISIONS				
REV.	DESCRIPTION	PREP BY	DATE	APPRD.
0	FINAL DESIGN	RP	10/29/08	CB

BROADMOOR
 BUILDING by DESIGN
 BROADMOOR, L.L.C.
 2740 North Amoult Road
 Metairie, Louisiana 70002
 www.broadmoorllc.com