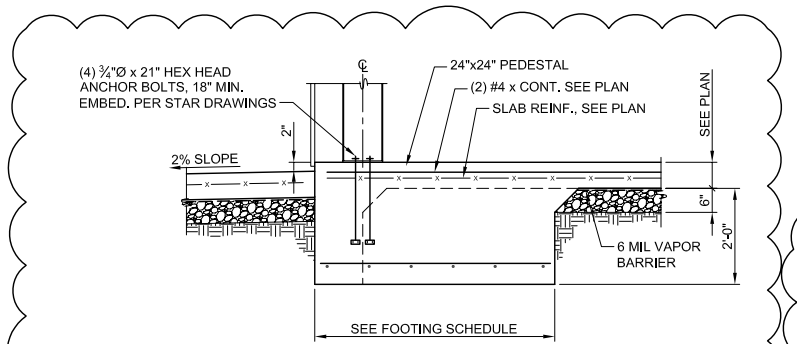

FOOTING SCHEDULE				
TYPE	LENGTH	WIDTH	DEPTH	REINF.
F1	8'-0"	6'-0"	2'-0"	(6) #5 EW, BOT
F2	9'-0"	9'-0"	2'-0"	(7) #5 EW, BOT
F3	5'-0"	5'-0"	2'-0"	(6) #5 EW, BOT
F4	4'-0"	4'-0"	2'-0"	(5) #5 EW, BOT

FOOTING SCHEDULE — 1 / -
SCALE: 1/2" = 1'-0"

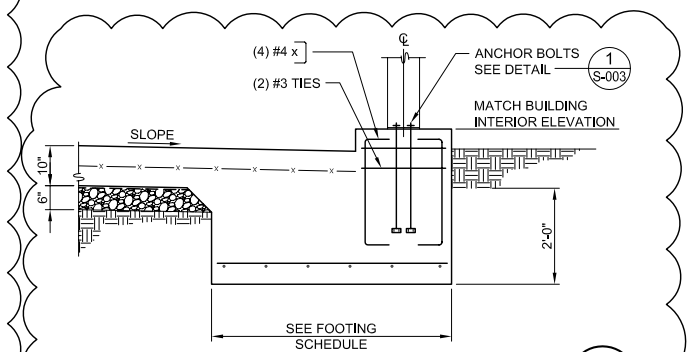

PEDESTAL — 2 / -
SCALE: 1/2" = 1'-0"

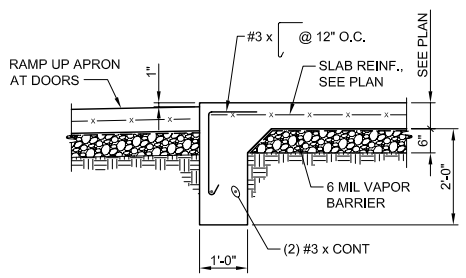

EDGE AT DOORWAYS — 3 / -
SCALE: 1/2" = 1'-0"

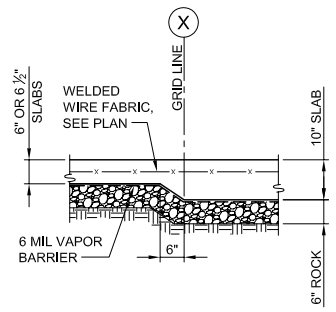

SLAB TRANSITION — 4 / -
SCALE: 1/2" = 1'-0"

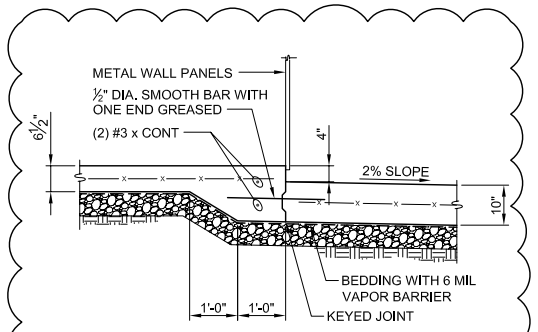

STEP AT OPEN BAYS — 5 / S-003
SCALE: 1/2" = 1'-0"

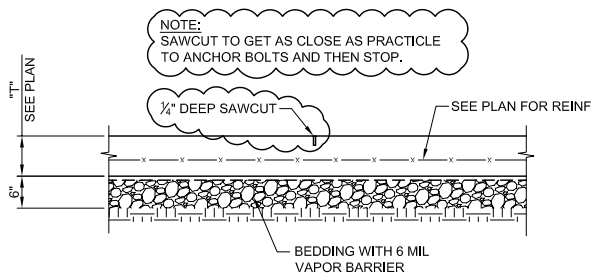

CONSTRUCTION / CONTRACTION JOINTS — 6 / -
SCALE: 1" = 1'-0"

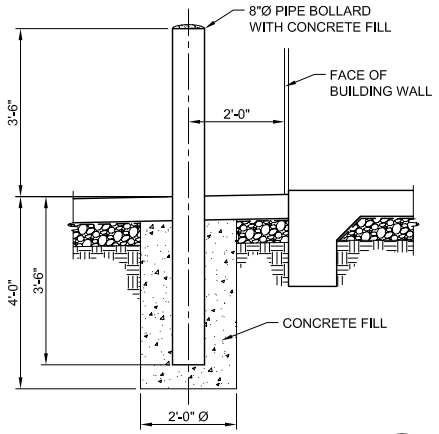

BOLLARD — 7 / -
SCALE: 1/2" = 1'-0"

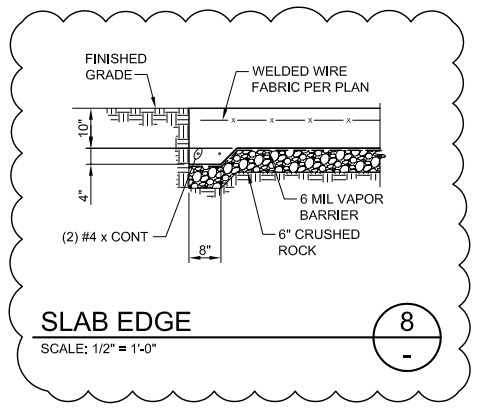

SLAB EDGE — 8 / -
SCALE: 1/2" = 1'-0"

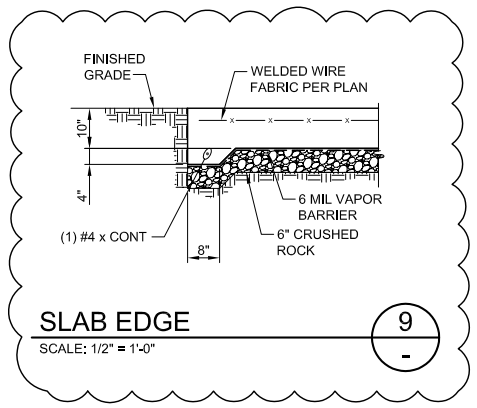

SLAB EDGE — 9 / -
SCALE: 1/2" = 1'-0"

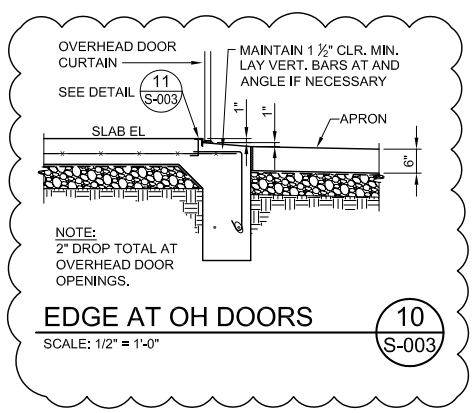

EDGE AT OH DOORS — 10 / S-003
SCALE: 1/2" = 1'-0"

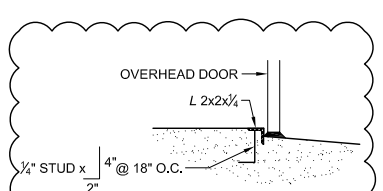

DETAIL — 11 / -
SCALE: 1" = 1'-0"

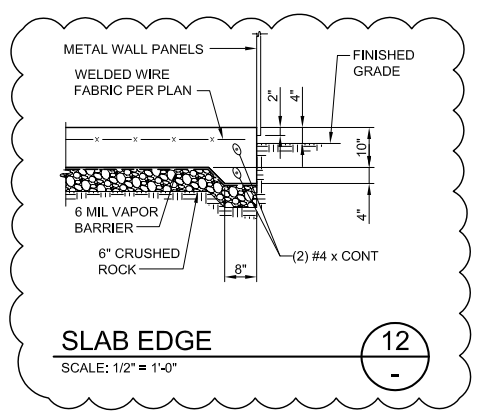

SLAB EDGE — 12 / -
SCALE: 1/2" = 1'-0"

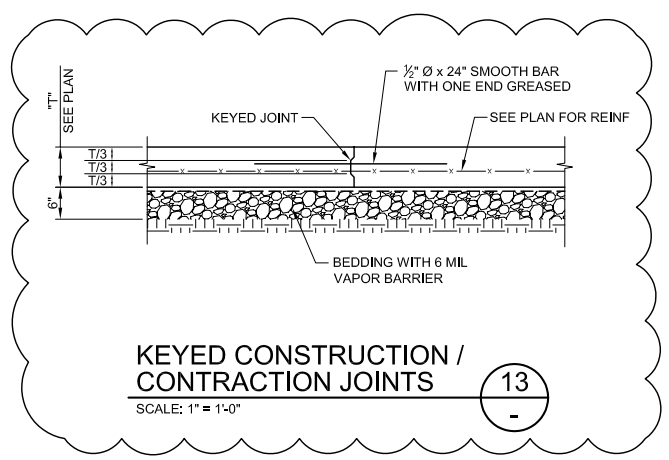

KEYED CONSTRUCTION / CONTRACTION JOINTS — 13 / -
SCALE: 1" = 1'-0"

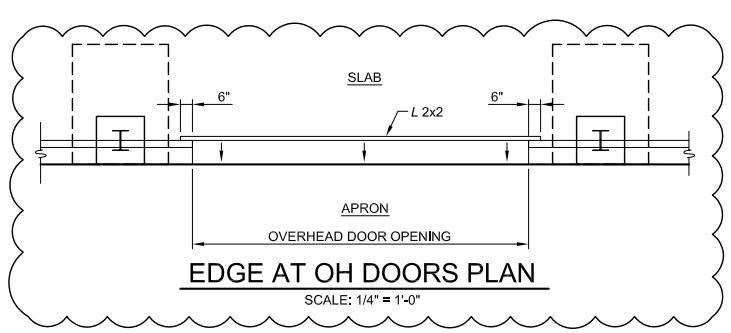

EDGE AT OH DOORS PLAN
SCALE: 1/4" = 1'-0"

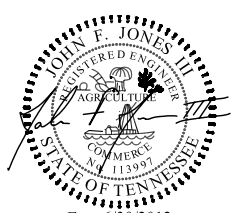

Exp. 6/30/2012

CASEY CIVIL
Casey Civil, LLC
1080 Old Spanish Trail, Suite 8
Slidell, LA 70458

JF Jones Company
Consulting Engineers
San Rafael, CA 94901

UNITED STATES DEPARTMENT OF THE INTERIOR
U.S. FISH AND WILDLIFE SERVICE
DIVISION OF ENGINEERING
CHICKASAW NATIONAL WILDLIFE REFUGE
RIPLEY TENNESSEE

NEW MAINTENANCE SHOP
STRUCTURAL DETAILS

DESIGN: JFJ	DRAWN: AVC	CHECK: JFJ	
DRAWING FILENAME AND NUMBER: dwgname DWGNO		DATE: JULY 30th, 2010	
		SHT. NO. S-003	SEQ. NO. 14 OF 26