

DAMMON
ENGINEERING, INC.

CHIEF ENGINEER
EMMETT
DAMMON, P.E.
CHIEF ARCHITECT
ROBERT
WILTSE

554 OLD SPANISH TRAIL
SUITE L, LA 70458
OFFICE: 985-649-5832
FAX: 985-641-5950

WWW.DAMMONENGINEERING.COM
EMAIL:
DAMMONENG@BLSOUTH.NET

ARCHITECTURE
ENGINEERING
STUDIES
PLANNING
INVESTIGATION
EXPERT WITNESS


**PARK DRIVE
IMPROVEMENTS**

INTERSECTION OF
PARK DR. AND
MIDDLE DRIVE
SUDELL, LA
70458

**PAVING
PLAN**

REV:	
SCALE:	AS NOTED
JOB#:	2115
DATE:	06-06-11
SHEET	




C-1

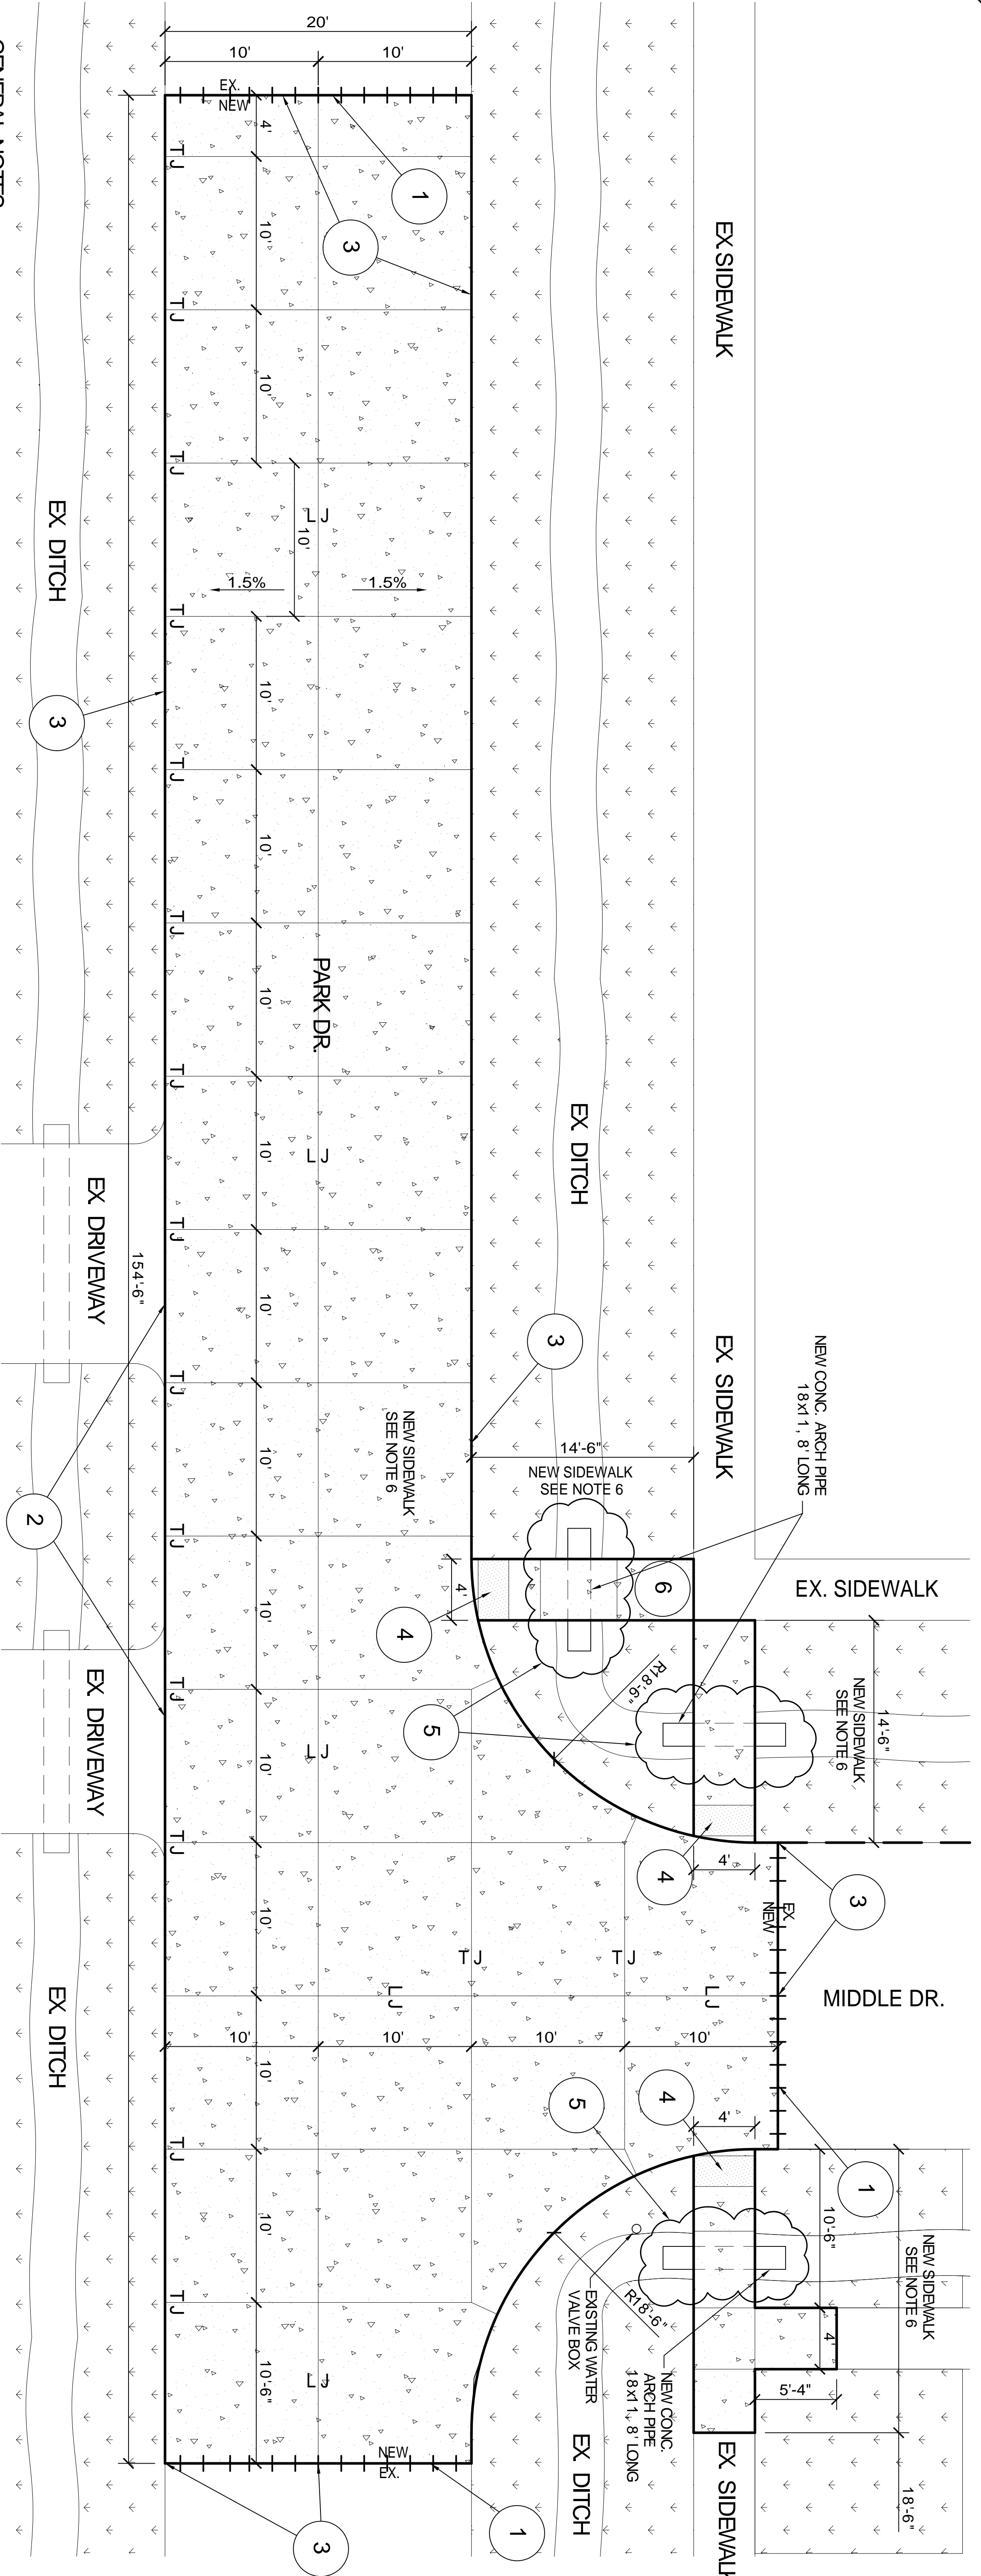

SCOPE OF WORK
DEMOLITION, REMOVAL AND REPLACEMENT OF APPROX. 93.1 CUBIC YARDS OF EXISTING CONCRETE STREET, SIDEWALKS AND CURBS TO IMPROVE SAFETY AND FUNCTIONALITY OF THE STREETS.

TOTAL CONCRETE AREA = 3708 SQ.FT.
TOTAL CONCRETE VOLUME = 93.1 CU.YD.

PAVING PLAN
SCALE 3/16" = 1'-0"

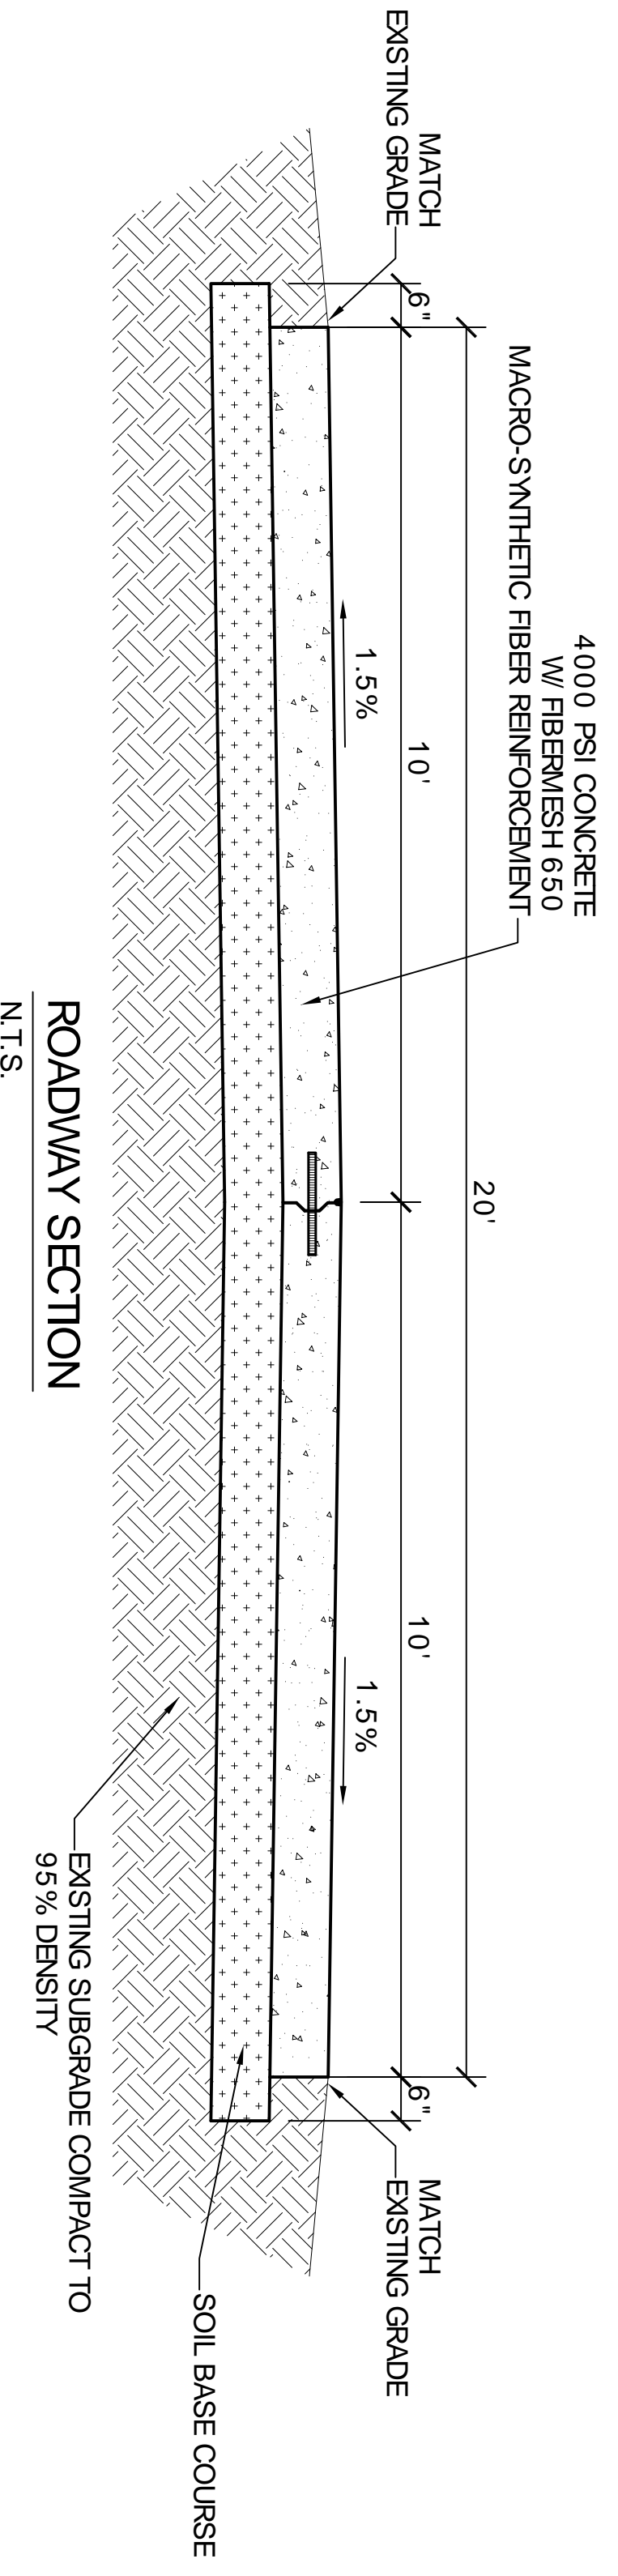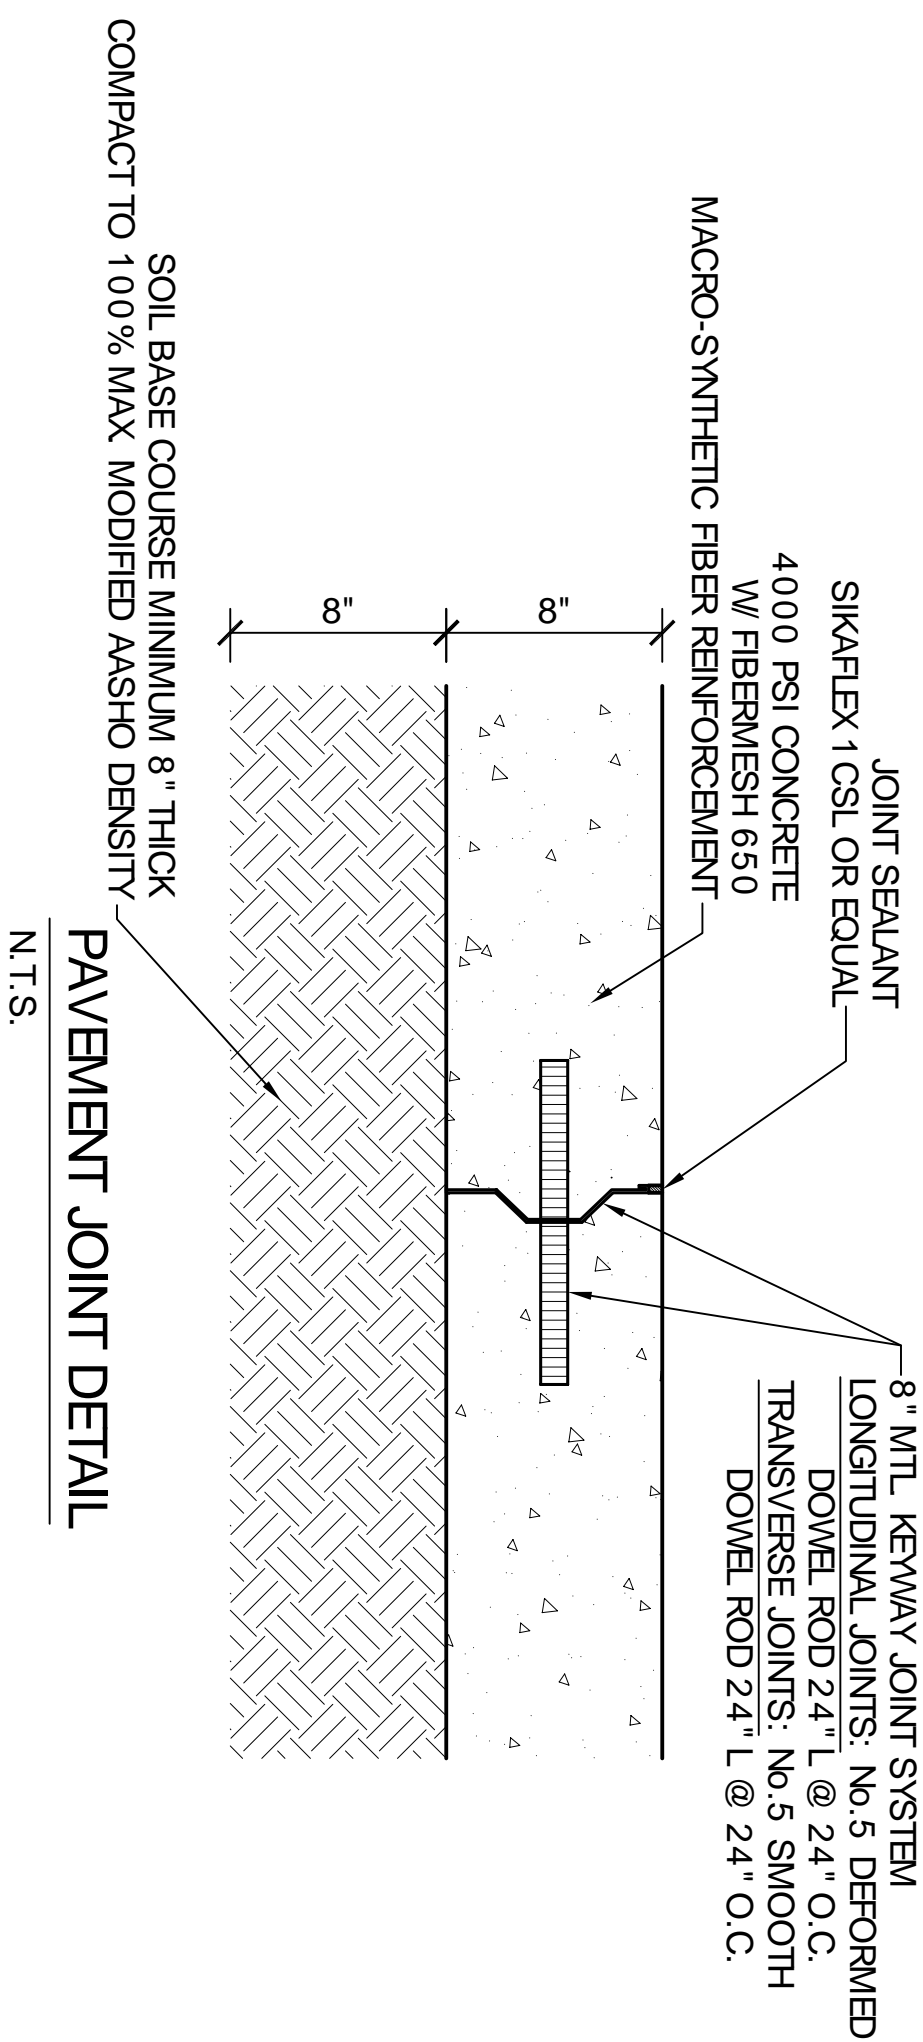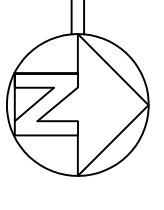

- GENERAL NOTES:**
- 1) ALL NEW CONCRETE SHALL HAVE A MINIMUM COMPRESSIVE STRENGTH OF 4,000 PSI AT 28 DAYS AND A MINIMUM THICKNESS OF 8". CONCRETE MIX SHALL BE IN ACCORDANCE WITH THE LATEST REVISION OF ASTM C-150 TYPE 1.
 - 2) CONCRETE MIX TO INCLUDE SYNTHETIC FIBER REINFORCING IN ACCORDANCE WITH ASTM C-1399. MACRO SYNTHETIC FIBERS SHALL PROVIDE A MIN. AVERAGE RESIDUAL STRENGTH OF 162 PSI @ 3LB. PER CUBIC YARD. AND 216 PSI @ 4LB. PER CUBIC YARD.
 - 3) ALL REINFORCING STEEL SHALL MEET ASTM-A615 (GRADE 60)
 - 4) ALL REINFORCING STEEL SHALL BE SECURELY SUPPORTED TO PREVENT BOTH VERTICAL AND HORIZONTAL MOVEMENT DURING CONCRETE PLACEMENT. ALL CONTROL AND EXPANSION JOINTS SHALL BE LOCATED AND INSTALLED AS SHOWN ON THE PAVING PLAN AND IN ACCORDANCE WITH THE MANUFACTURER'S RECOMMENDATIONS.
 - 5) IT IS RECOMMENDED THAT THE SERVICES OF A GEOTECHNICAL ENGINEER BE OBTAINED TO DETERMINE THE CONDITION OF THE EXISTING SUBGRADE MATERIAL AND TO OBSERVE THE PROOFROLLING OF ANY BASE MATERIAL.
 - 6) ALL SUB GRADE FILL SHALL BE SELECT GRANULAR MATERIAL COMPACTED TO 100% MAX. MODIFIED ASHO DENSITY IN A MAXIMUM OF 6" LIFTS.
 - 7) CONTRACTOR SHALL CONTACT THEIR REGULATORY DEPARTMENT OF ENGINEERING PRIOR TO CONDUCTING ANY WORK.
 - 8) ANY WORK WITHIN THE ROADWAY OR ADJACENT TO THE ROADWAY CAUSING AN INTERFERENCE TO VEHICULAR TRAFFIC REQUIRES PRIOR APPROVAL FROM THE CITY TRAFFIC ENGINEERING DIVISION, AND MUST CONFORM TO THE REQUIREMENTS SET FORTH BY THE UNIFORM MANUAL OF TRAFFIC CONTROL DEVICES OF THE STATE OF LOUISIANA. THE CONTRACTOR MUST FURNISH ALL NECESSARY TRAFFIC SIGNS AND/OR BARRICADES AND MAINTAIN THEM DURING CONSTRUCTION ACTIVITY.

- SPECIFIC NOTES:**
- 1) WHERE NEW CONCRETE ABUTTS EXISTING ROAD, STRIP ANY EXISTING JOINT MATERIAL AND DOWEL INTO EXISTING PAVEMENT W/ NO. 5 SMOOTH ROD @ 18" O.C. DRILL 3/4" Ø HOLE. FILL WITH GROUT AND INSERT DOWEL IN A MANNER AS TO ENSURE THAT NO VOIDS EXIST
 - 2) WHERE NEW CONCRETE ABUTTS EXISTING DRIVEWAY OR SIDEWALK PROVIDE COLD JOINT.
 - 3) ELEVATION OF NEW CONCRETE AT CROWN AND EDGE OF ROAD SHALL MATCH THE EXISTING CONCRETE ELEVATIONS AND ACCOMMODATE EXISTING DRAINAGE PATTERN
 - 4) TRUNCATED DOME DETECTABLE WARNING SYSTEM MINIMUM 2 1/4" x 8" SHALL BE PROVIDED EVERYWHERE SIDEWALKS TRANSITION TO STREETS.
 - 5) EXCAVATE AND DISPOSE OF EXISTING CONCRETE 15" Ø PIPE. PROVIDE NEW 18x11 CONCRETE ARCH TYPE DRAIN PIPE WITH INVERTS MATCHING EXISTING ELEVATION. PROVIDE A MINIMUM PIPE BEDDING OF 6" THICK HIGH PLASTICITY INDEX (PI) FILL. BACKFILL NEW CULVERT WITH SIMILAR MATERIAL IN A MANNER TO MINIMIZE EROSION AND PROVIDE COMPACTED BASE COURSE FOR NEW SIDEWALK ABOVE.
 - 6) DEMO AND REMOVE PORTION OF EXISTING SIDEWALK AS SHOWN. INSTALL NEW 4" THICK SIDEWALK AS SHOWN WITH CONCRETE MIX SIMILAR TO STREET MIX. PROVIDE 3/4" DEEP SCORE JOINT WITH SIDEWALK TOOL @ 5' O.C. ELEVATION ON NEW SIDEWALK SHALL MATCH THE ADJOINING SIDEWALK ELEVATION AND SLOPE UNIFORMLY TO ADJACENT STREET ELEVATION NOT TO EXCEED 1:2.1 SLOPE.