


THIS FOOTING
VARIES FROM 15" TO 16"

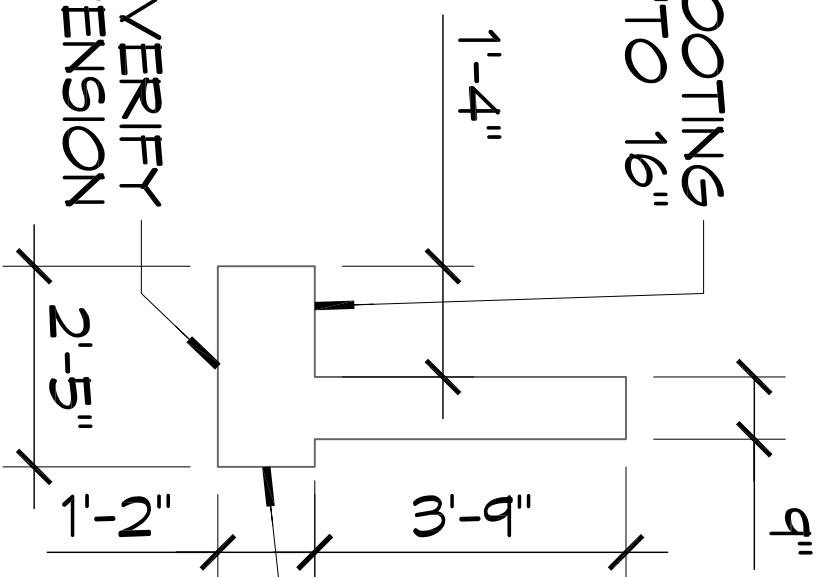

COULD NOT VERIFY
THIS DIMENSION

THIS DIMENSION VARIES
FROM 14" TO 15"