

SECTION 4.02 DESIGN STANDARDS

A. The following minimum design standards shall be observed in laying out off-street parking facilities:

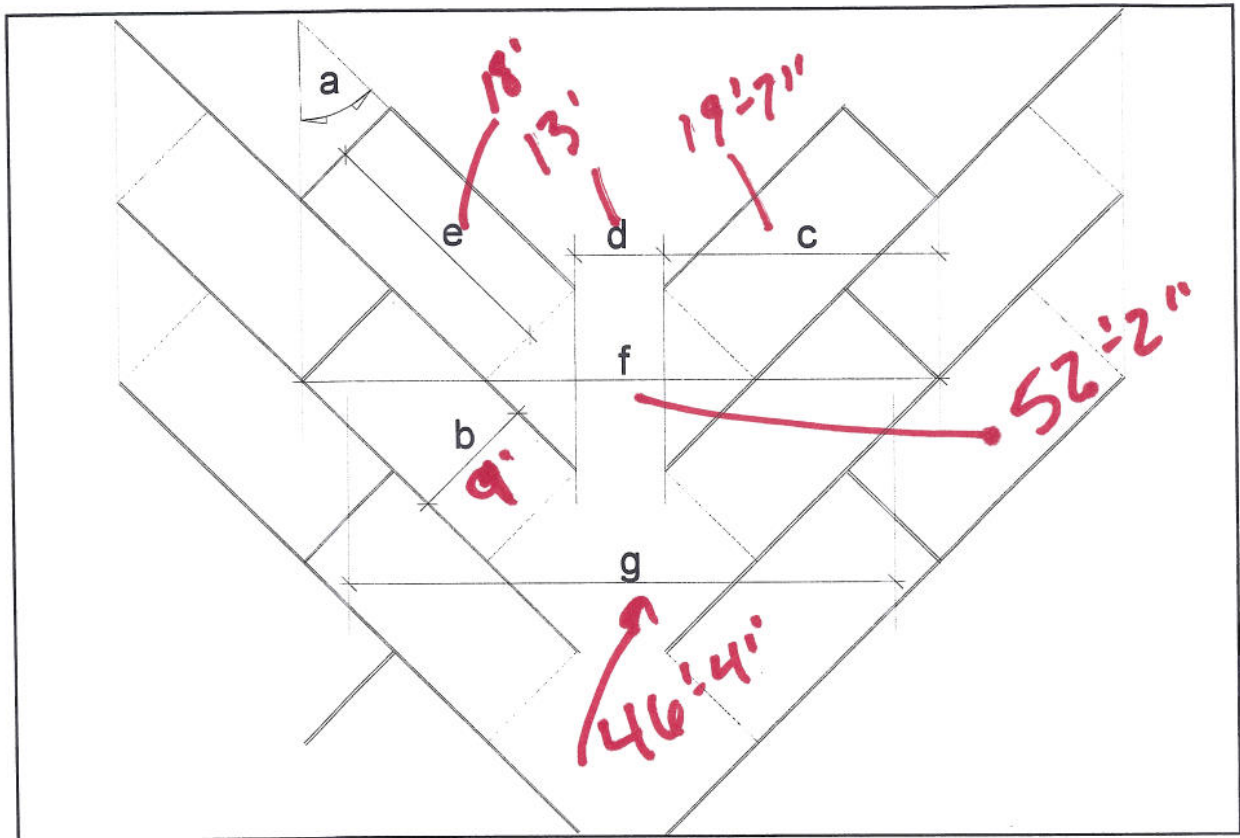


Figure 4-1 - Off-Street Parking Facility Design Standards

a PARKING ANGLE	b STALL WIDTH	c ISLE TO CURB	d AISLE WIDTH	e STALL LENGTH	f CURB TO CURB	g OVERLAP TO CURB
0°-15°	9 feet	9 ft.	12 ft	23 ft	30'/38'6"	0'/30'0"
16°-37°	9 feet	16'9"	11 ft	18 ft	44'6"	36'8"
✓ 38°-57°	<u>9 feet</u>	<u>19'7"</u>	<u>13 ft</u>	<u>18 ft</u>	<u>52'2"</u>	<u>46'4"</u>
58°-74°	9 feet	20'0"	18 ft	18 ft	58'	55'0"
75°-90°	9 feet	18'0"	22 ft	18 ft	58'	58'0"

B. Off-street parking facilities shall be drained to eliminate standing water and