


\$15. SQ YD. TOP REMOVED
\$115 SQ. YD. NEW CONCRETE

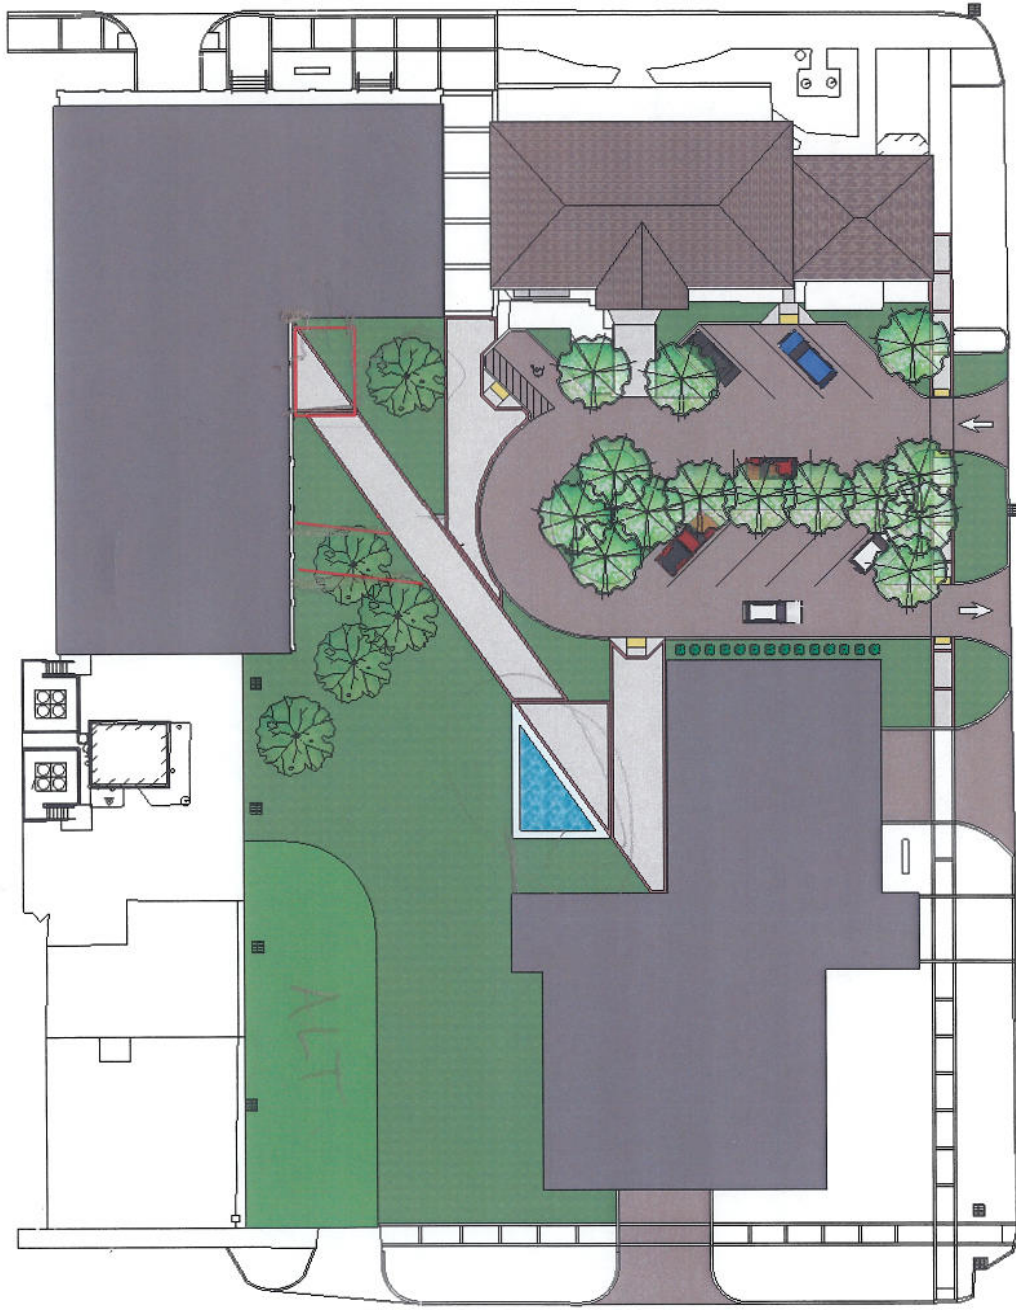

Overall Plan View
 Scale: 1" = 50'