


T.C. = 7.18'
 X 7.48
 X 7.39
 X 7.56
 = 7.49'
 = 6.24'
 = 6.33'
 = 7.63'
 = 7.83'
 = 6.53'
 #3 EL. = 7.44'

is it really here
 T.C. = 7.0
 INV. = 4.09

T.C. = 5.42'
 INV. = 7.32'

#8 EL. = 7.41'

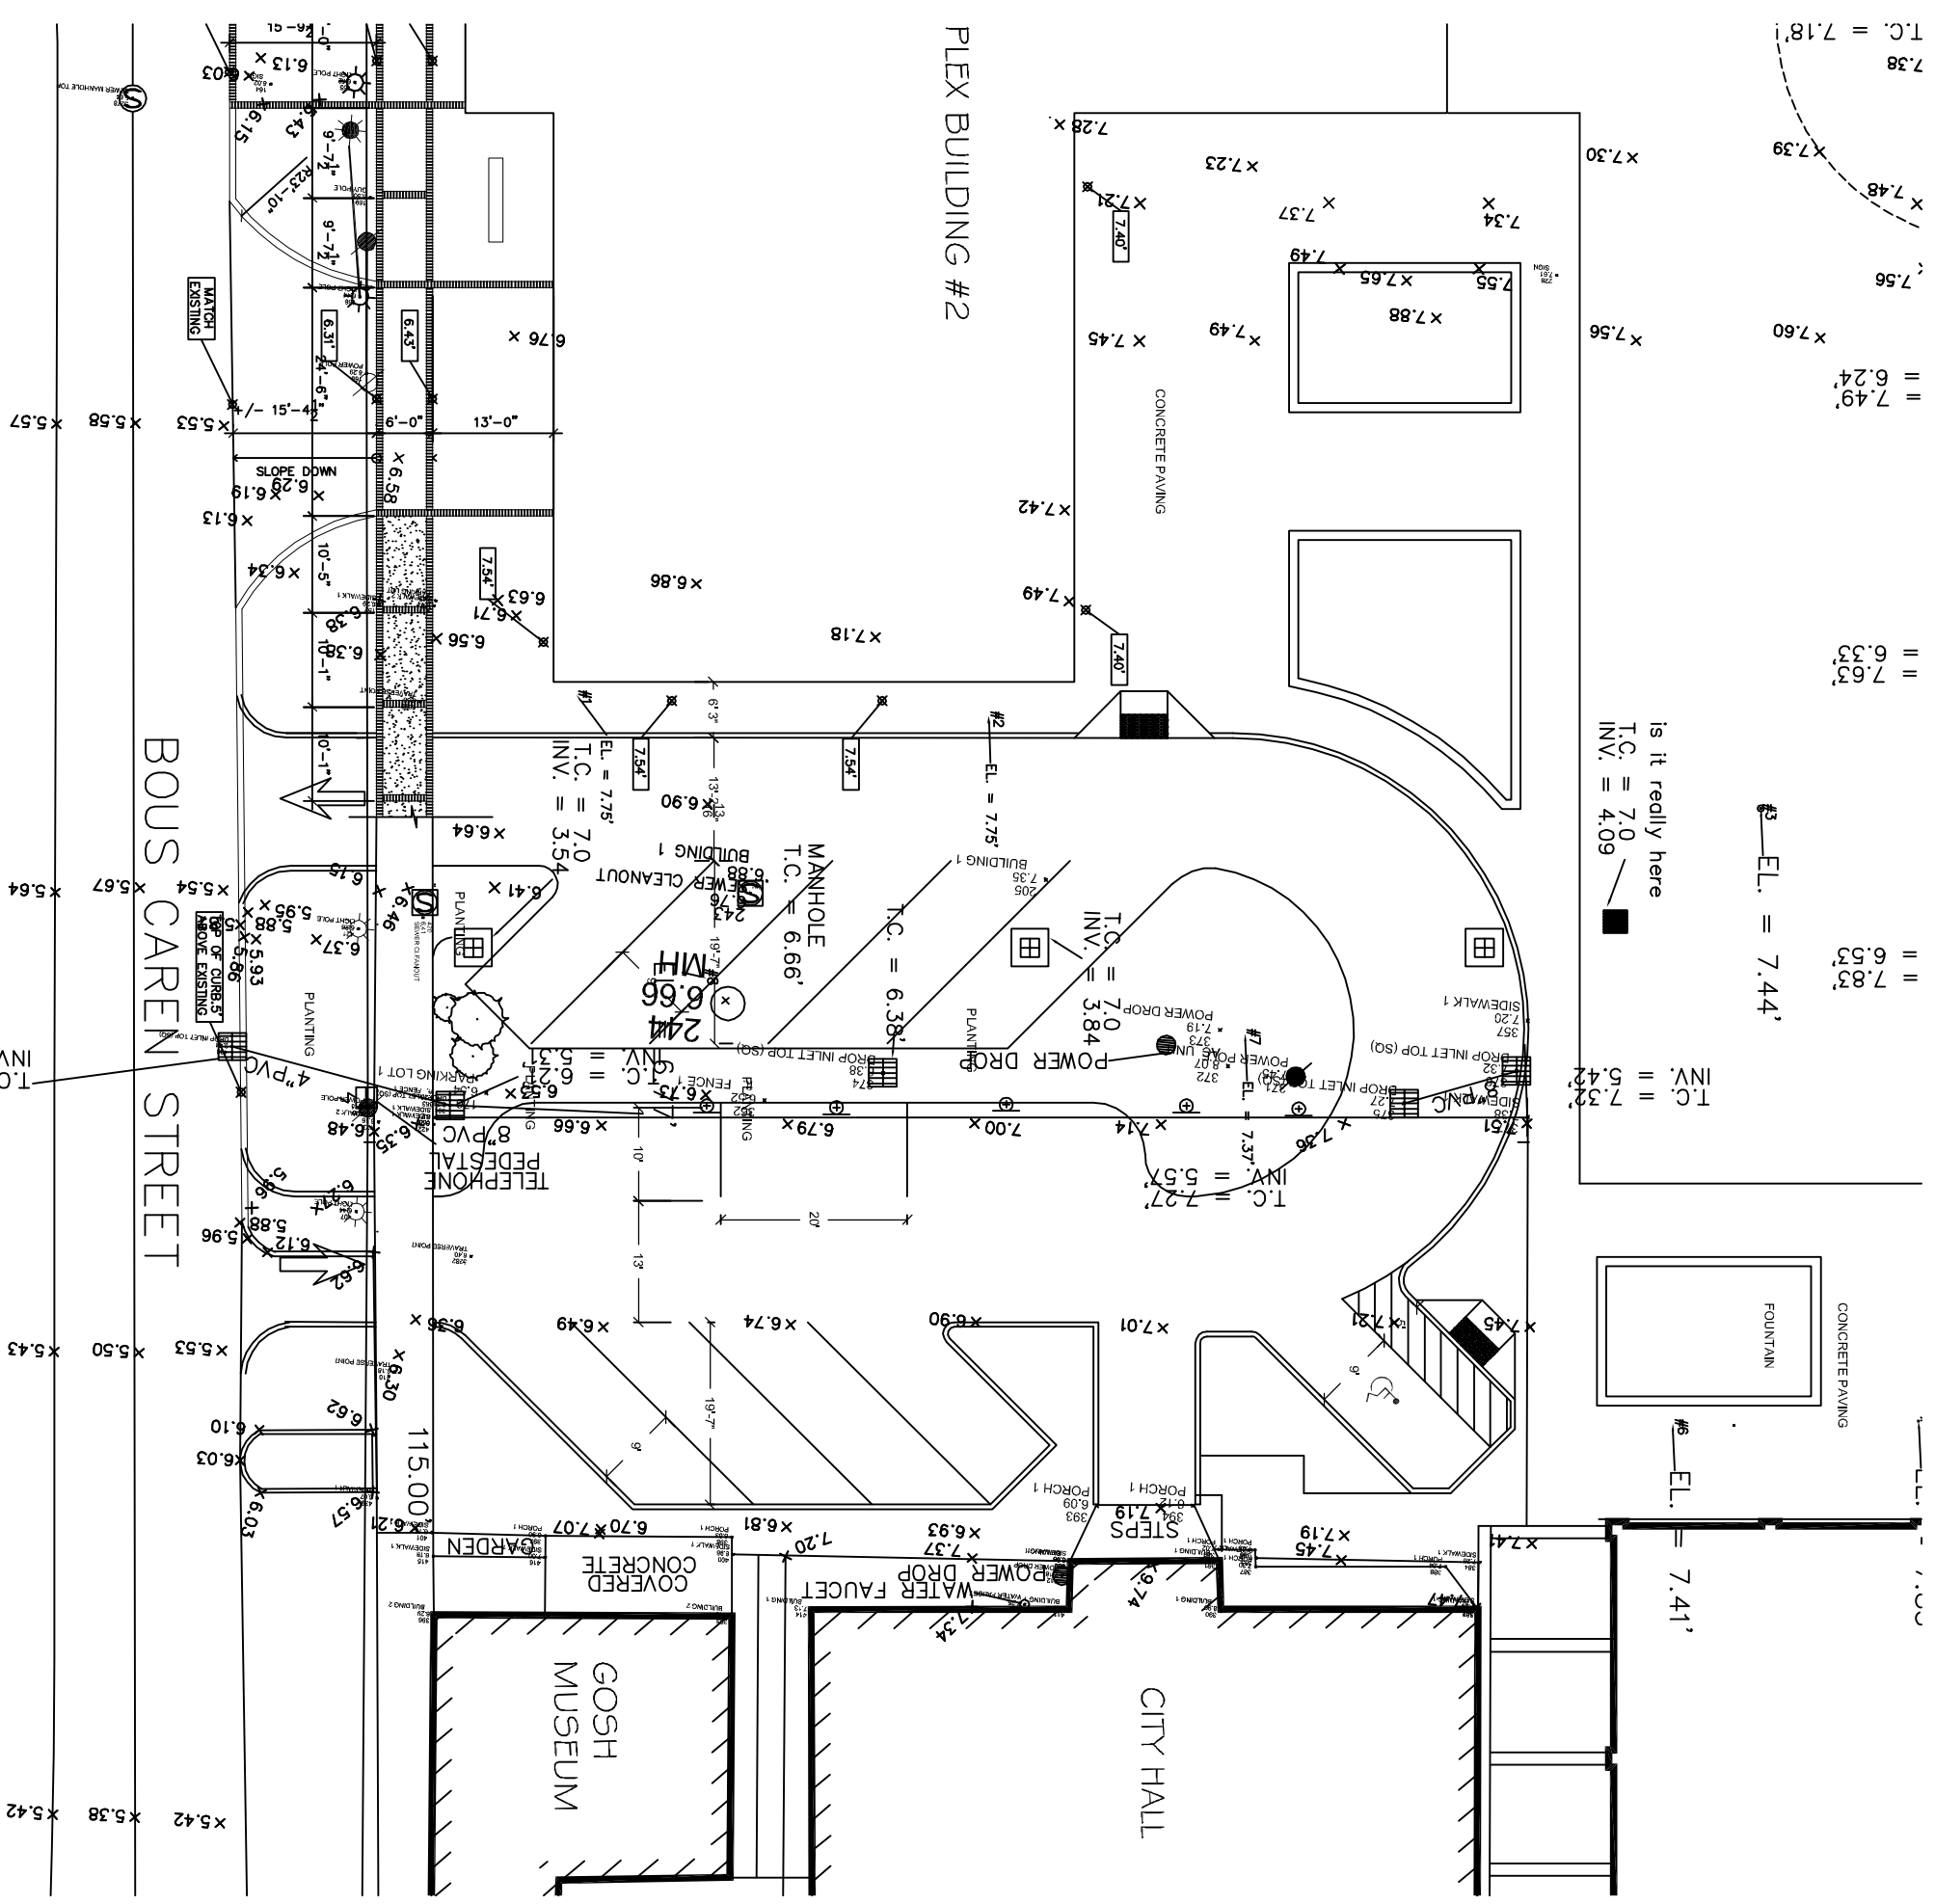

T.C. = 4.5
 INV. = 5.64

T.C. = 5.57

X 5.42

X 5.38

X 5.43

X 5.50

X 5.53

X 5.54

X 5.57

X 5.58

X 5.64

X 5.67

X 5.68

X 5.74

X 5.75

