EX. DUMPSTER PAD AND ENCLOSURE TO BE RELOCATED

EX. CHAIN LINK FENCE

FAMILY HOUSING PROPERTY LINE

DINING PATIO

LODGE SITE

PORTE COCHERE

PAVING (TYP)

EX. FENCE TO REMAIN

NAVY LODGE
BLDG 331
(15 UNITS)

FENCE

FIRE LANE RESTRICTED ACCESS

EX. PARKING

EX. DUMPSTER PAD AND ENCLOSURE (RELOCATE DUMPSTER TO NEW PAD)

APPROX. 20,000 SQ.FT. OF PAVING

DOUBLE DUMPSTER PAD AND ENCLOSURE

SIDEWALK (TYP)

"NAVY LODGE" SIGN

FIRST ST

PLAN NORTH

ASPHALT LAYOUT
SCALE: 1/16" = 1'-0"

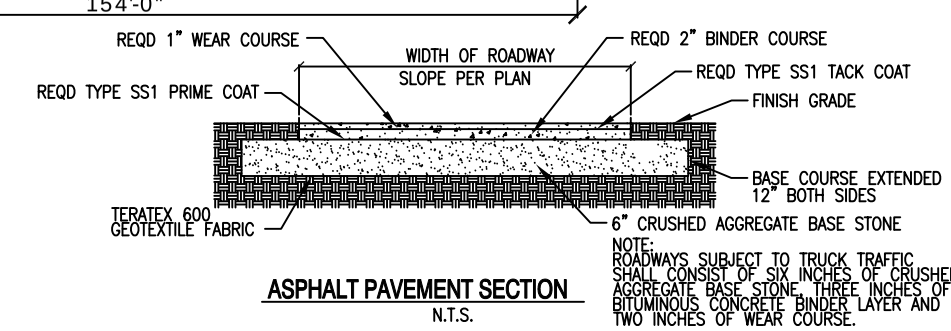

ASPHALT PAVEMENT SECTION
N.T.S.

NOTE:
ROADWAYS SUBJECT TO TRUCK TRAFFIC SHALL CONSIST OF SIX INCHES OF CRUSHED AGGREGATE BASE STONE, THREE INCHES OF BITUMINOUS CONCRETE BINDER LAYER AND TWO INCHES OF WEAR COURSE.

SYM	DESCRIPTION	DATE	APPR.
3	AS-BUILT CONDITIONS SHOWN	3-12-10	RW
	REVISED EXPANSION JOINT LOCATIONS	2-1-10	RW
	REVISED AS PER UFC COMMENTS 9 OCTOBER 2009	11-6-09	RW

NAVFAC

DAMMON ENGINEERING, INC.
CHIEF ENGINEER EMMETT L. DAMMON, P.E. — CHIEF ARCHITECT ROBERT WILTSE
1005 FLORIDA AVENUE
SLIDELL, LA 70458
(985) 649-5832
APRIL 28, 2010

DES: C. DAMMON | DRW: C. DAMMON
REVIEWED BY: R. WILTSE
PM/DM:
CHIEF ENG/ARCH. P. DAMMON

DEPARTMENT OF THE NAVY
NAVAL FACILITIES ENGINEERING COMMAND
IPT GULF COAST
GULFPORT

NAVAL FACILITIES ENGINEERING COMMAND SOUTHEAST
NAVAL AIR STATION JACKSONVILLE
MISSISSIPPI

NAVY LODGE, NCBC GULFPORT

ASPHALT LAYOUT

CODE ID. NO. | SIZE D
SCALE: AS SHOWN
MAXIMO NO.
STA. PROJ. NO.
WORK ORDER NO.
CONSTR. CONTR. NO.
NAVFAC DRAWING NO. 15026665
SHEET 18 OF
C3.2

DRAWFORM REVISION: 01 JAN 2009

REVDATE: