




VICINITY MAP
N. T. S.

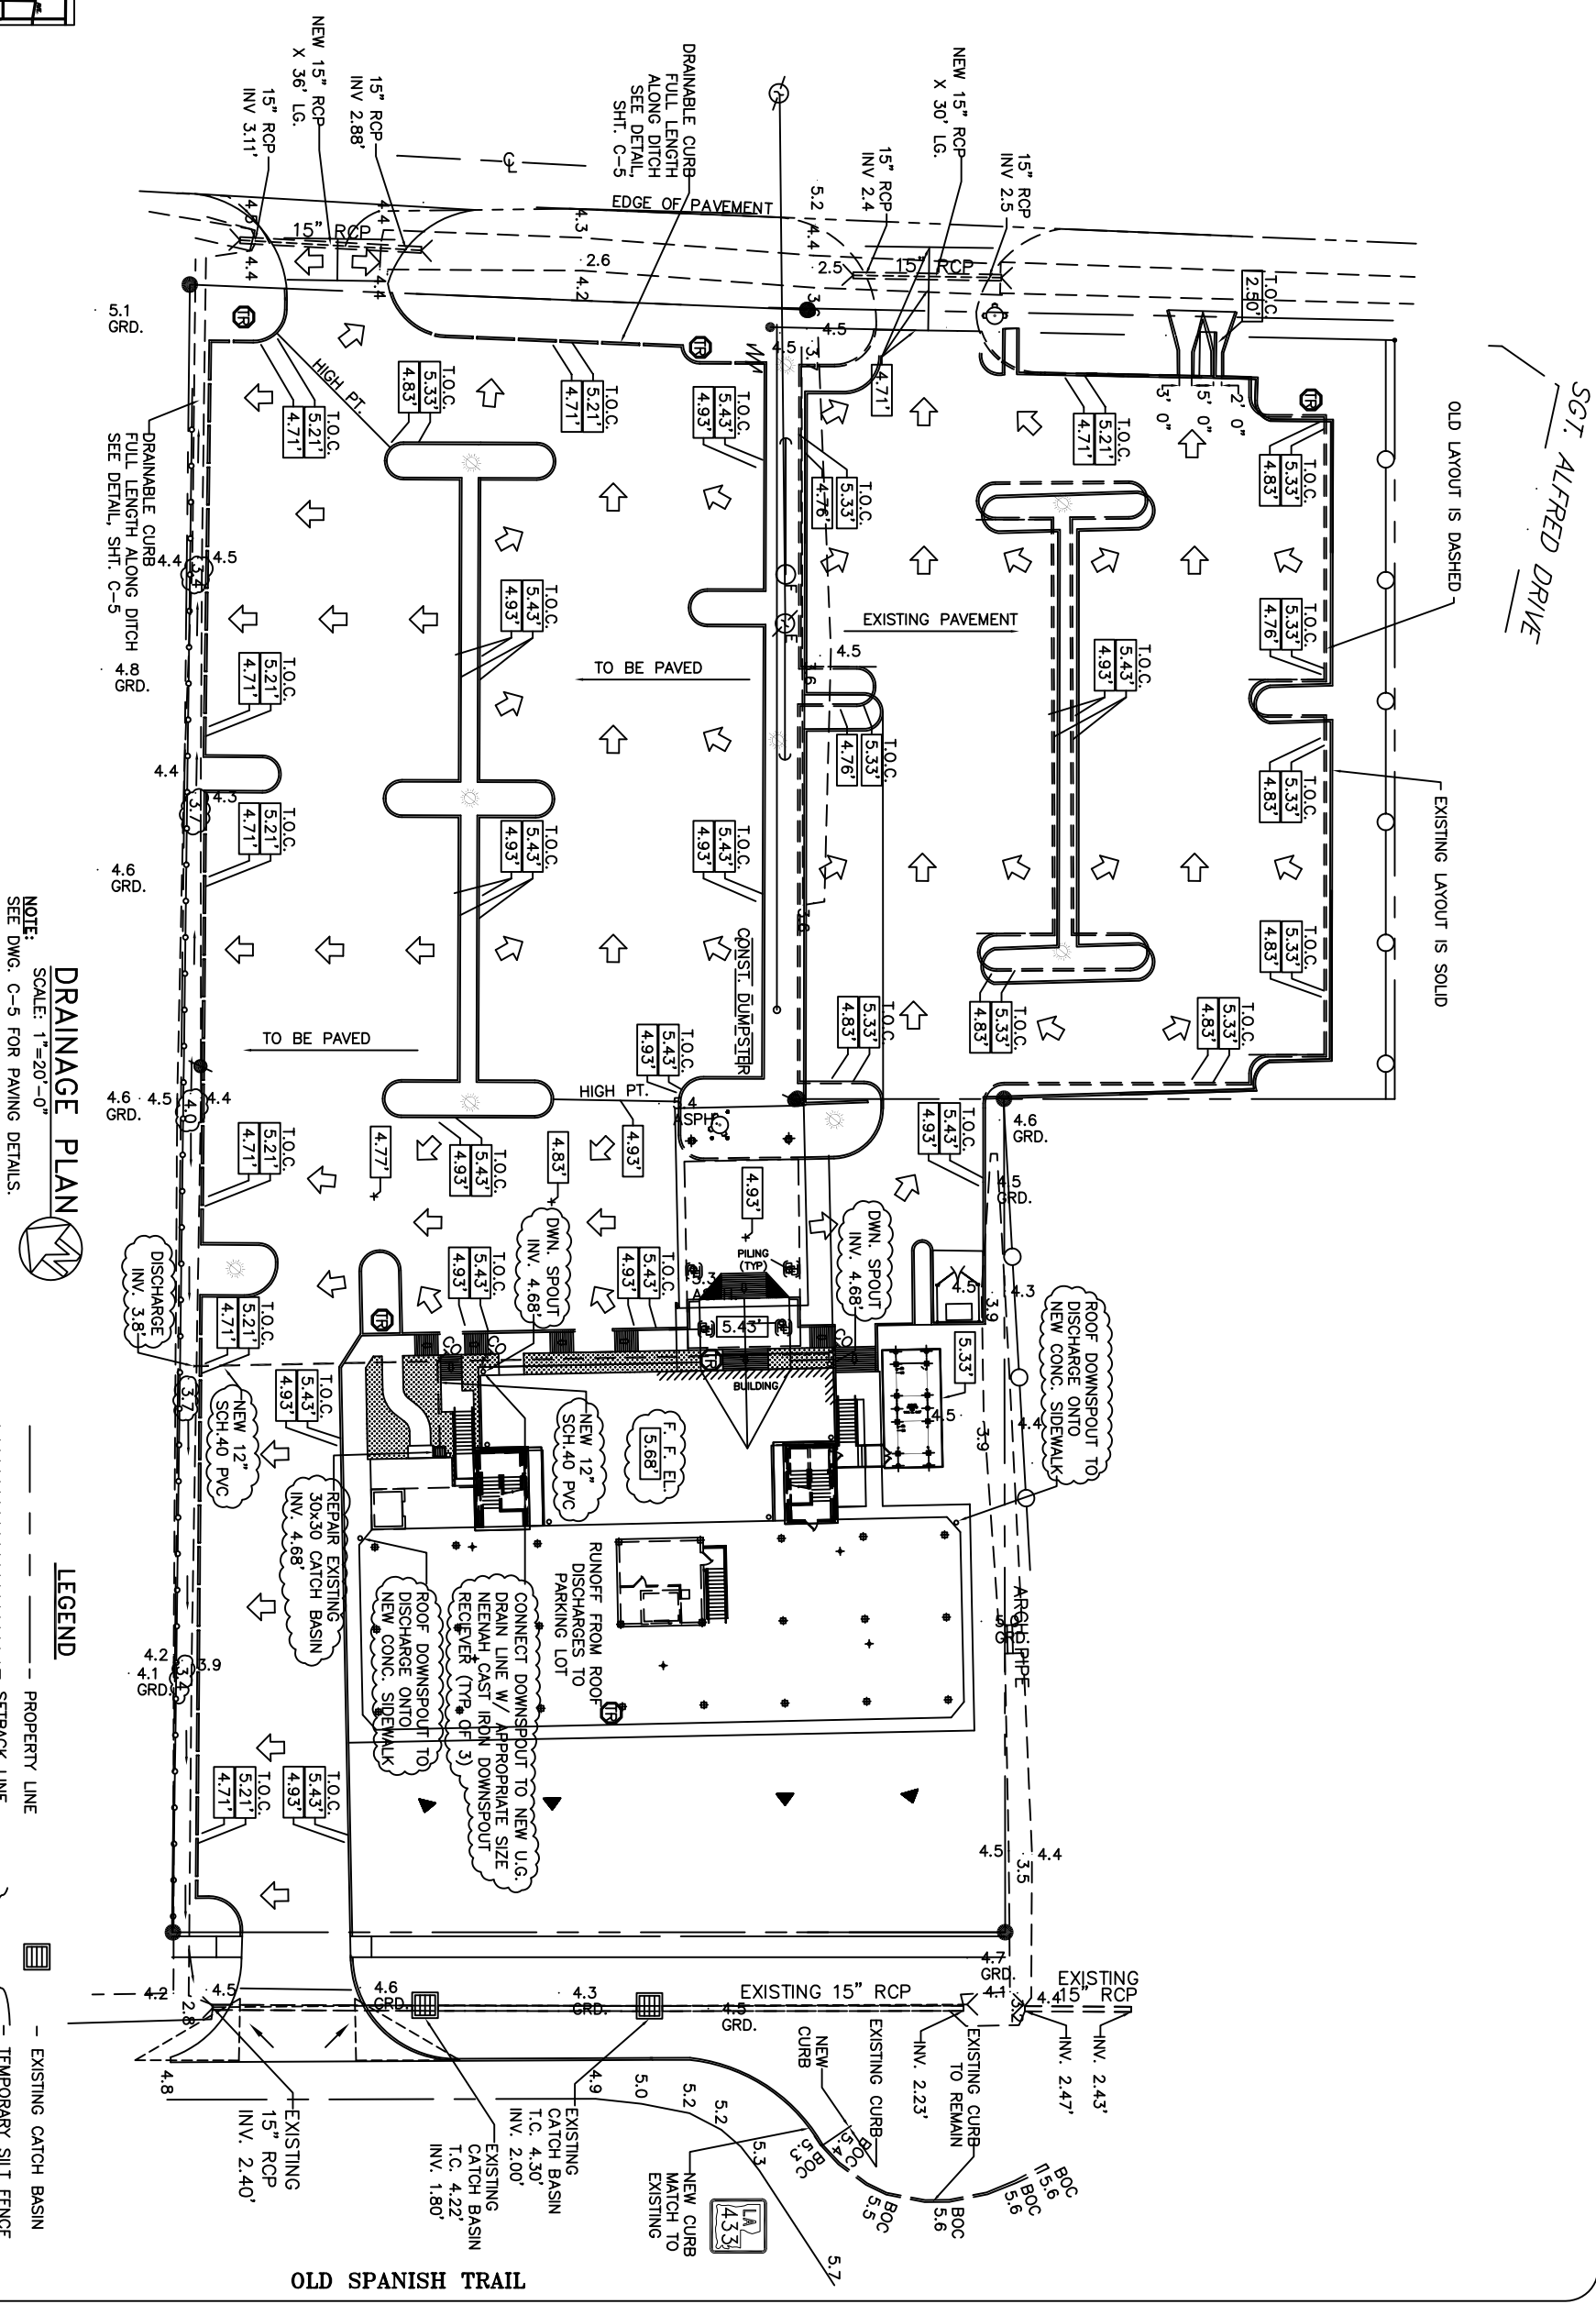

DRAINAGE PLAN
NOTE: SCALE: 1"=20'-0"
SEE DWG. C-5 FOR PAVING DETAILS.

LEGEND

- PROPERTY LINE
- SETBACK LINE
- NEW BUILDING
- NEW CURB
- TOP OF CURB
- BOTTOM OF CURB
- FINISHED FLOOR
- POUNDS PER SQUARE FOOT
- EXISTING CATCH BASIN
- TEMPORARY SILT FENCE
- EXISTING ELEVATIONS
- NEW ELEVATION
- DIRECTIONAL FLOW

CONTRACT SPT- 10/10/07

REVISED: 6-15-10
REVISED: 03-07-07ab

RENOVATE OFFICE BUILDING

DAMMON ENGINEERING, INC.

1095 FLORIDA AVENUE 985-649-5832 SLIDELL, LA. 70458
DAMMONENGINEERING.COM

DRAINAGE PLAN

ST. TAMMANY PARISH ADMIN. COMPLEX
520 OLD SPANISH TRAIL
SLIDELL, LOUISIANA

SCALE: 1"=20'
FILE:
JOB NO. 1729
DATE: 1-12-07
SHEET
C-4
OF