

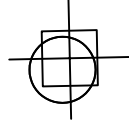
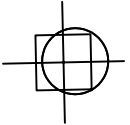


4


ASPH

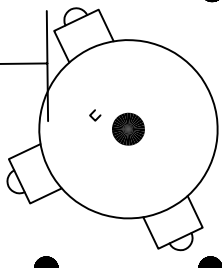

4.93'





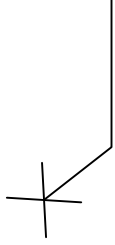


PIILING  
(TYP)

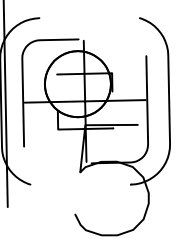

3.3


ASPH

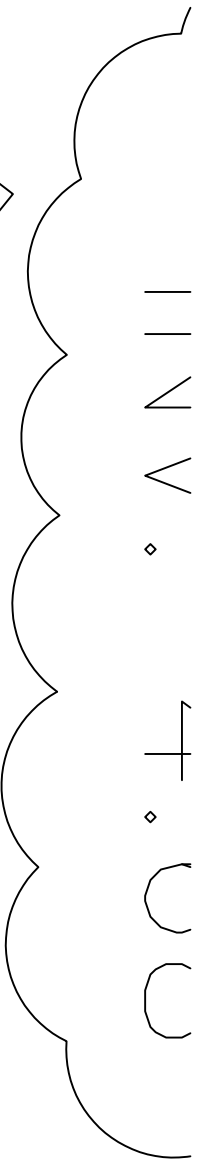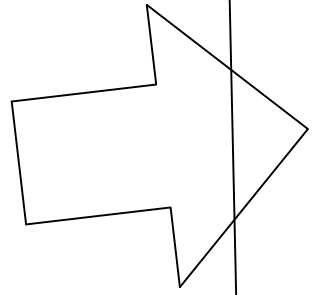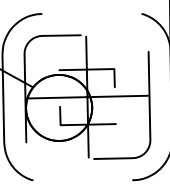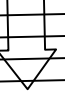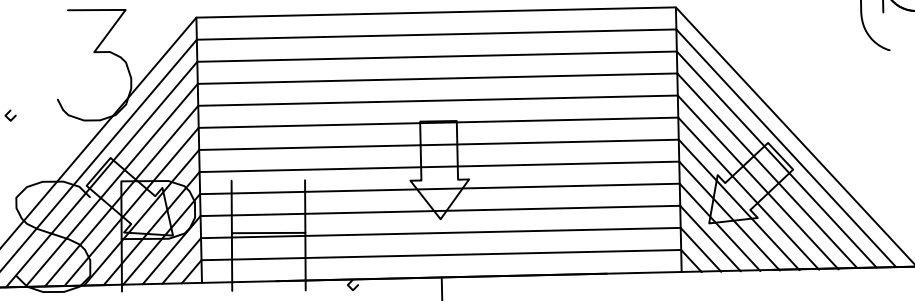




LINE + TOCC

T.O.C.

119.9'

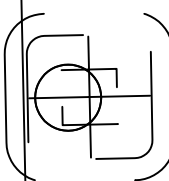

5.43'

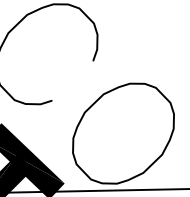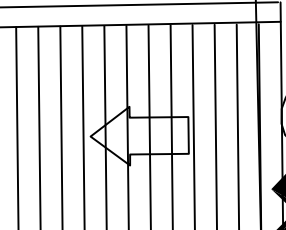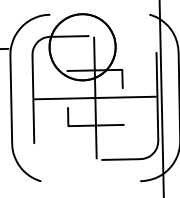

144.6'

228.2'

