REVISED 10-12-10
RFI-130
VENT-A/C IN MECHANCAL ROOM

RFI-130

FLEX DUCT AND CEILING MOUNTED REGISTER WITH FIRE DAMPER IN WALL.
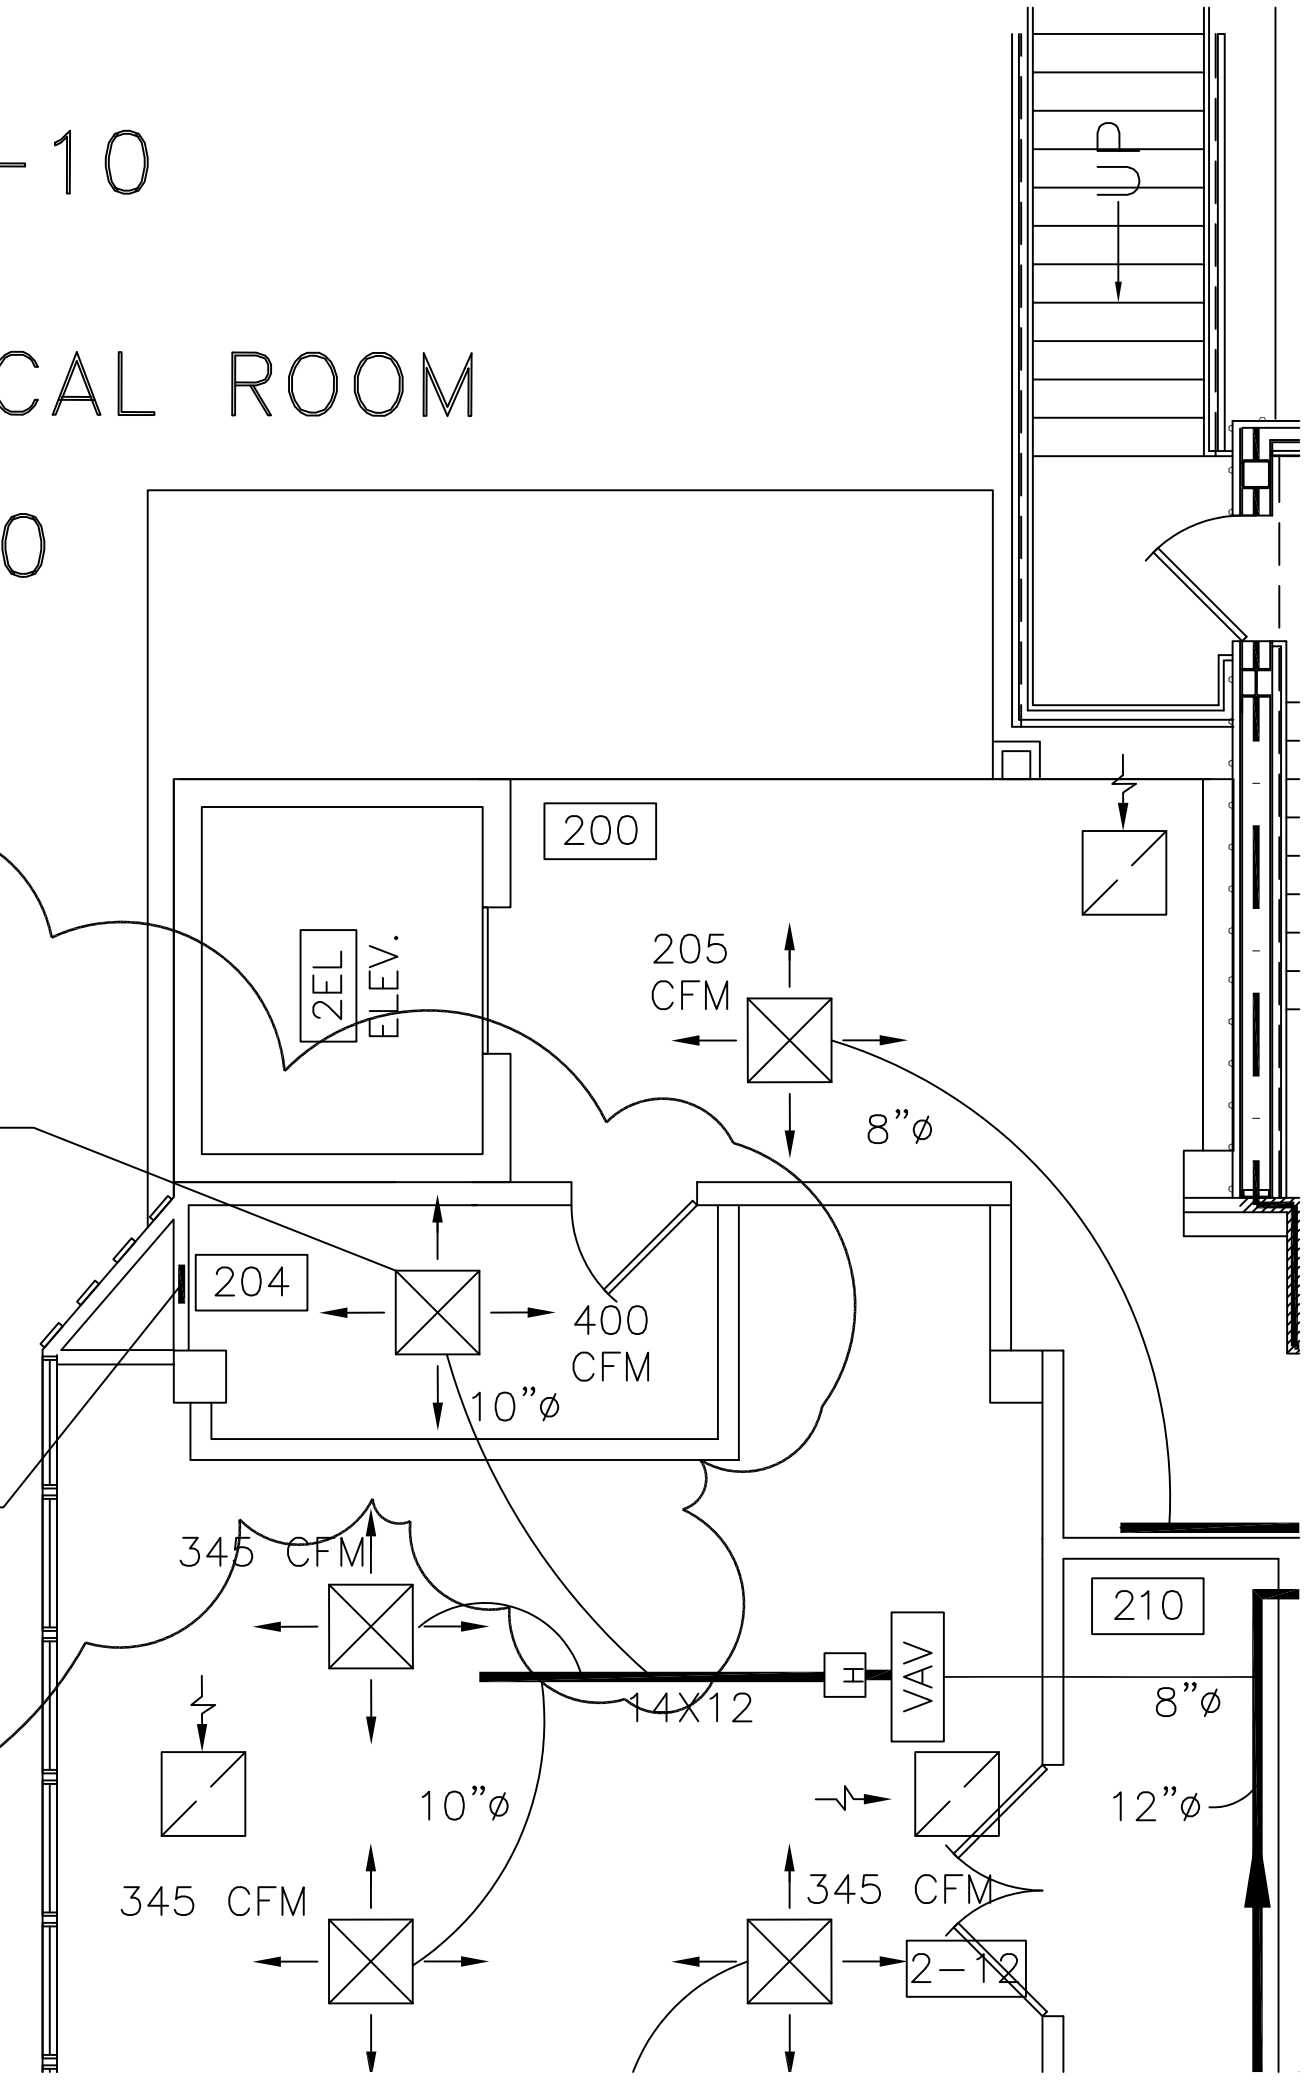
NEW 6"X6"VENT W/1 HR FIRE DAMPER INTO CHASE