


NORTHWEST
STAIR TOWER
FOUNDATION
T.O.S. EL. 5.58'

EXISTING
ELEVATOR &
LOBBY

FOOTPRINT OF
STAIR TOWER

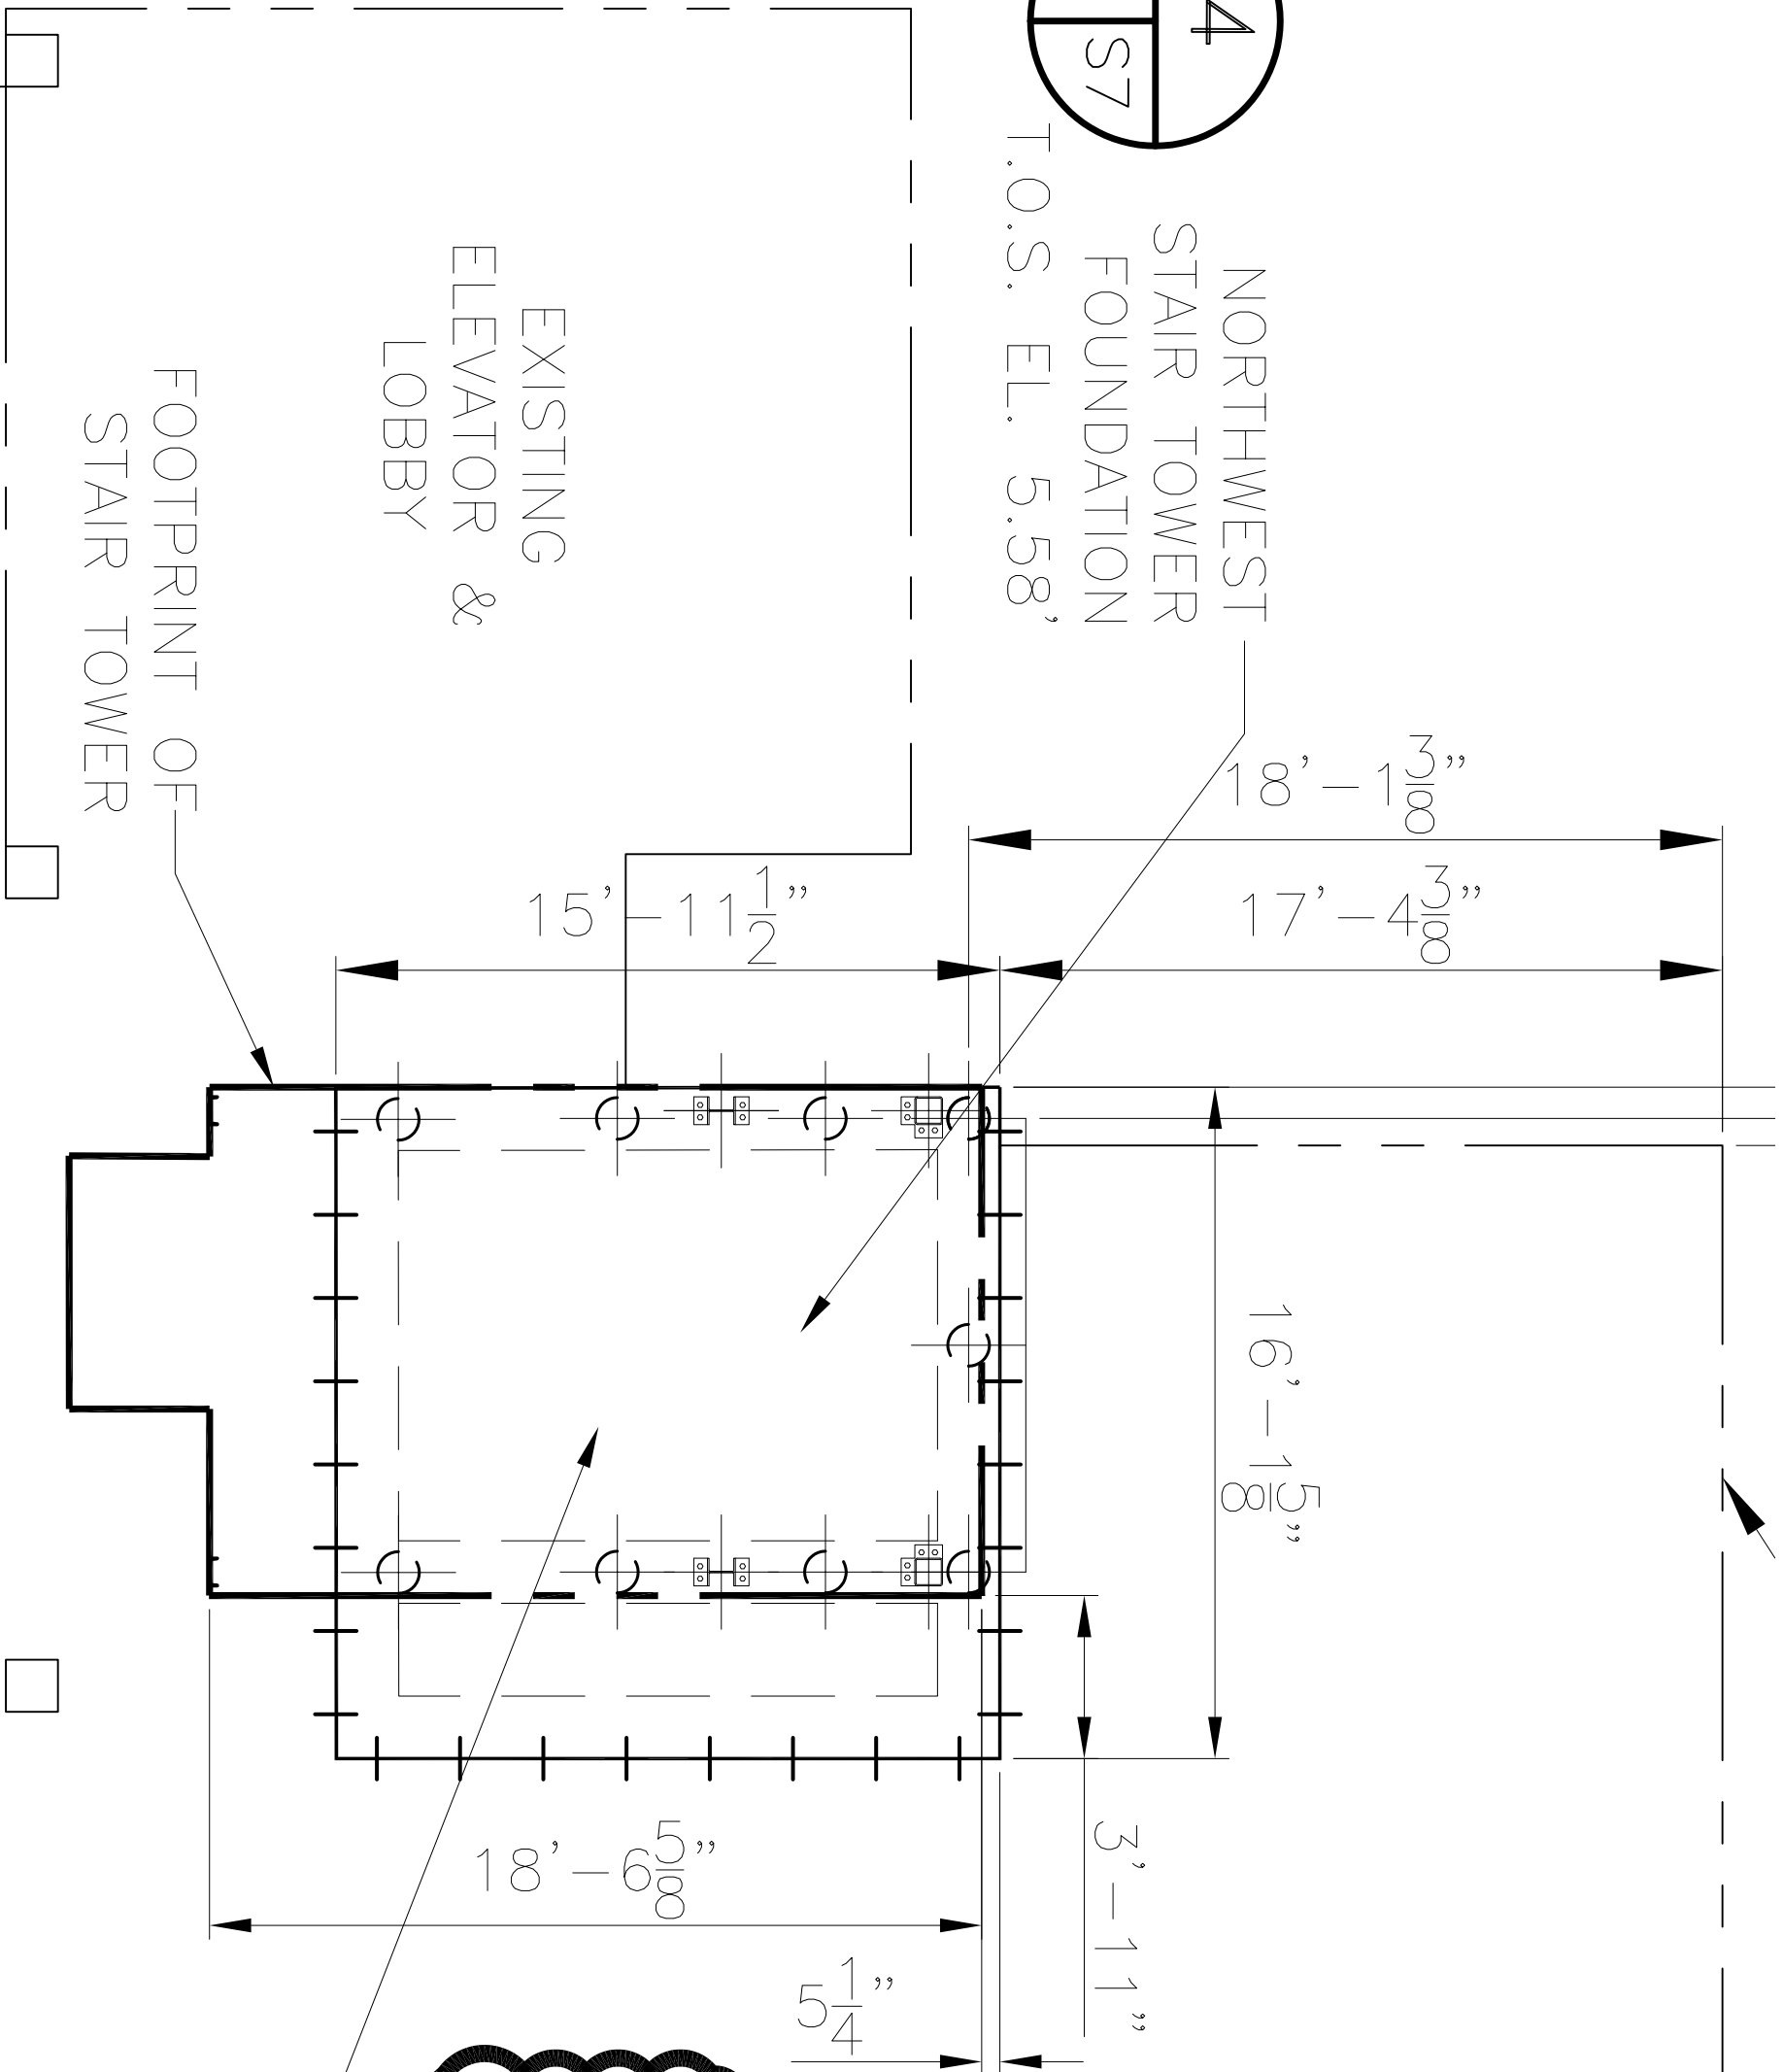

NOTE:
PROVIDE TERMITTE TREATN
BELOW NEW STAIR TOWE

EXISTING
T.O.S. 1

6" THK. CONC
W/ 6X6 0/1
.006 MEN