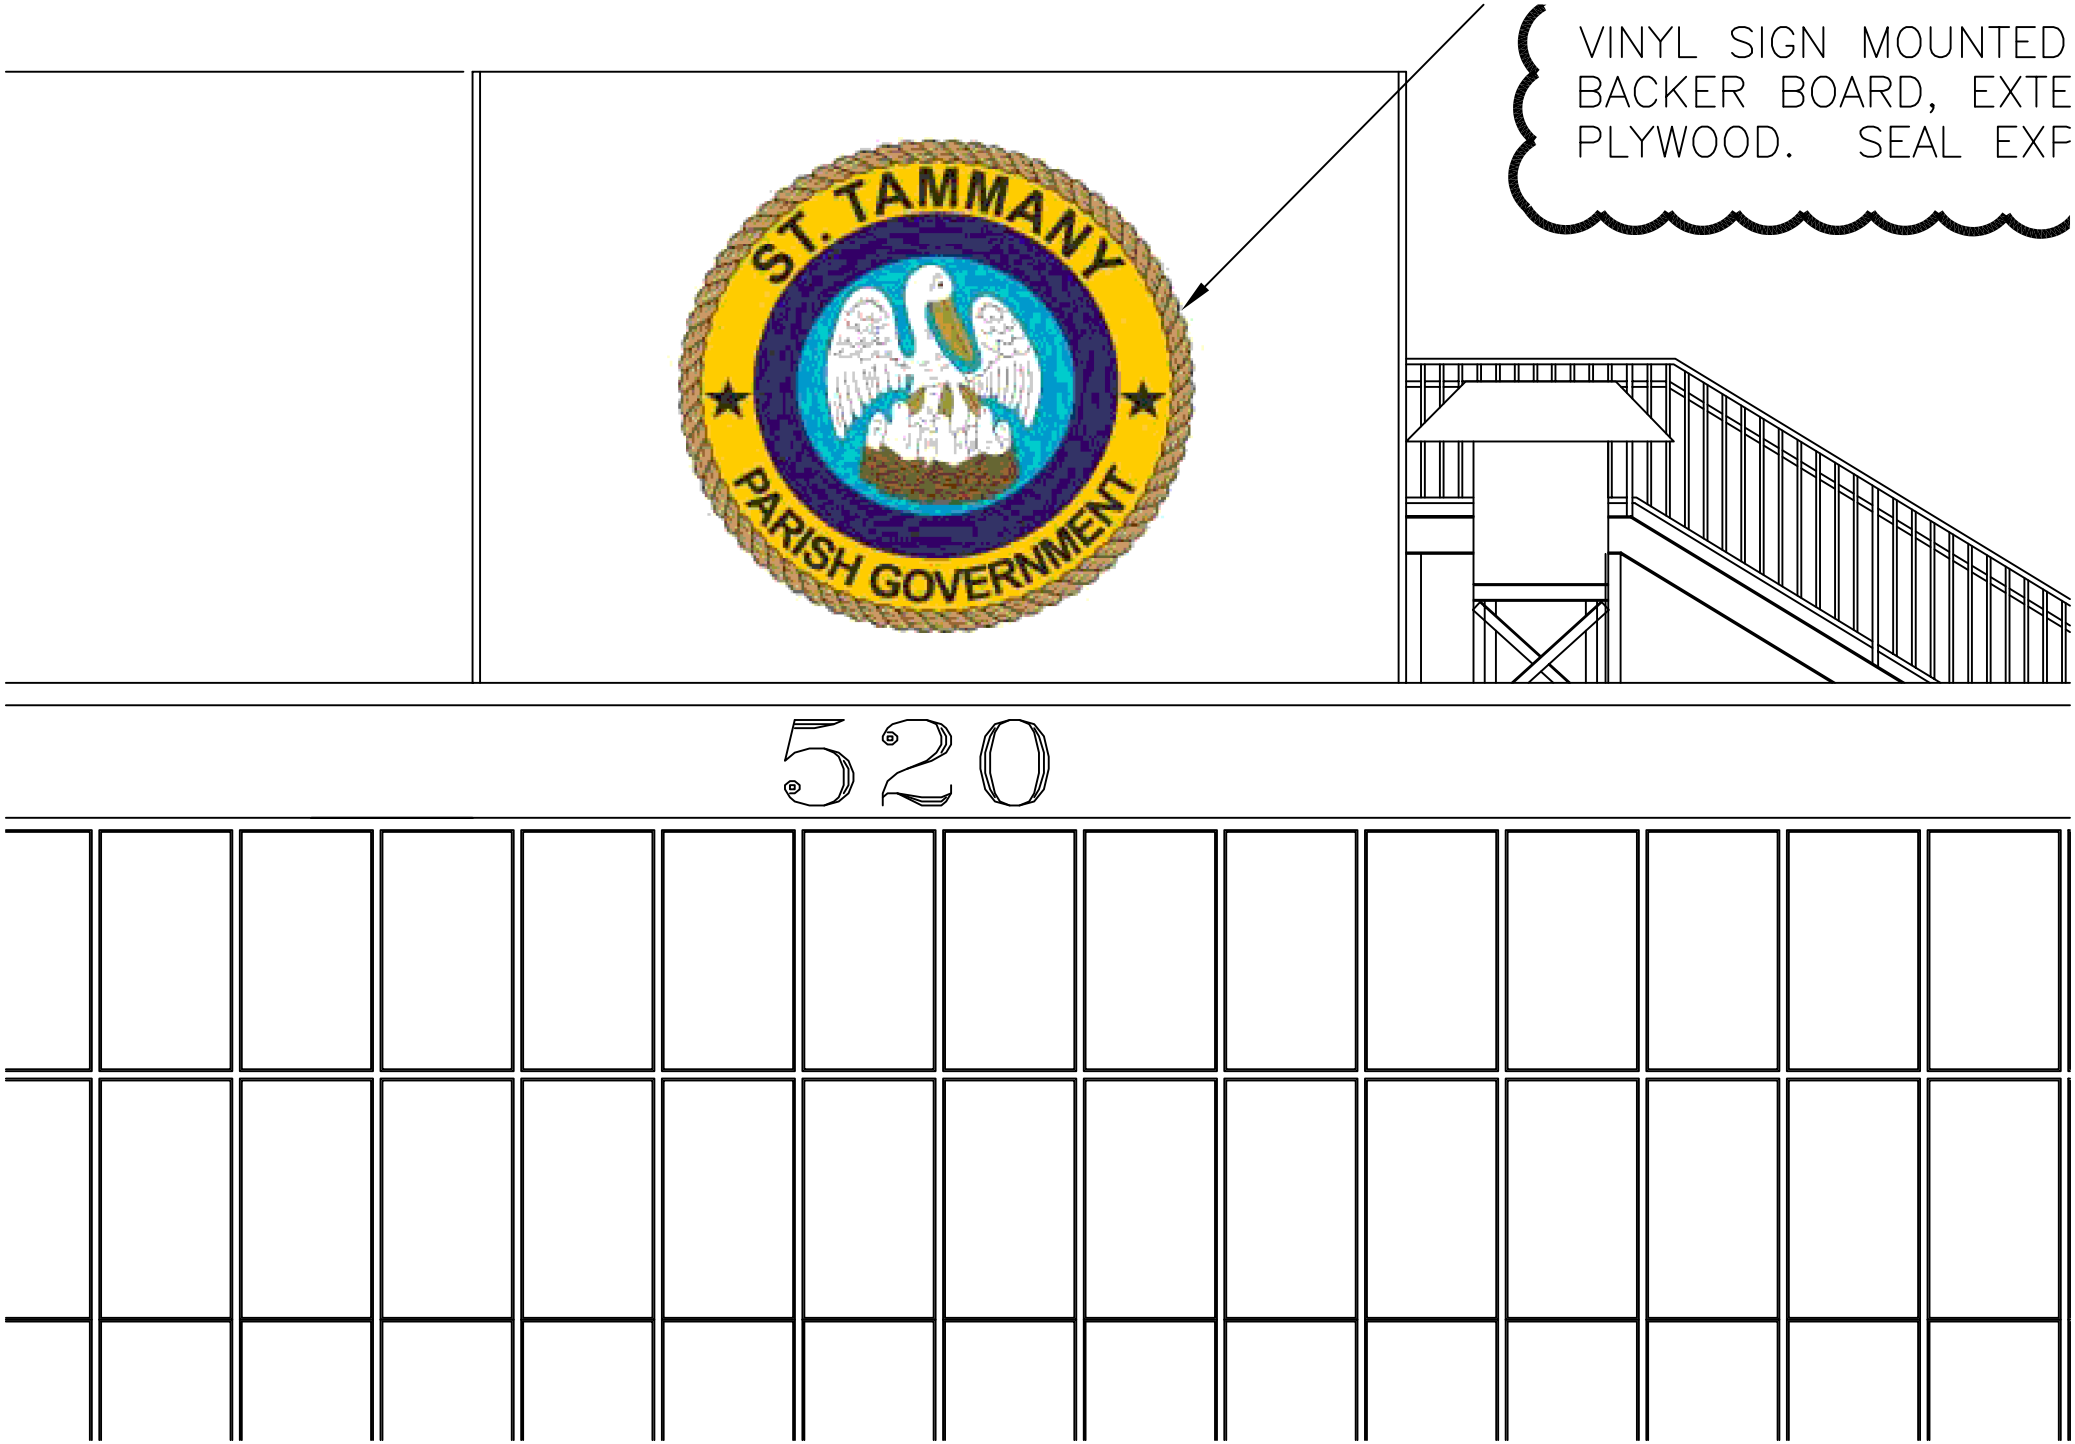
VINYL SIGN MOUNTED
BACKER BOARD, EXTE
PLYWOOD. SEAL EXP
ST. TAMMANY
PARISH GOVERNMENT
520