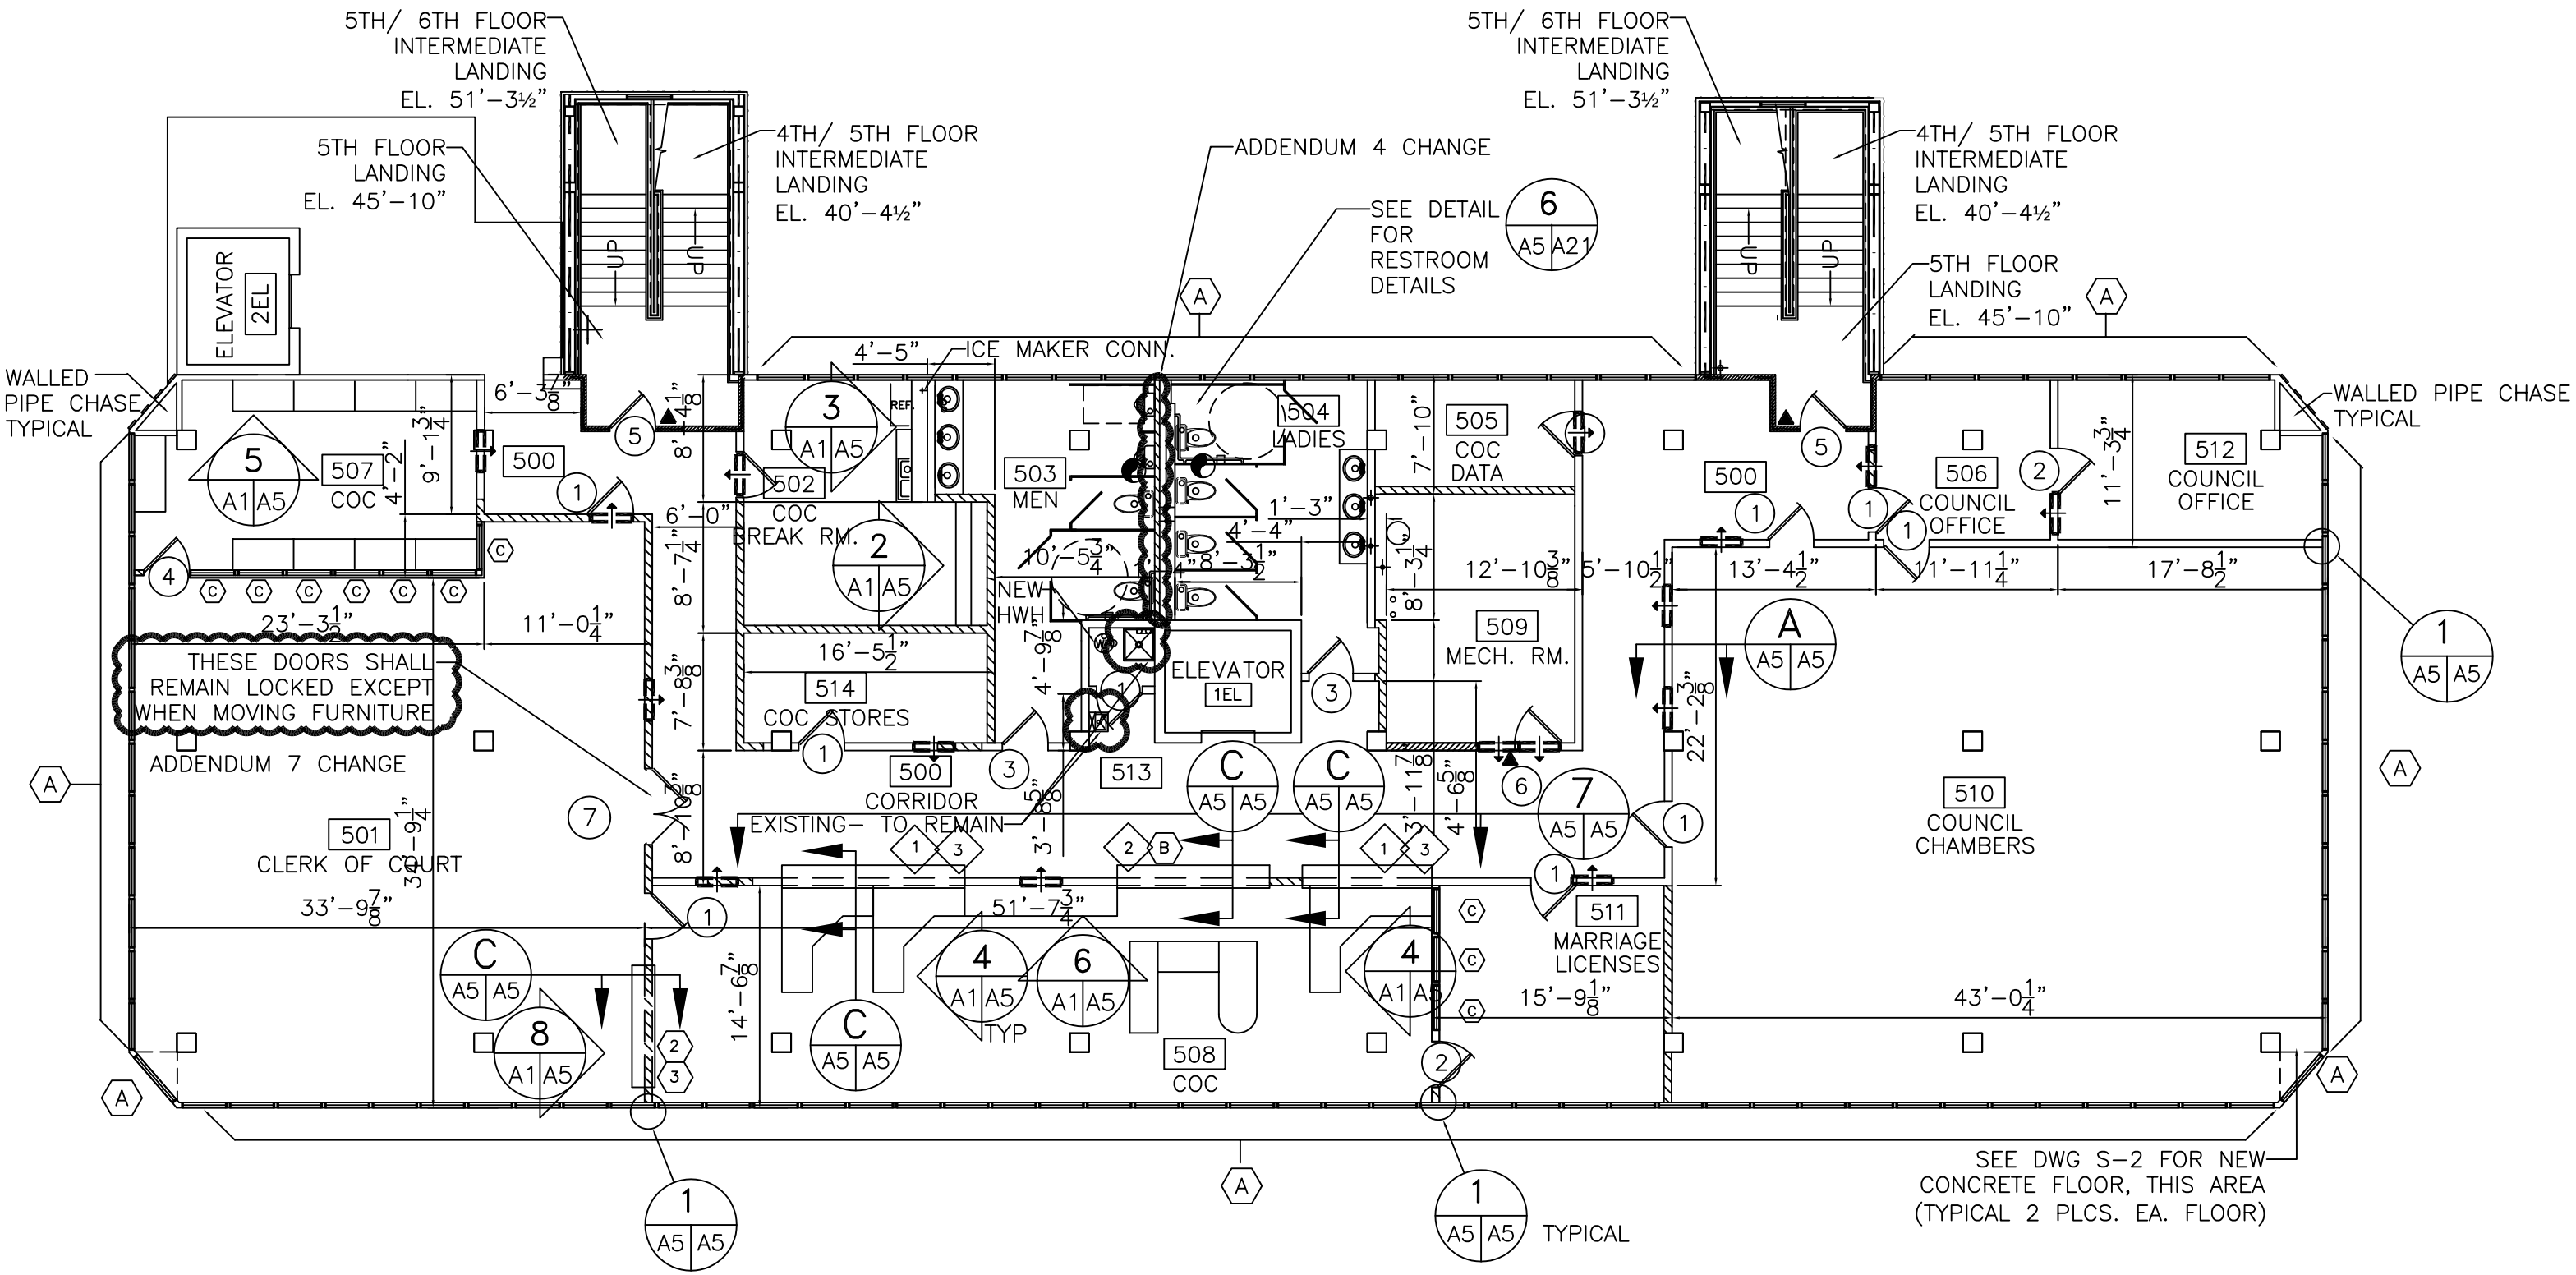

FIFTH FLOOR PLAN
SCALE: 1/8"= 1'-0"