


2 BUILDING SECTION  
SCALE: 1/8" = 1'-0"

THIS AREA

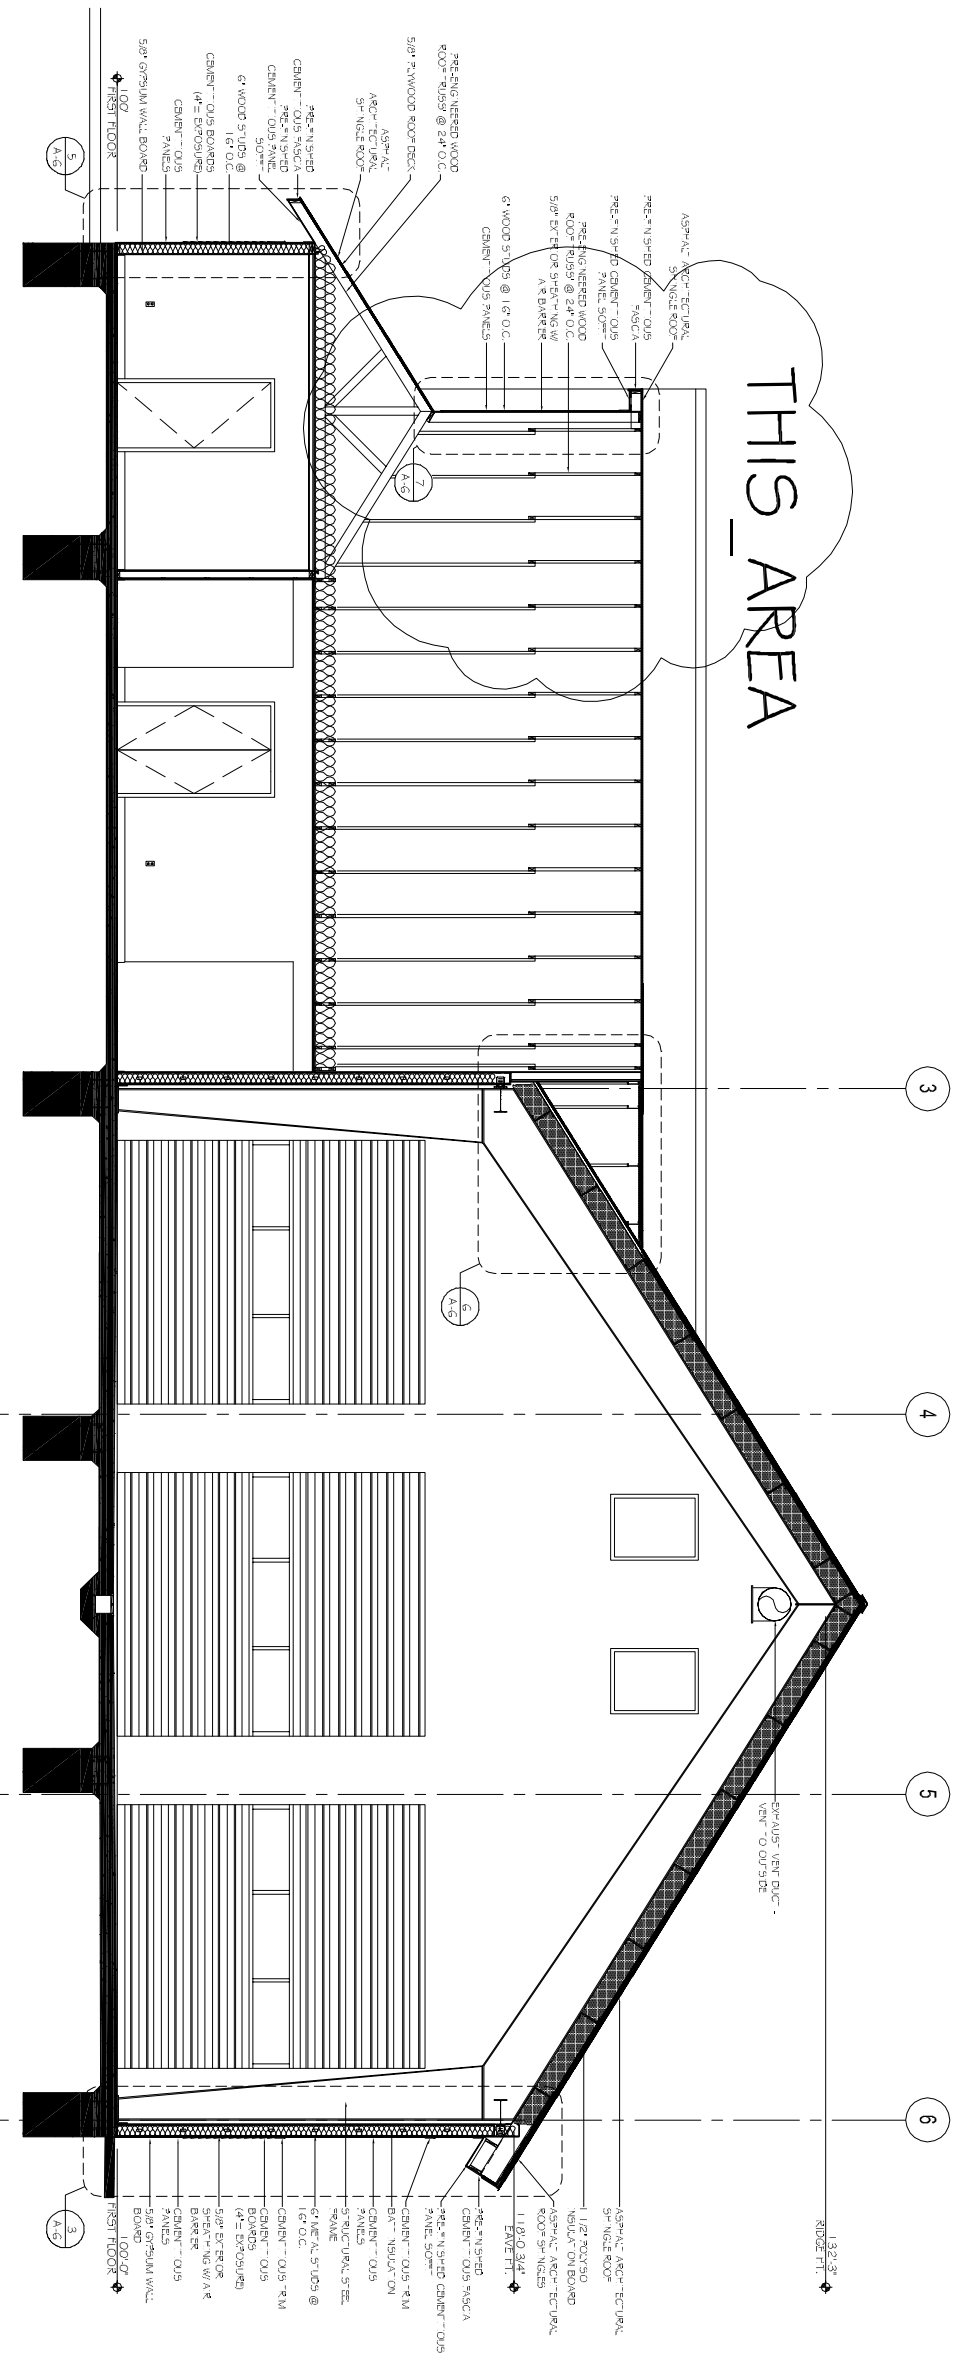

1 BUILDING SECTION  
SCALE: 1/8" = 1'-0"

REVISIONS		DATE
#	DESCRIPTION	

DISTRICT 1  
FIRE STATION 4

297 STEELE ROAD  
SLUPELL, LA

JOB No: DATE: 3/7/2013  
DRAWN BY: KJK CHECKED BY: KJK

This is not an official specification, design or drawing. It is a preliminary drawing and shall not be used for construction or for any other purpose without the written consent of Dammon Engineering, Inc. All rights reserved. No part of this drawing may be reproduced or transmitted in any form or by any means, electronic, mechanical, photocopying, recording, or by any information storage and retrieval system, without the prior written permission of Dammon Engineering, Inc.



**DAMMON**  
ENGINEERING, INC.  
Architects & Engineers

CHIEF ENGINEER: EMMETT DAMMON, P.E.  
CHIEF ARCHITECT: KEVIN KNICHEN  
554 OLD SPANISH TRAIL  
SLUPELL, LA 70458

dammoneng@earthlink.net  
PHONE: 985-649-5832  
FAX: 985-641-5950

BUILDING SECTIONS

SHEET No: 01 OF 1

A-5