













a. Disapproved   
 b. Approved as noted. Clarify & resubmit.   
 c. Approved as noted.   
 d. Approved for general configuration.

This approval does not relieve the Contractor from proper design, fabrication or installation, nor does it relieve him of any warranty or obligation of the contract.

**DAMMON ENGINEERING**  
 Engineer: *[Signature]*  
 Date: 4/22/08

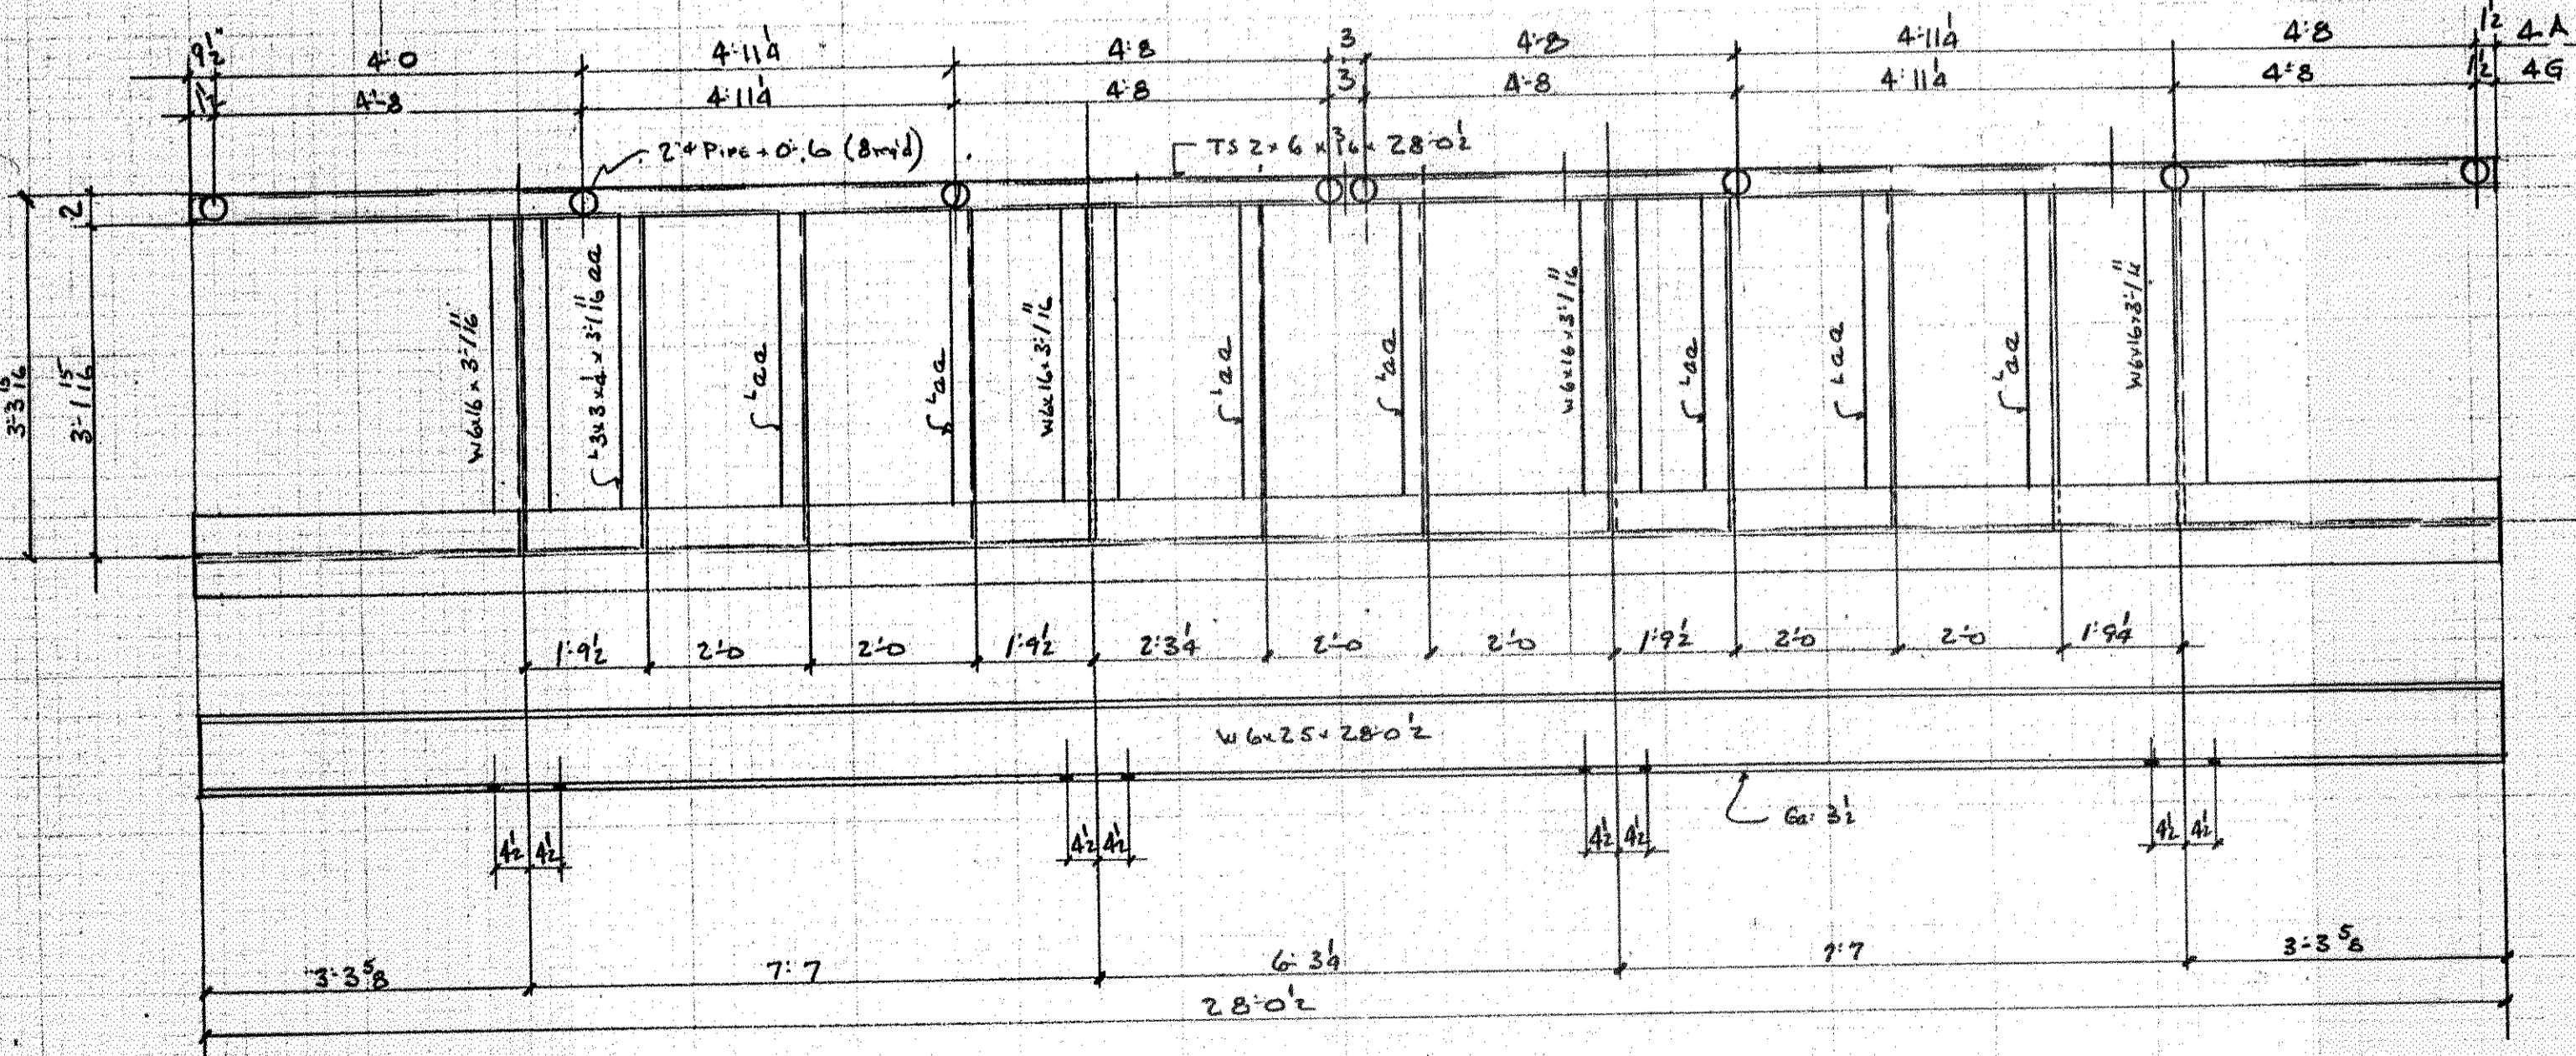

4B  
 ①  
 4G  
 ①

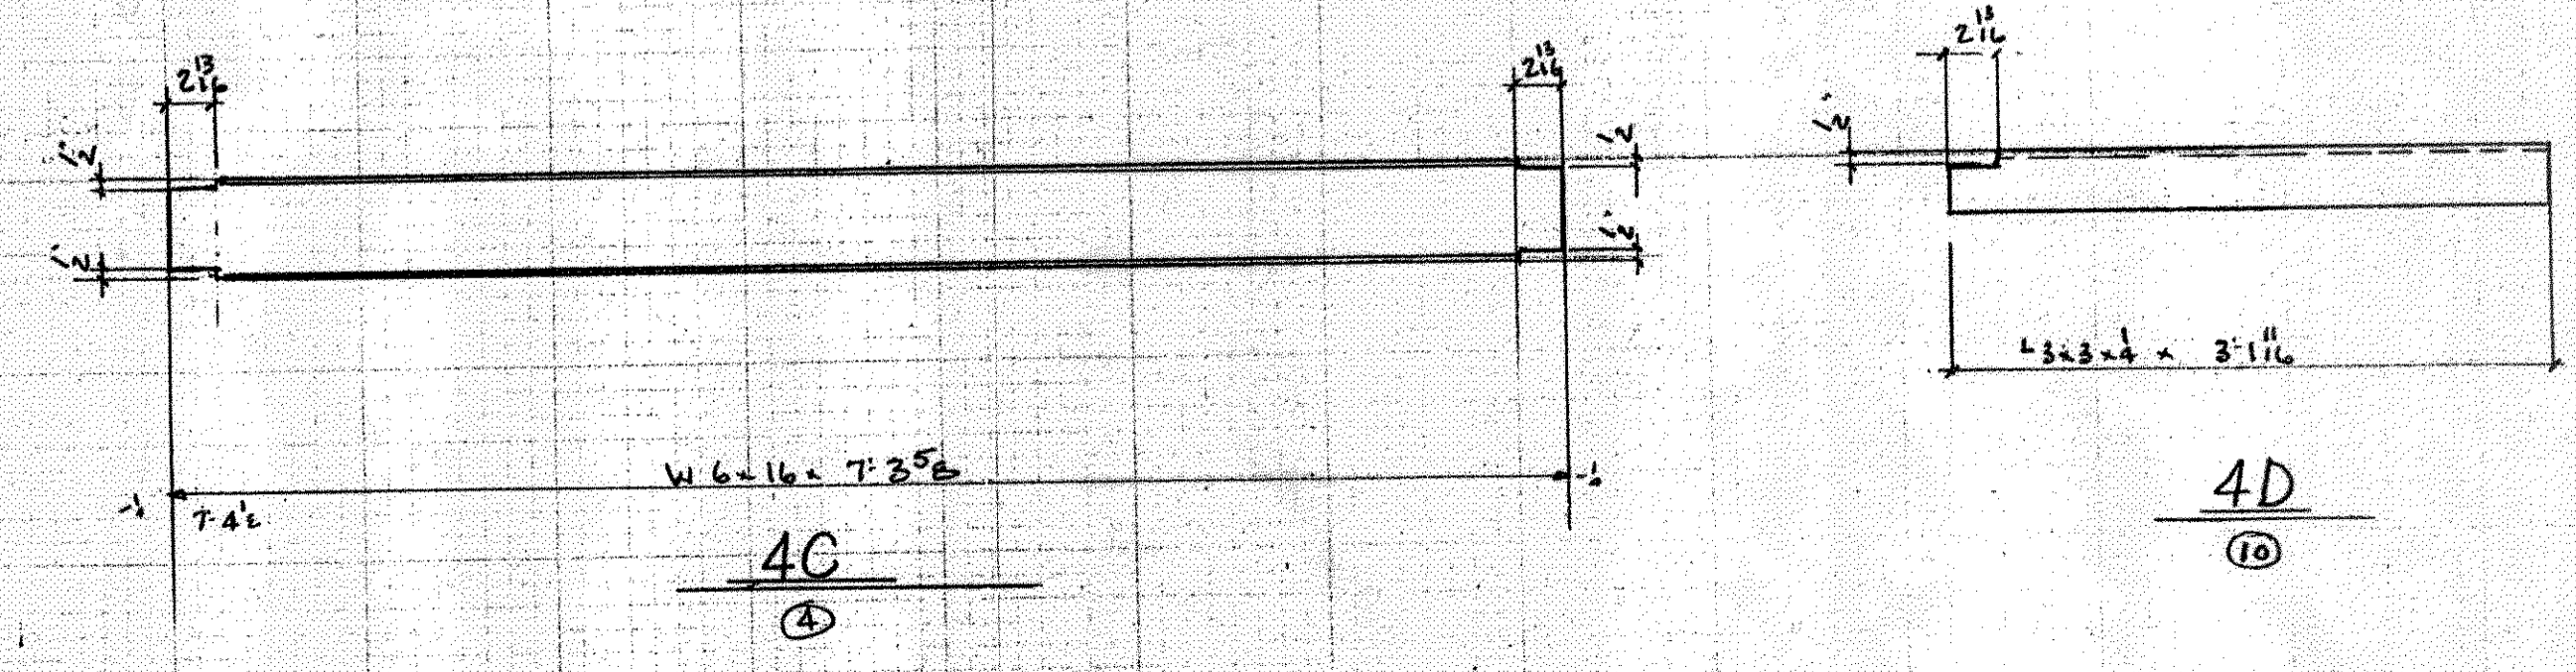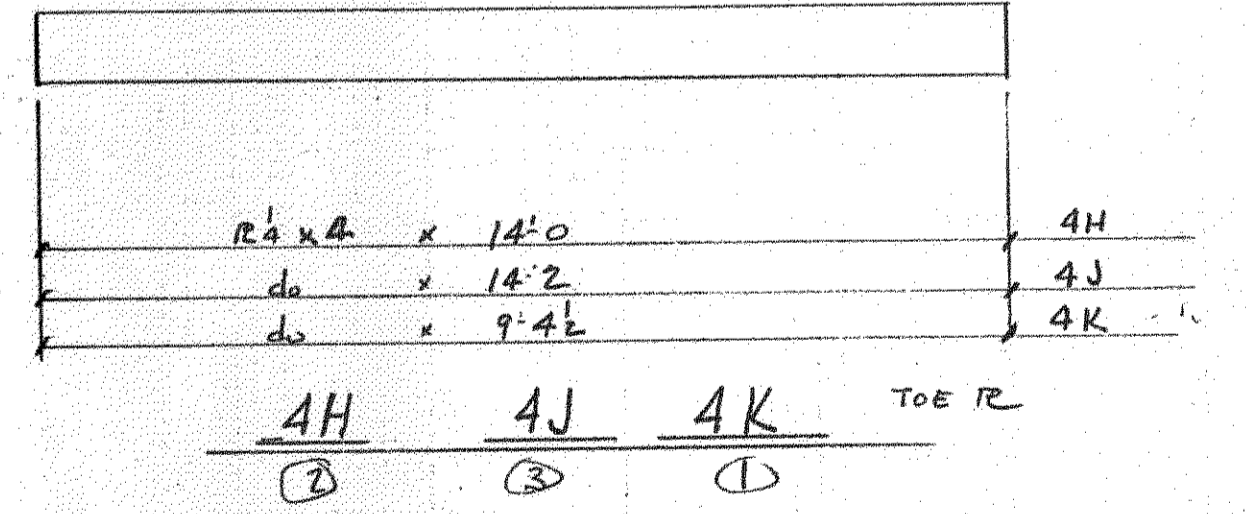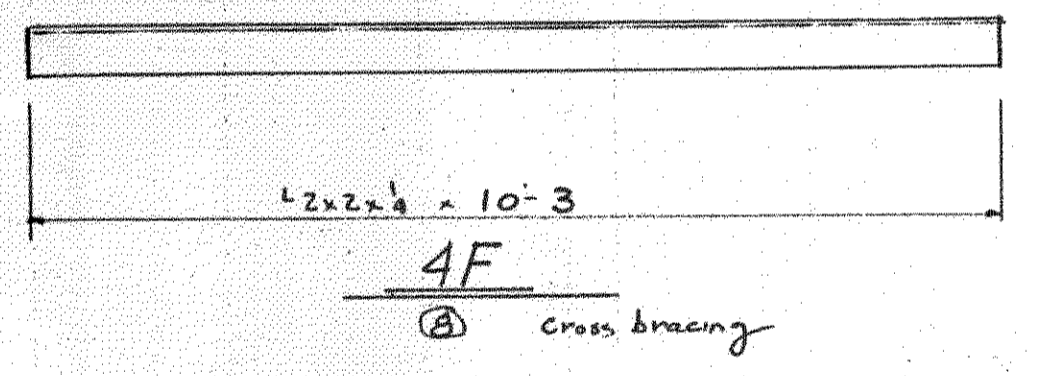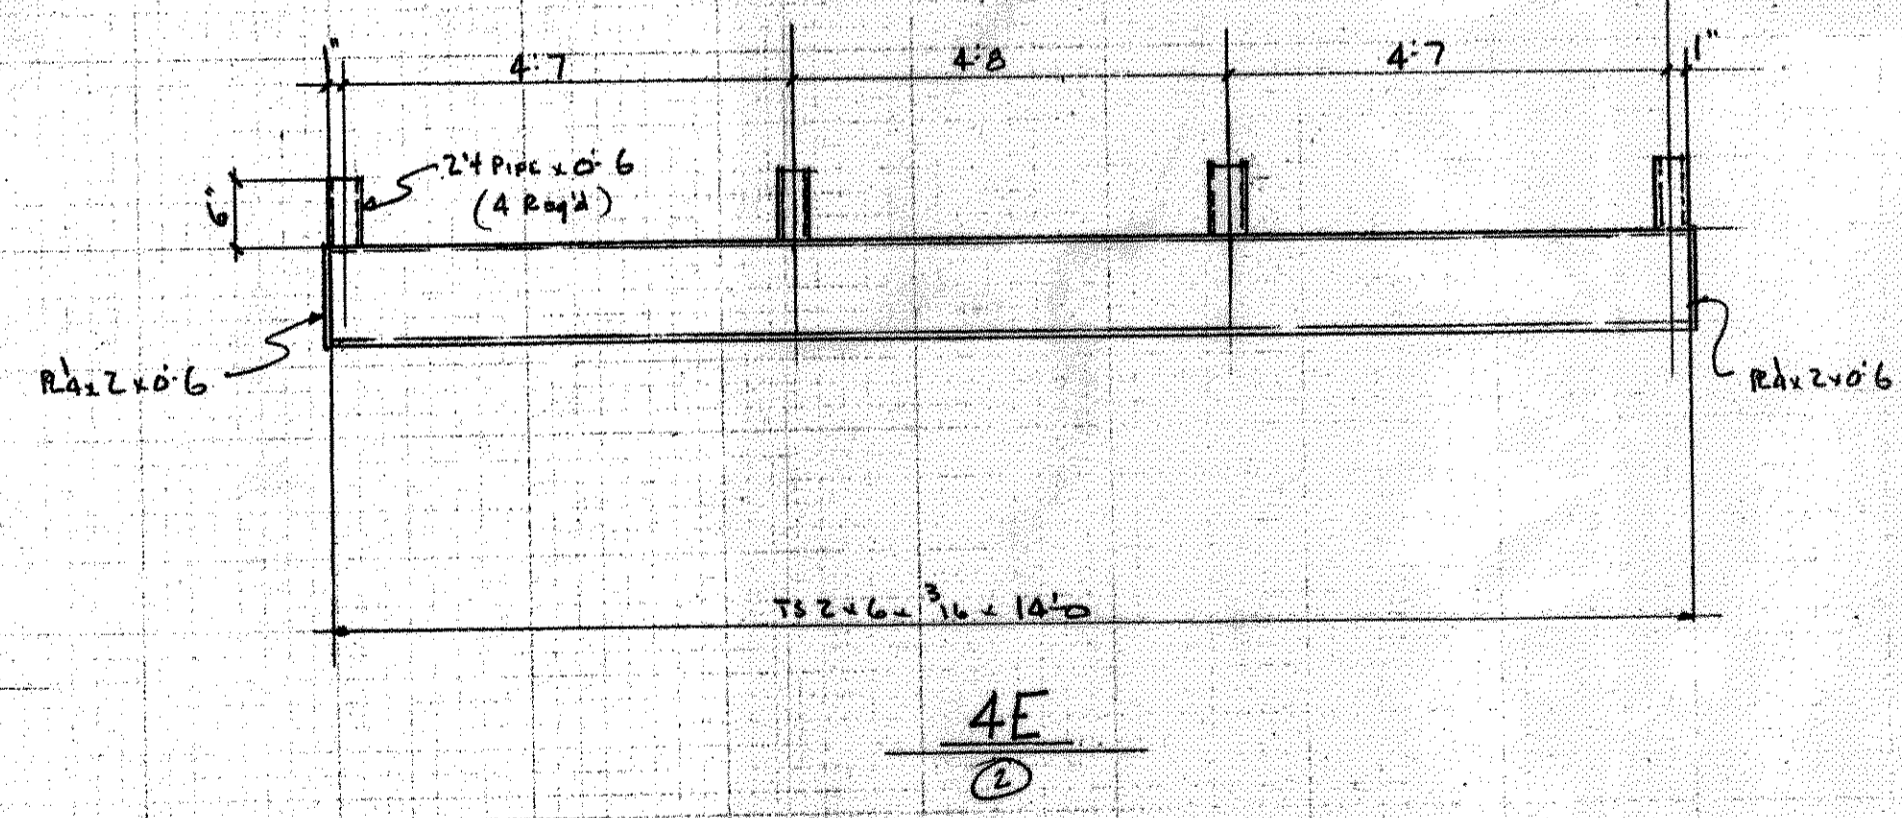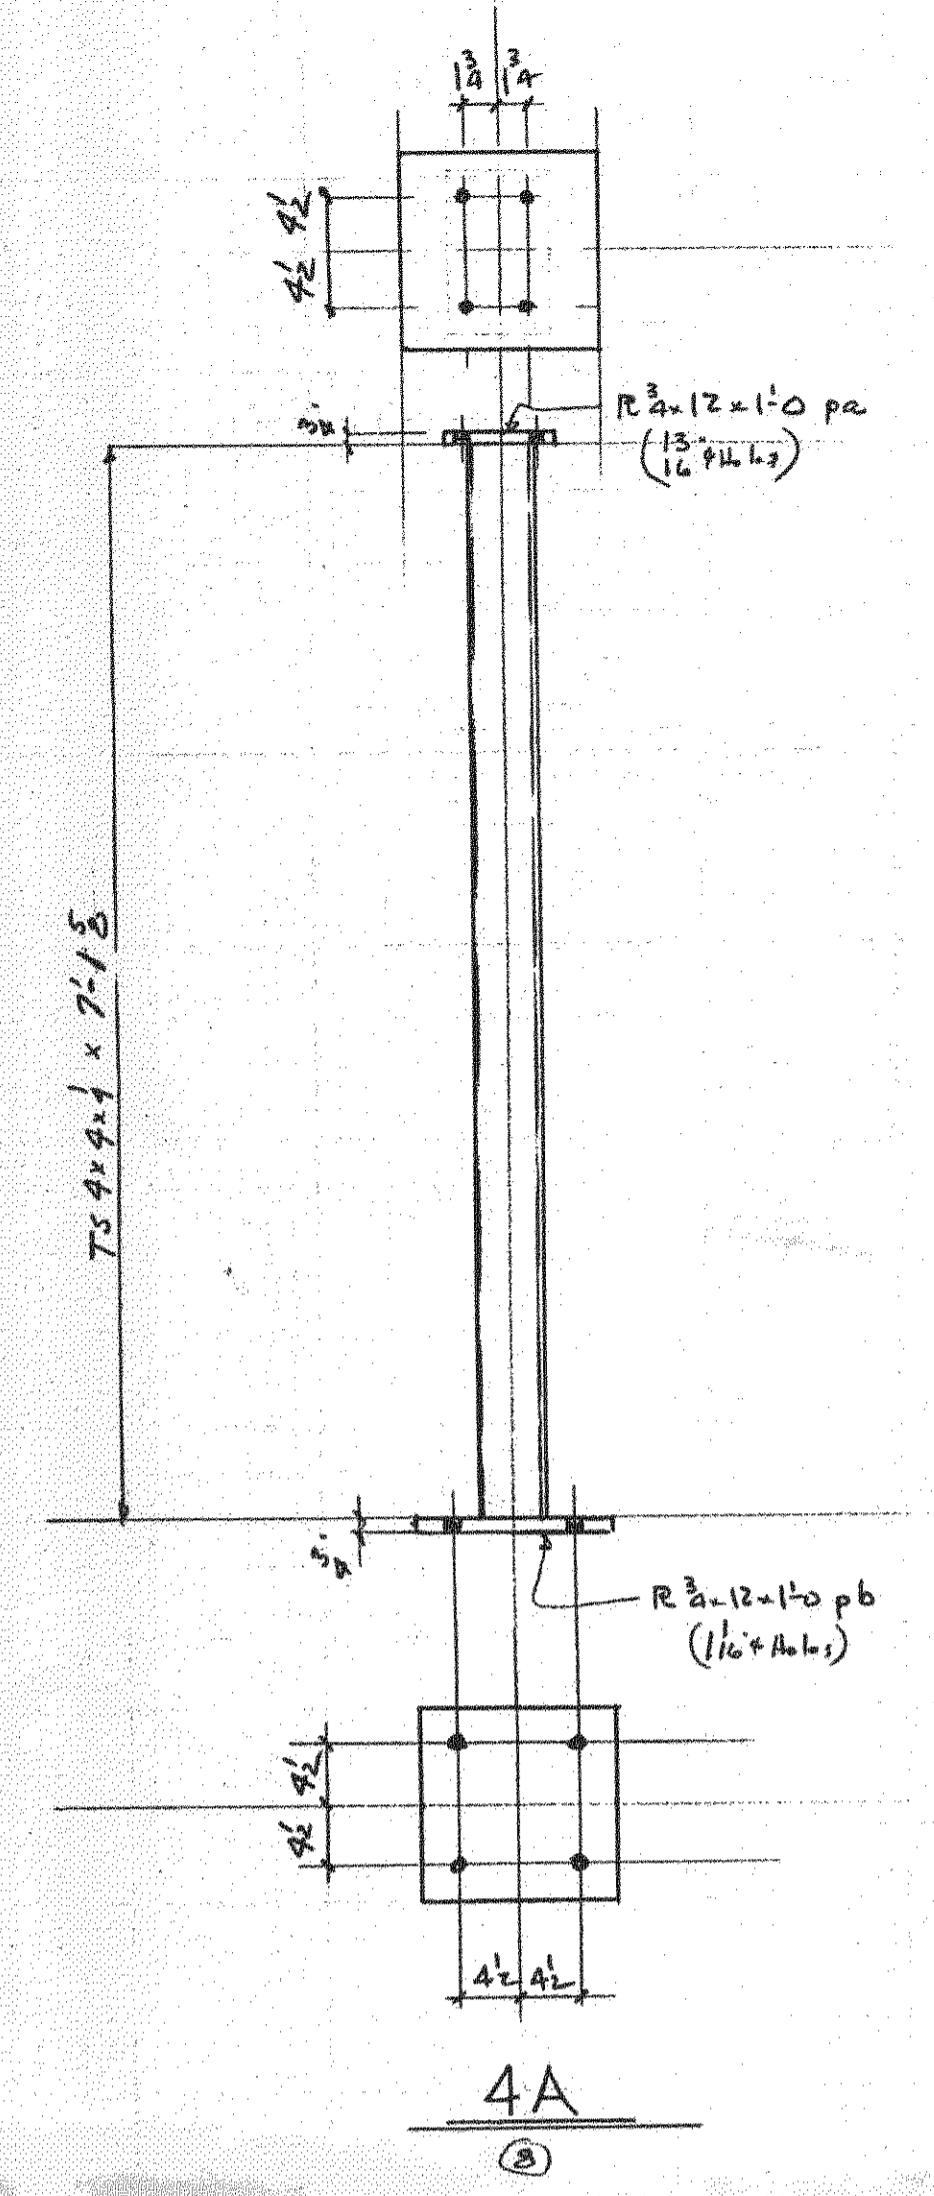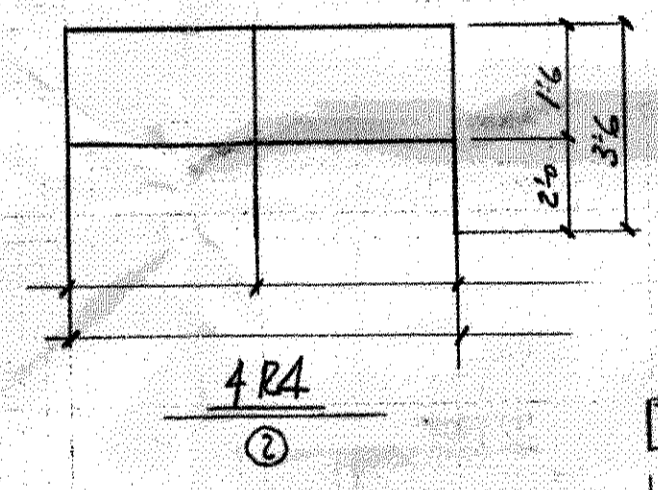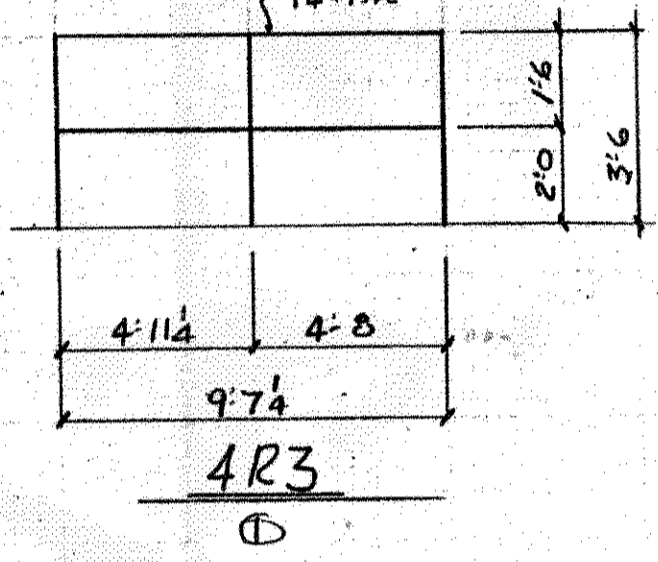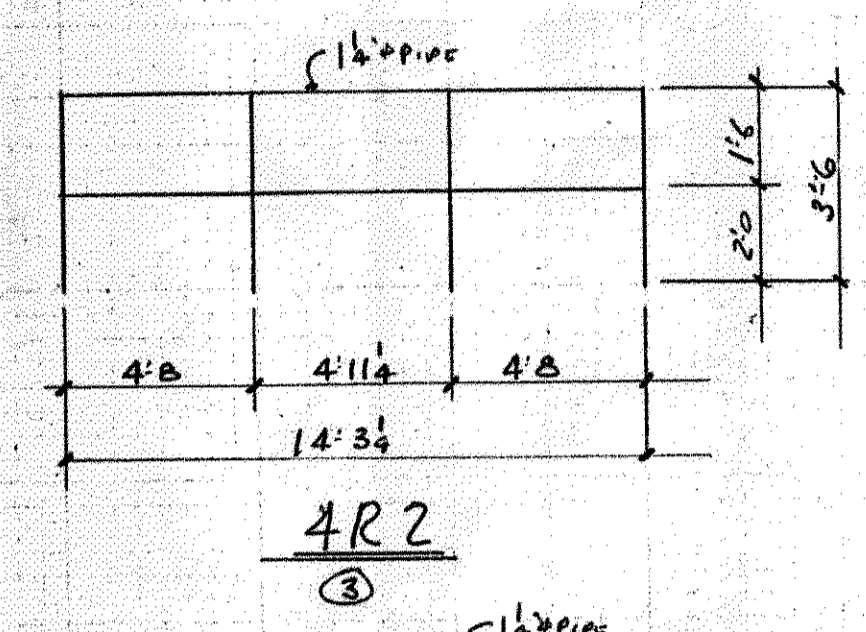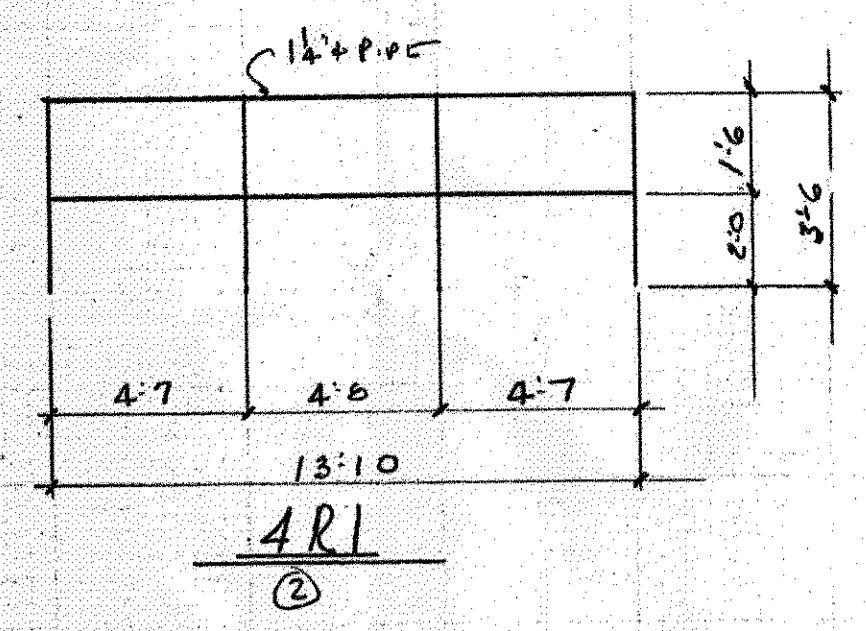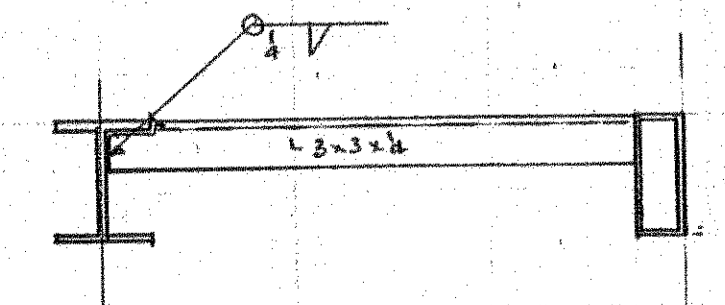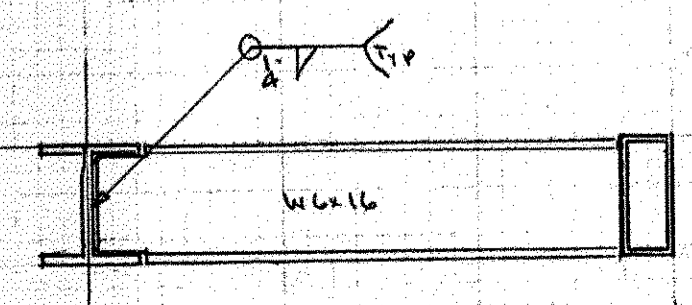

ALL MTL. TO BE GALVANIZED THIS SHEET

For Approval

STEEL SMITH INC  
 ST TAMMANY PARISH ADMIN COMPLEX  
 CONT: NATCO