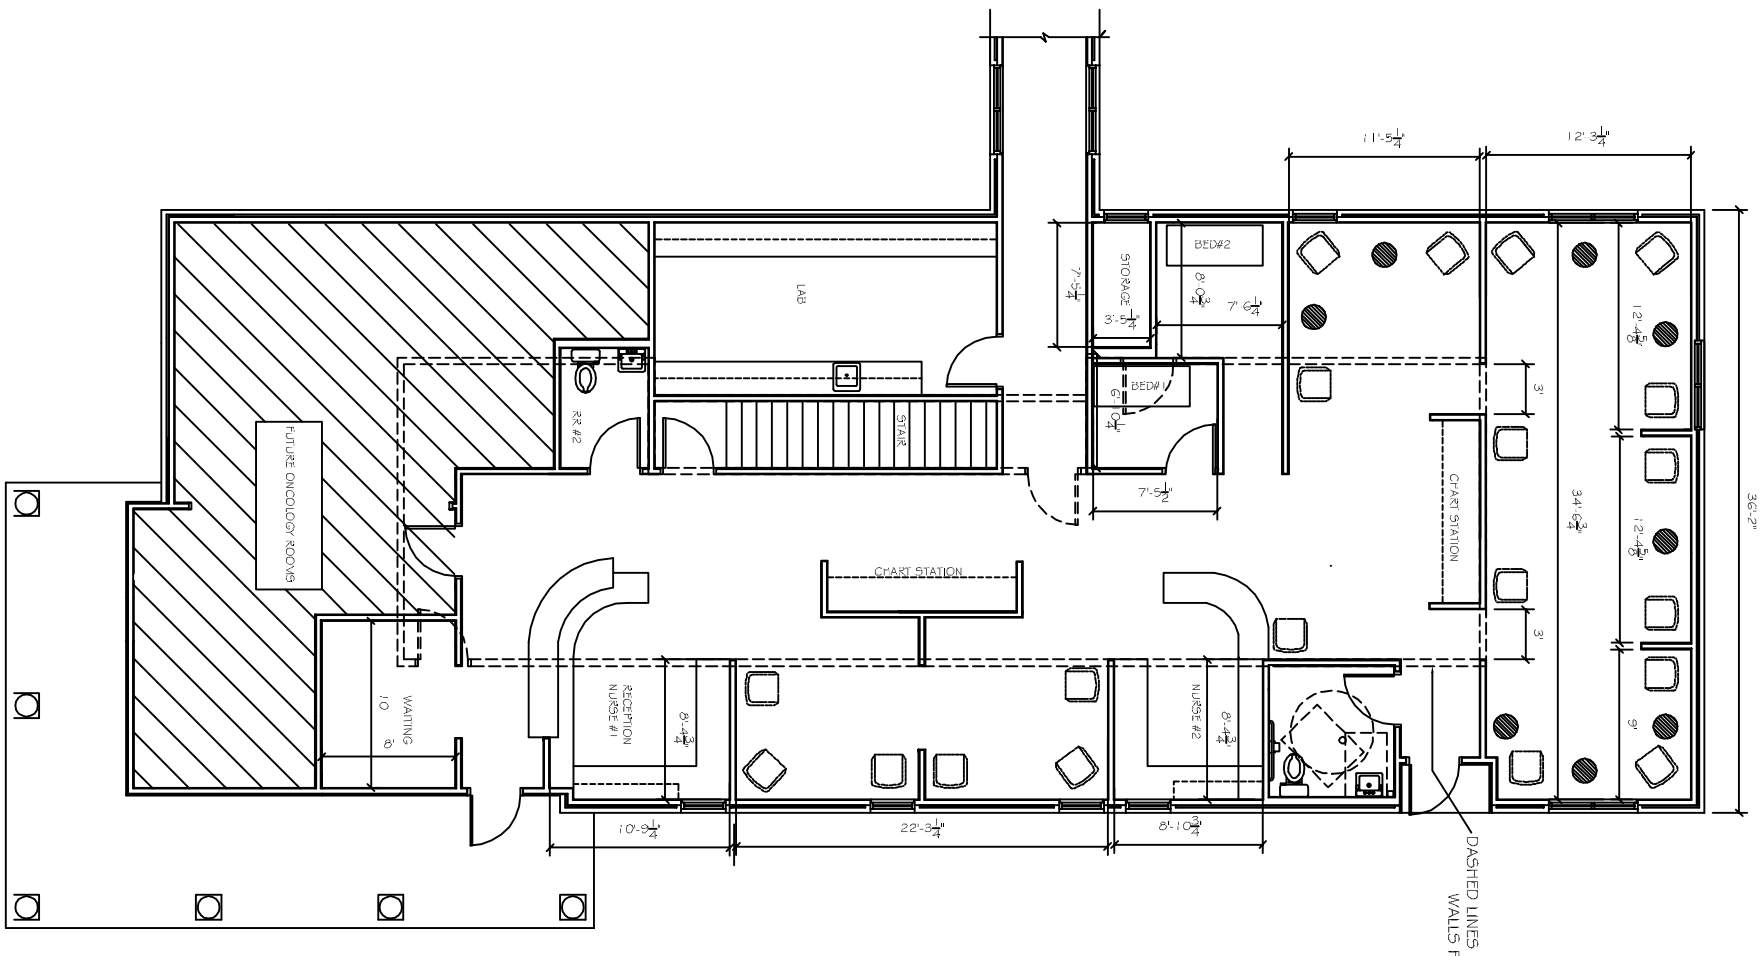

SHEET No:

FLOOR PLAN

REVISIONS

#	DESCRIPTION	DATE

MEDICAL ONCOLOGY,LLC

8119 PICARDY AVENUE
BATON ROUGE, LOUISIANA

JOB No:	DATE: 12-21-2012	
DRAWN BY: JCT	CHECKED BY: CD	

The above drawings and specifications, designs and arrangements represented thereby are and shall remain the property of Dammon Engineering, and no part thereof shall be copied, disclosed to others, or used in connection with any work or project other than the specific project for which they have been prepared and developed without written consent of Dammon Engineering. Visual contact with these drawings or specifications shall constitute conclusive evidence of acceptance of these restrictions.

DAMMON
ENGINEERING, INC.
Architects & Engineers

CHIEF ENGINEER: EMMETT DAMMON, P.E.
CHIEF ARCHITECT: KEVIN KINCHEN
5544 OLD SPANISH TRAIL
SLIDELL, LA 70458

dammonengineering.com
dammoneng@bellsouth.net
PHONE: 985-649-5832
FAX: 985-641-5950