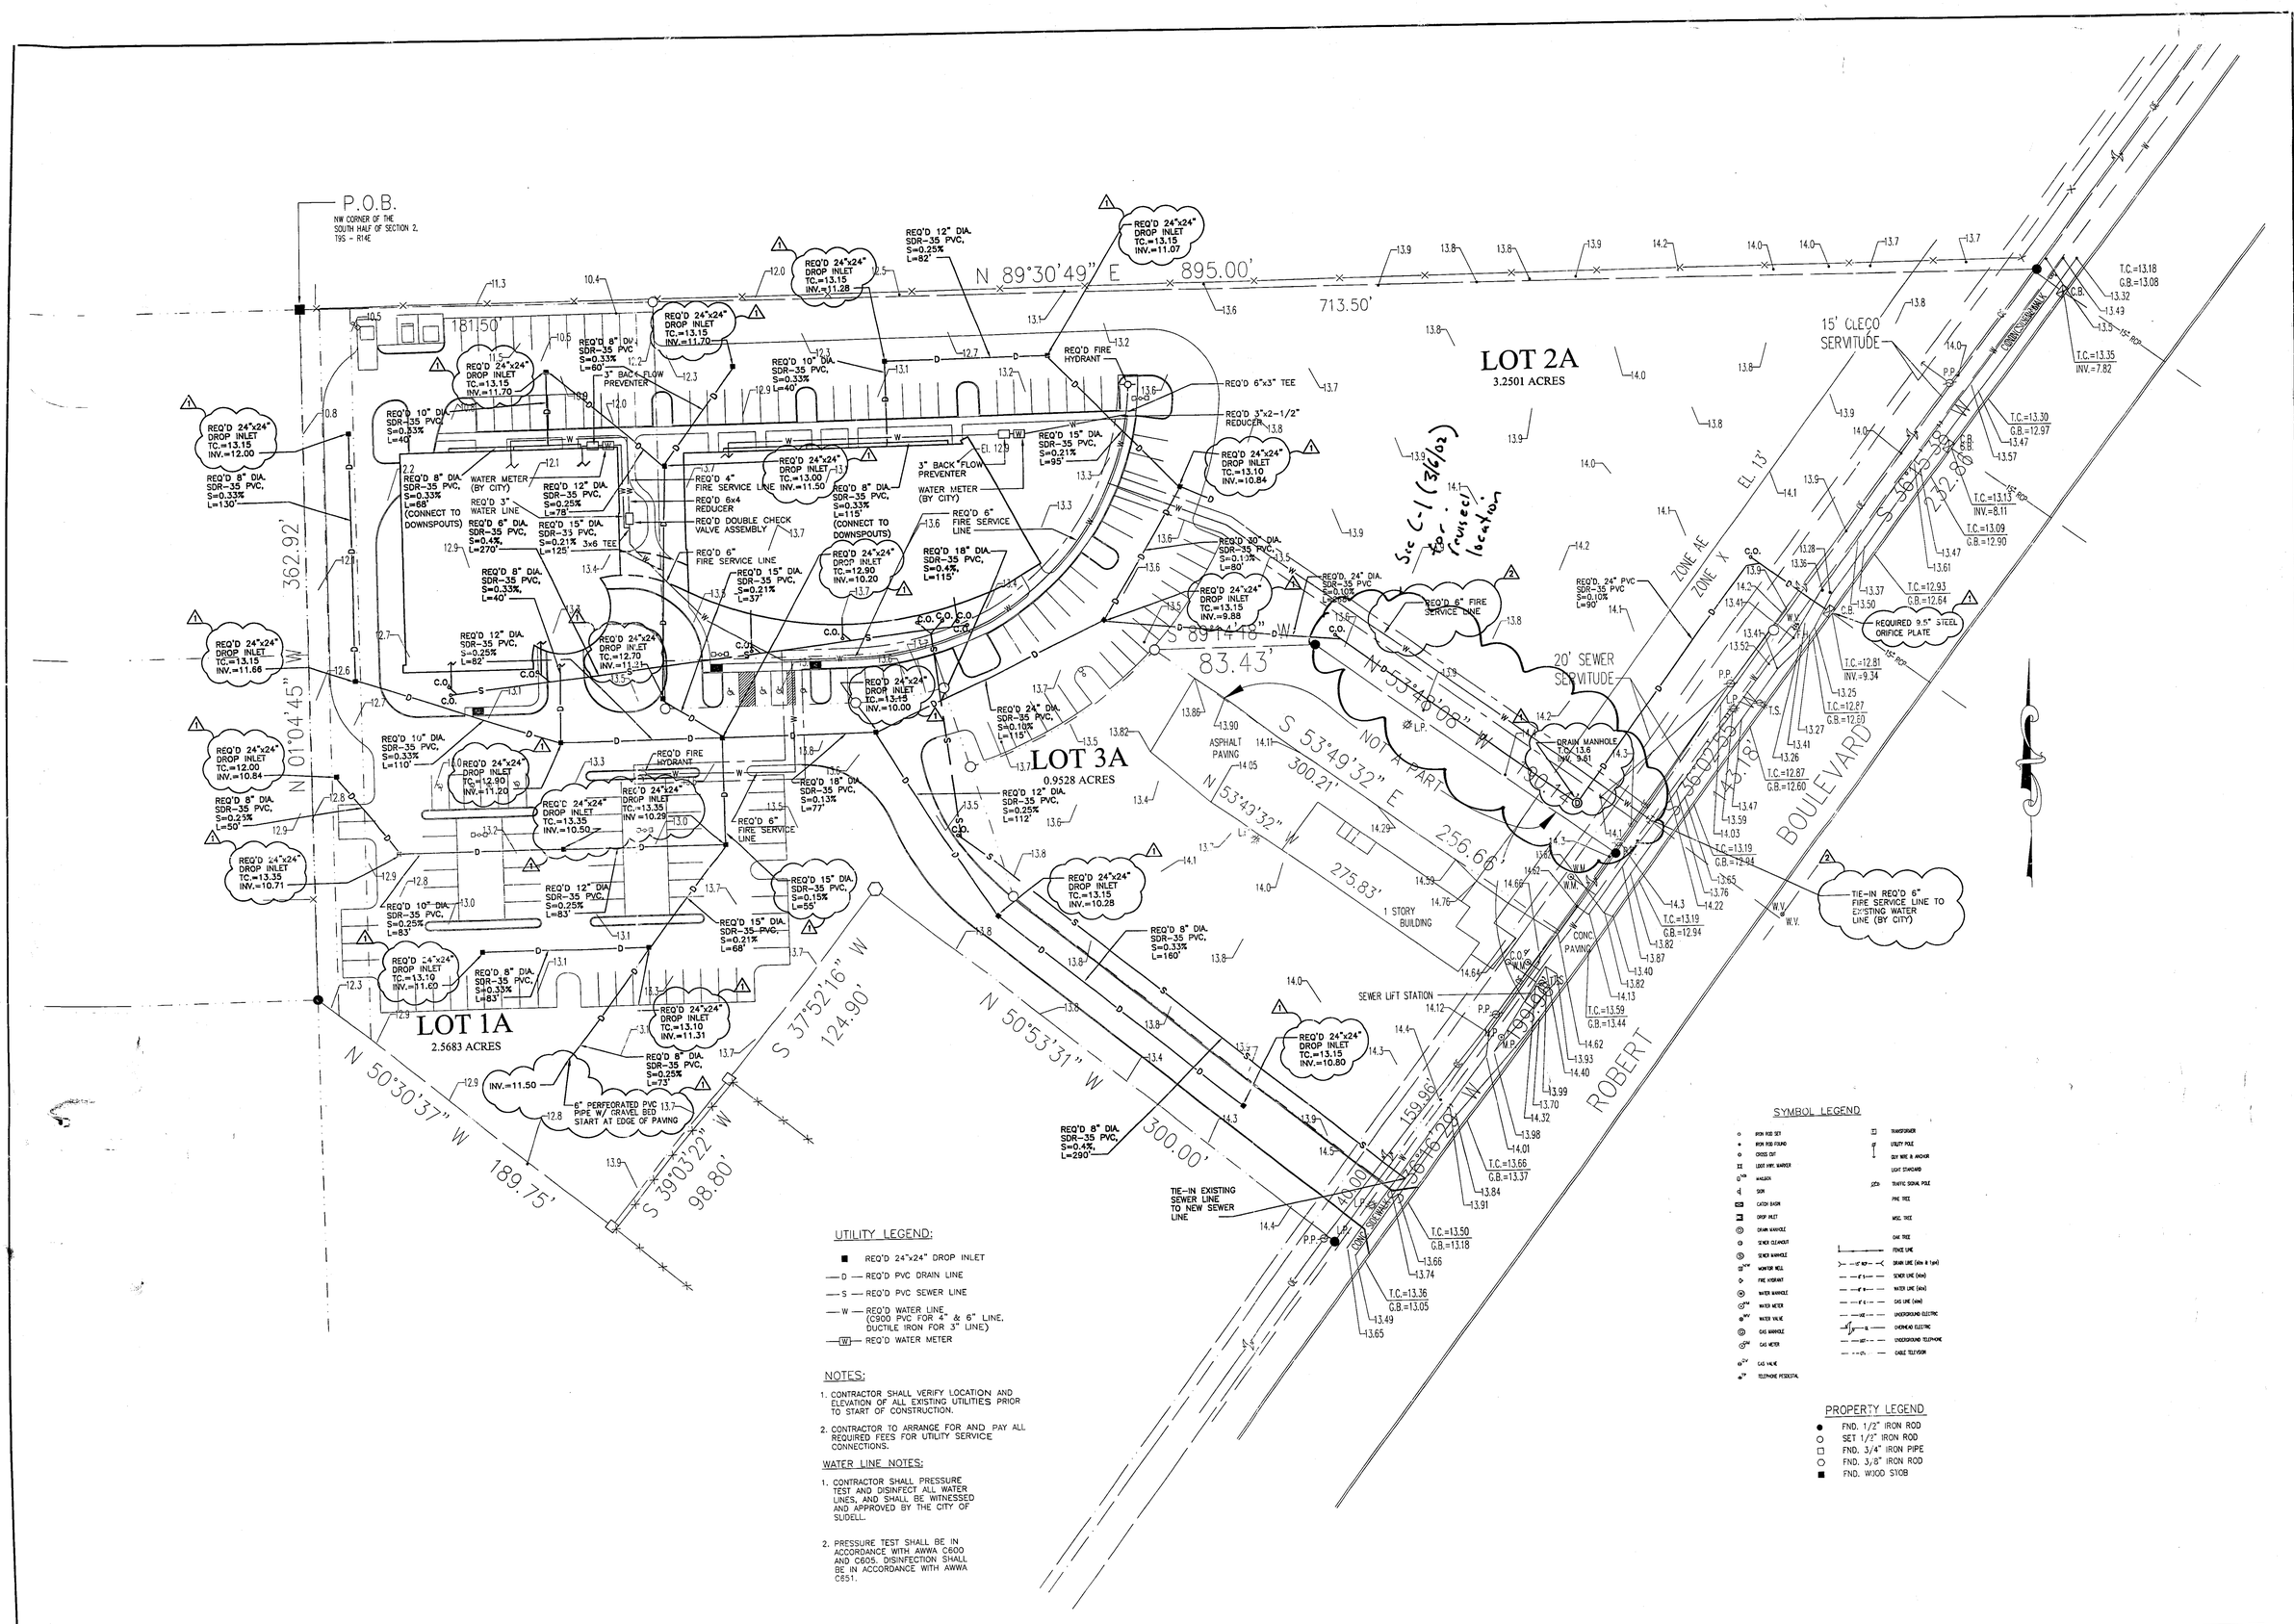

UTILITY LEGEND:

- REQ'D 24"x24" DROP INLET
- D — REQ'D PVC DRAIN LINE
- S — REQ'D PVC SEWER LINE
- W — REQ'D WATER LINE (C900 PVC FOR 4" & 6" LINE, DUCTILE IRON FOR 3" LINE)
- W — REQ'D WATER METER

NOTES:

1. CONTRACTOR SHALL VERIFY LOCATION AND ELEVATION OF ALL EXISTING UTILITIES PRIOR TO START OF CONSTRUCTION.
2. CONTRACTOR TO ARRANGE FOR AND PAY ALL REQUIRED FEES FOR UTILITY SERVICE CONNECTIONS.

WATER LINE NOTES:

1. CONTRACTOR SHALL PRESSURE TEST AND DISINFECT ALL WATER LINES, AND SHALL BE WITNESSED AND APPROVED BY THE CITY OF SLIDELL.
2. PRESSURE TEST SHALL BE IN ACCORDANCE WITH AWWA C600 AND C605. DISINFECTION SHALL BE IN ACCORDANCE WITH AWWA C651.

SYMBOL LEGEND

IRON ROD SET
IRON ROD FOUND
CROSS CUT
LOOP FIRE MARKER
MAILBOX
SIGN
CATCH BASIN
DROP INLET
DRAIN MANHOLE
SEWER CLEANOUT
SEWER MANHOLE
MONITOR WELL
FIRE HYDRANT
WATER MANHOLE
WATER METER
WATER VALVE
GAS MANHOLE
GAS METER
GAS VALVE
TELEPHONE PEDESTAL
TRANSFORMER
UTILITY POLE
GUY WIRE & ANCHOR
LIGHT STANDARD
TRAFFIC SIGNAL POLE
PINE TREE
MISC. TREE
OAK TREE
FENCE LINE
DRAIN LINE (dia & type)
SEWER LINE (dia)
WATER LINE (dia)
GAS LINE (dia)
UNDERGROUND ELECTRIC
OVERHEAD ELECTRIC
UNDERGROUND TELEPHONE
CABLE TELEVISION

PROPERTY LEGEND

- FND. 1/2" IRON ROD
- SET 1/2" IRON ROD
- FND. 3/4" IRON PIPE
- FND. 3/8" IRON ROD
- FND. WOOD STOB

N — 1 / C1.3 — UTILITY PLAN
SCALE: 1" = 30'-0"

Date: MARCH 6, 2002
Drawn By: [illegible]
Checked By: [illegible]
Revisions: 03.27.02
04.30.02
Project Number: [illegible]

This drawing is the property of ROZAS+WARD a professional corporation, and is not to be reproduced or copied in whole or in part. It is only to be used for the project and site specifically identified hereon.

Scales as noted hereon are valid on the original drawing only.

ROZAS · WARD a.i.a. architects
a professional corporation
1018 Common Street · Suite 2760 · New Orleans · Louisiana 70112 · (504)524-4376

Doctors Hospital of Slidell
Slidell, Louisiana

CARESBA ENGINEERING
Project [illegible]-042
1018 Central Avenue
Metairie, LA 70001
Ph: (504) [illegible]-1490
Fax: (504) 888-1491

C1.3R
drawing utility plan
set no.