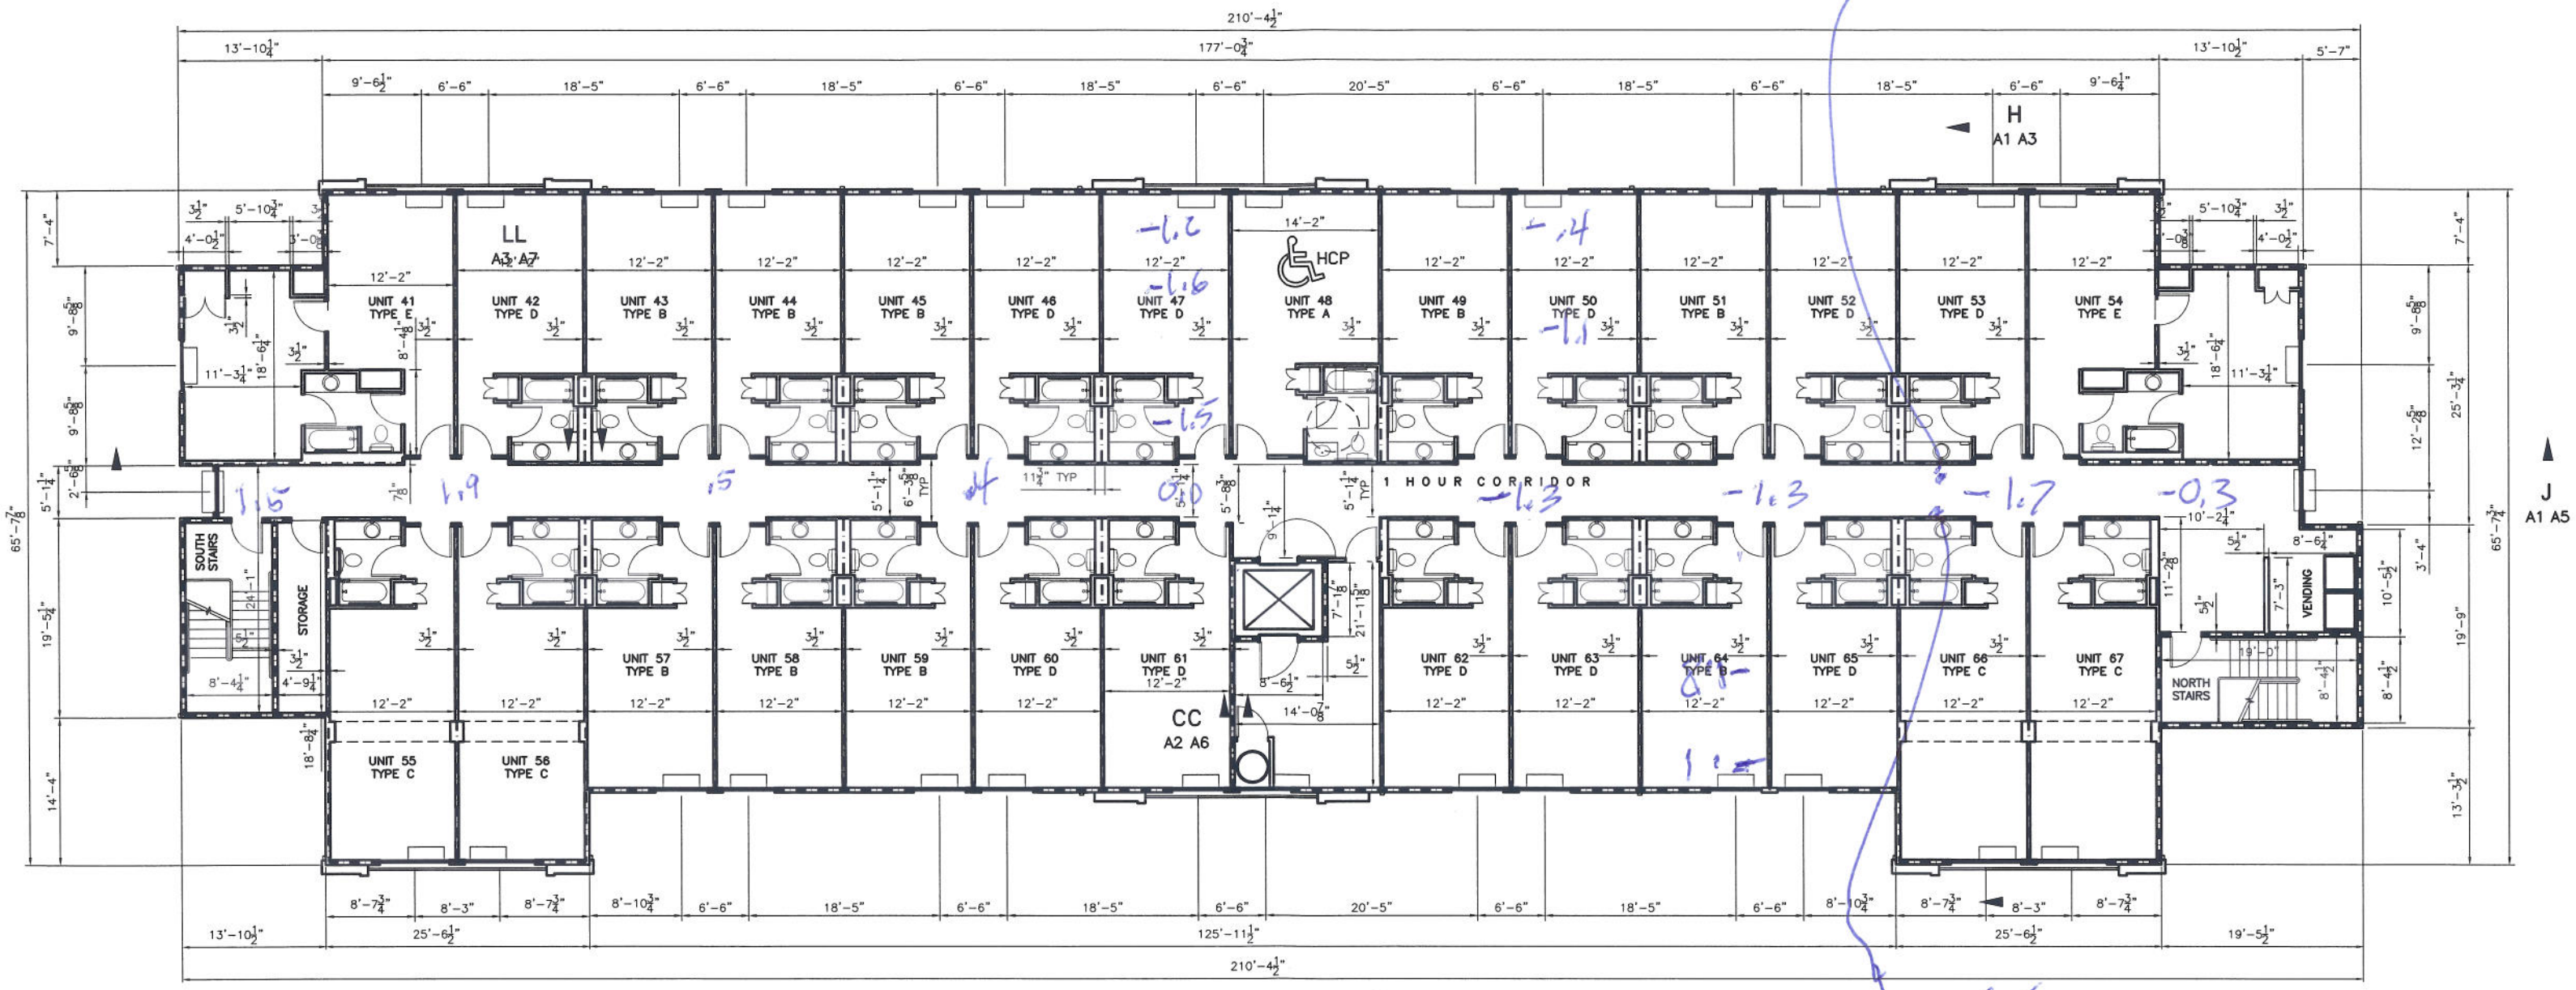

THIRD FLOOR PLAN
SCALE: 1/8"=1'-0"

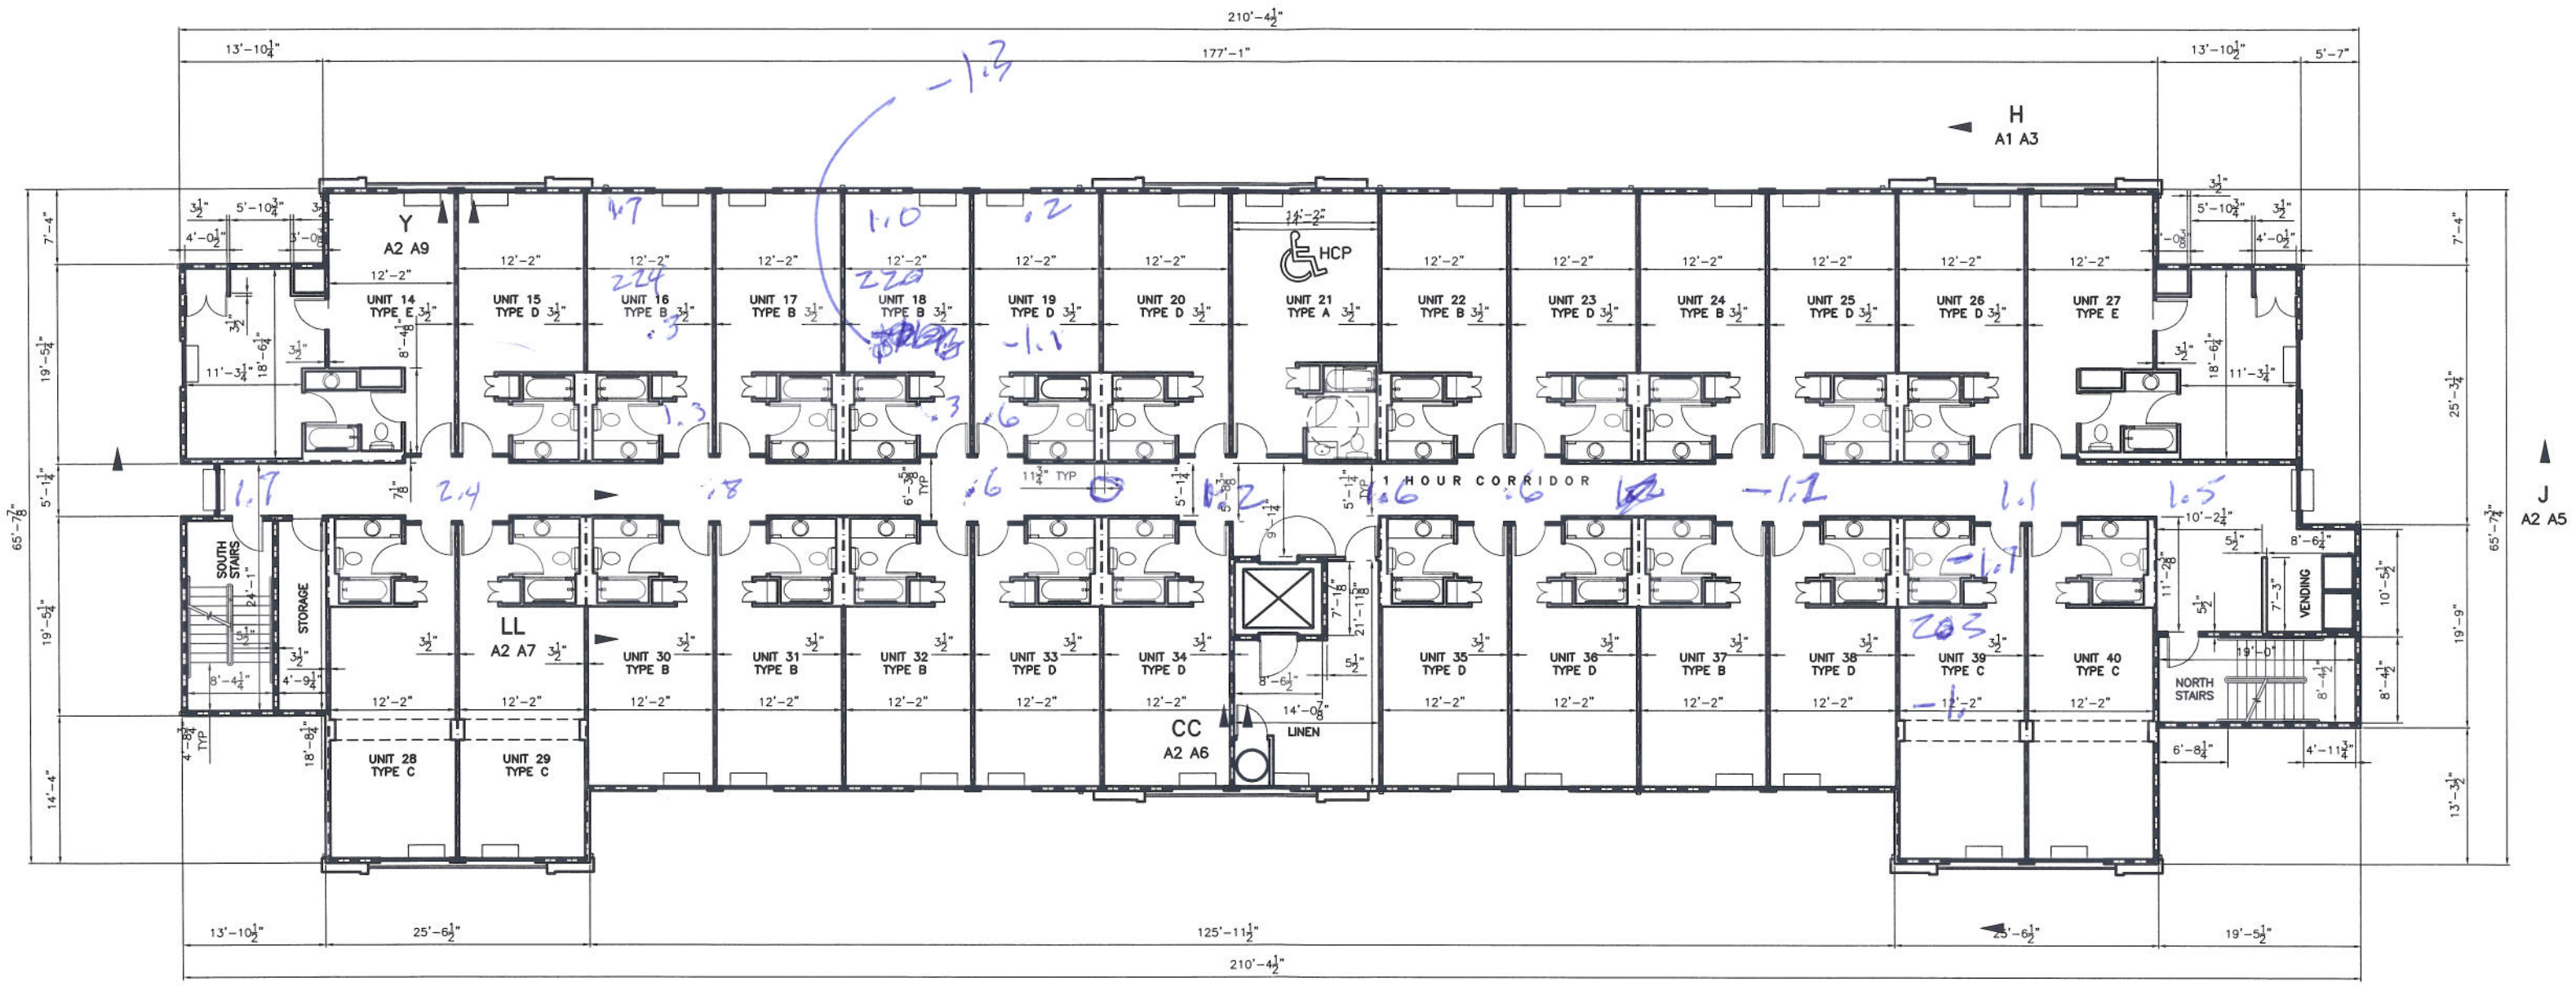

SECOND FLOOR PLAN
SCALE: 1/8"=1'-0"

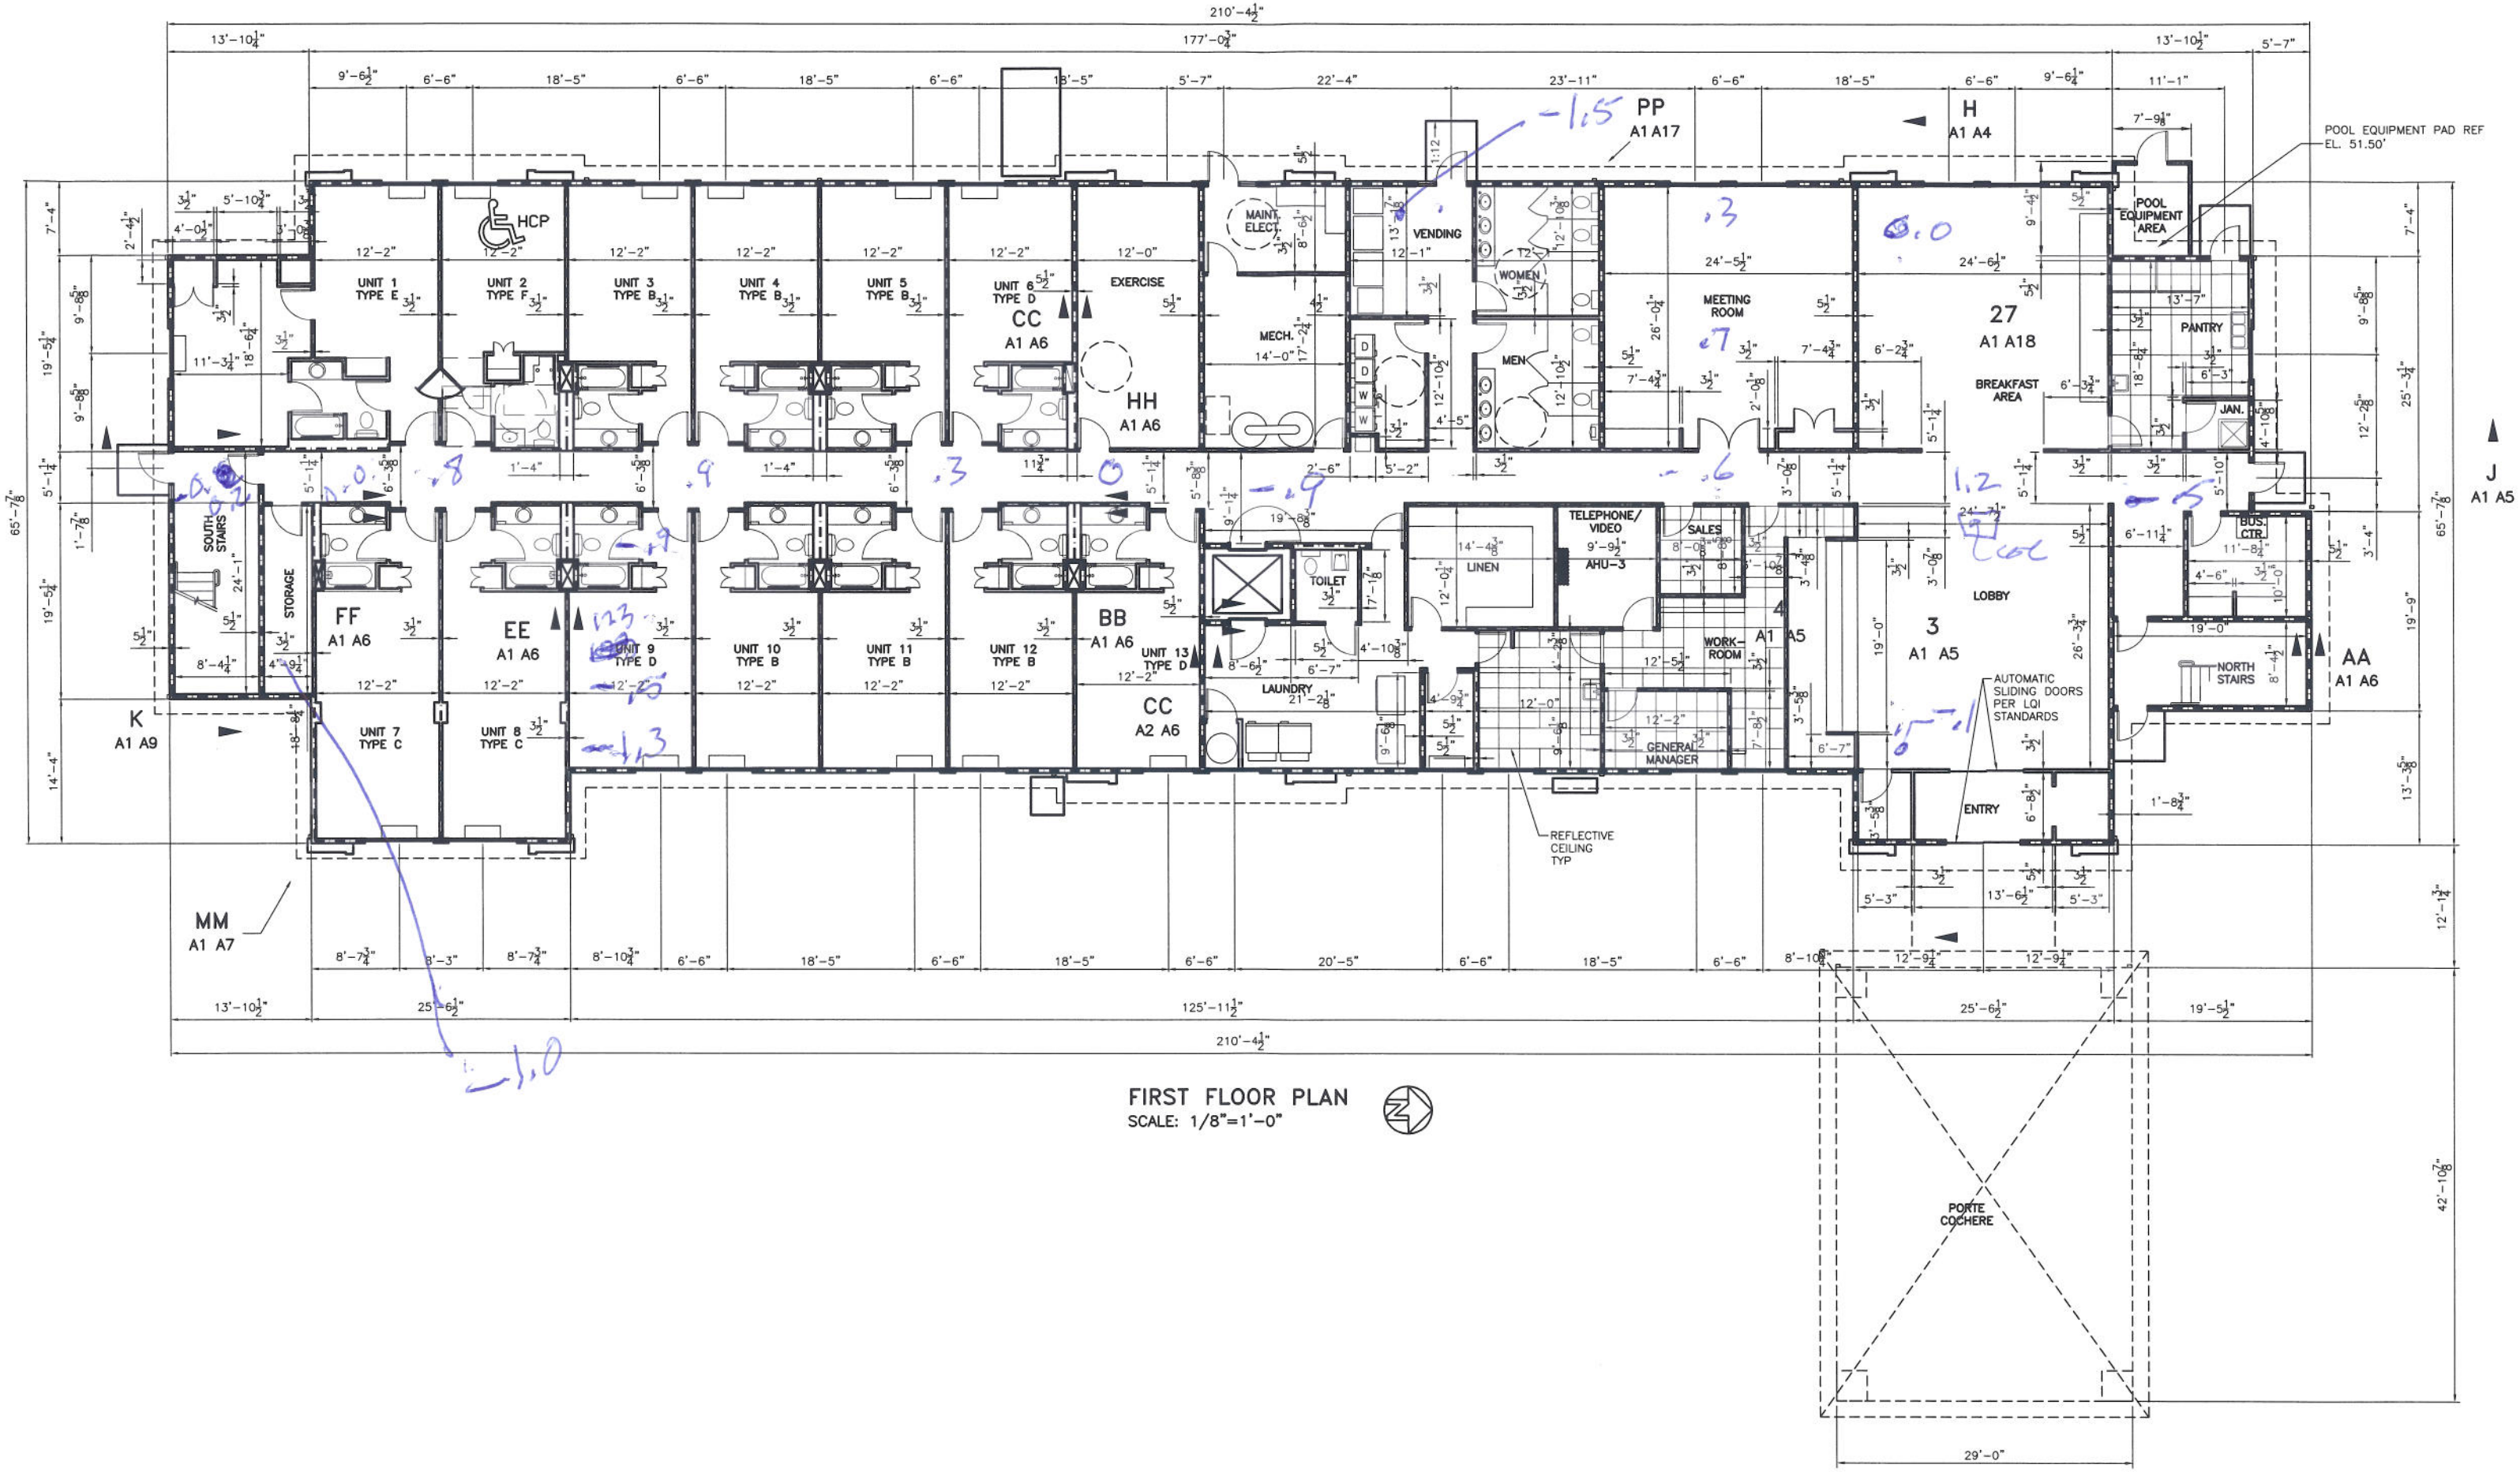

FIRST FLOOR PLAN
SCALE: 1/8"=1'-0"