



NO. 1	NO. 2	
-------	-------	-------	-------	-------	-------	-------	-------	-------	--------	--------	---------

ALL ELECTRICAL SYMBOLS AND NOTATION TO BE THE SAME AS SHOWN ON SHEET E-1.

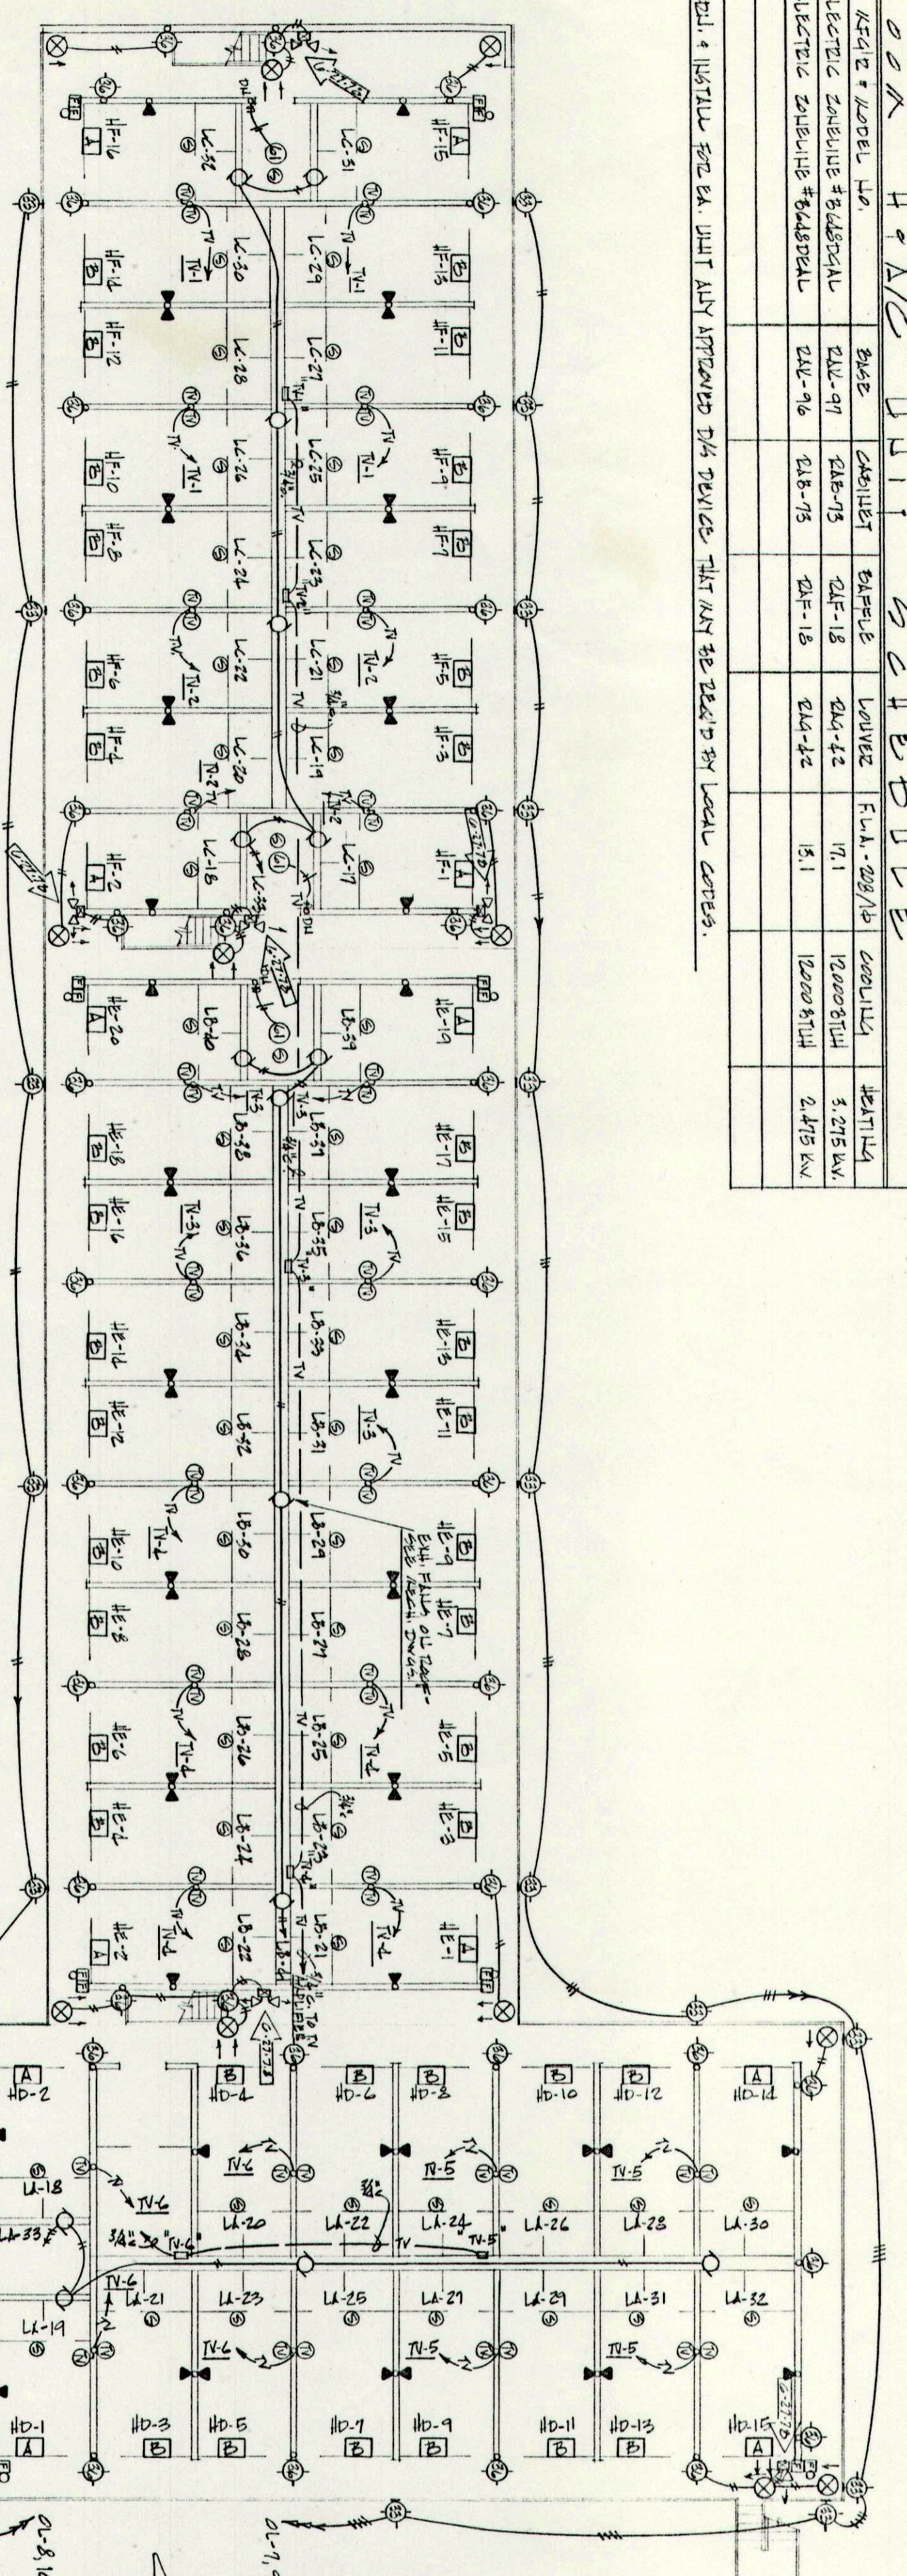


SECOND FLOOR PLAN

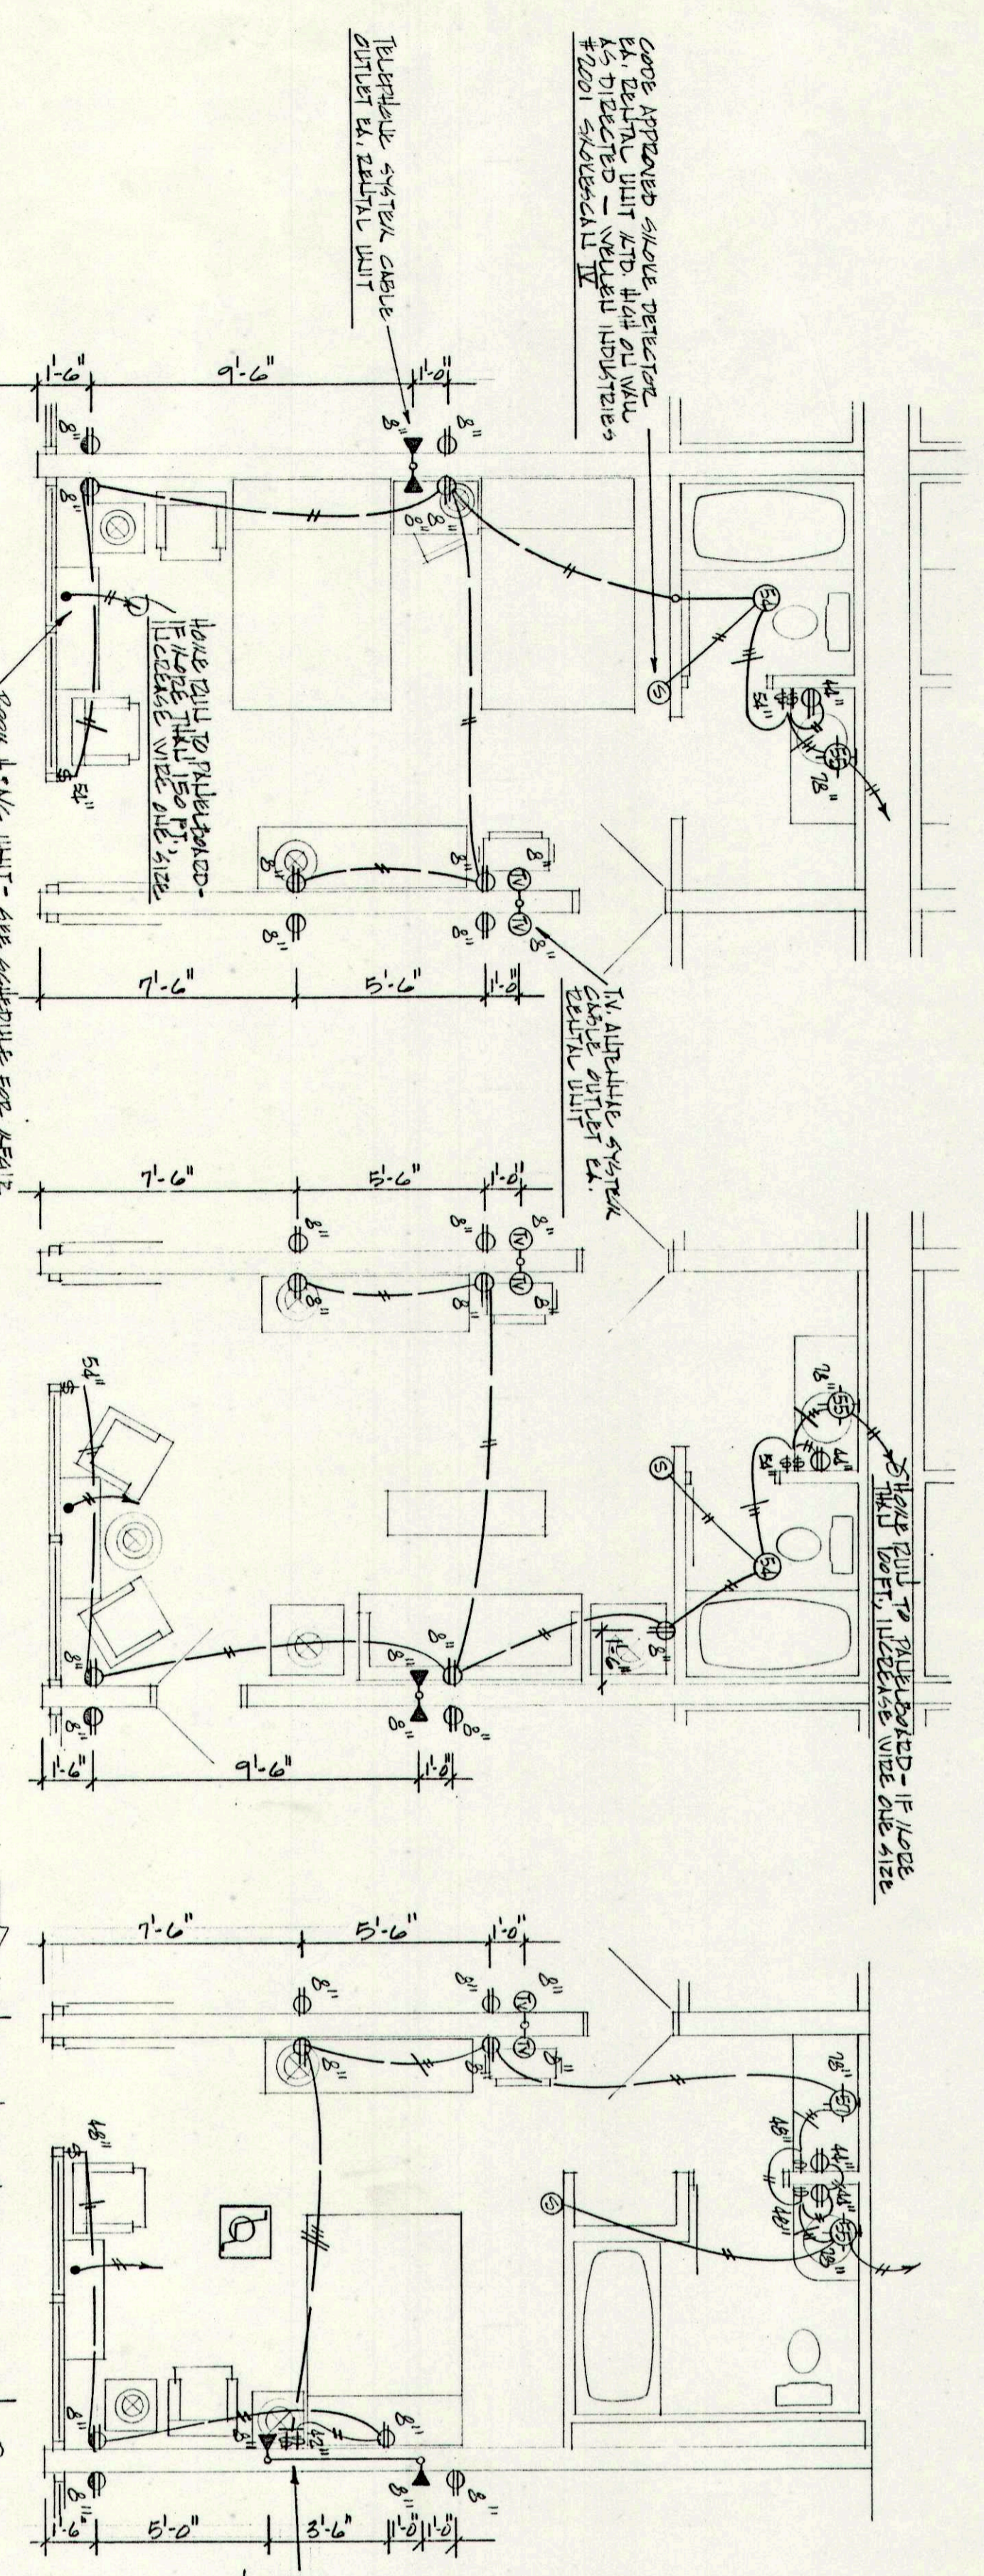


TYPICAL DOUBLE ROOM

TYPICAL LIVING ROOM

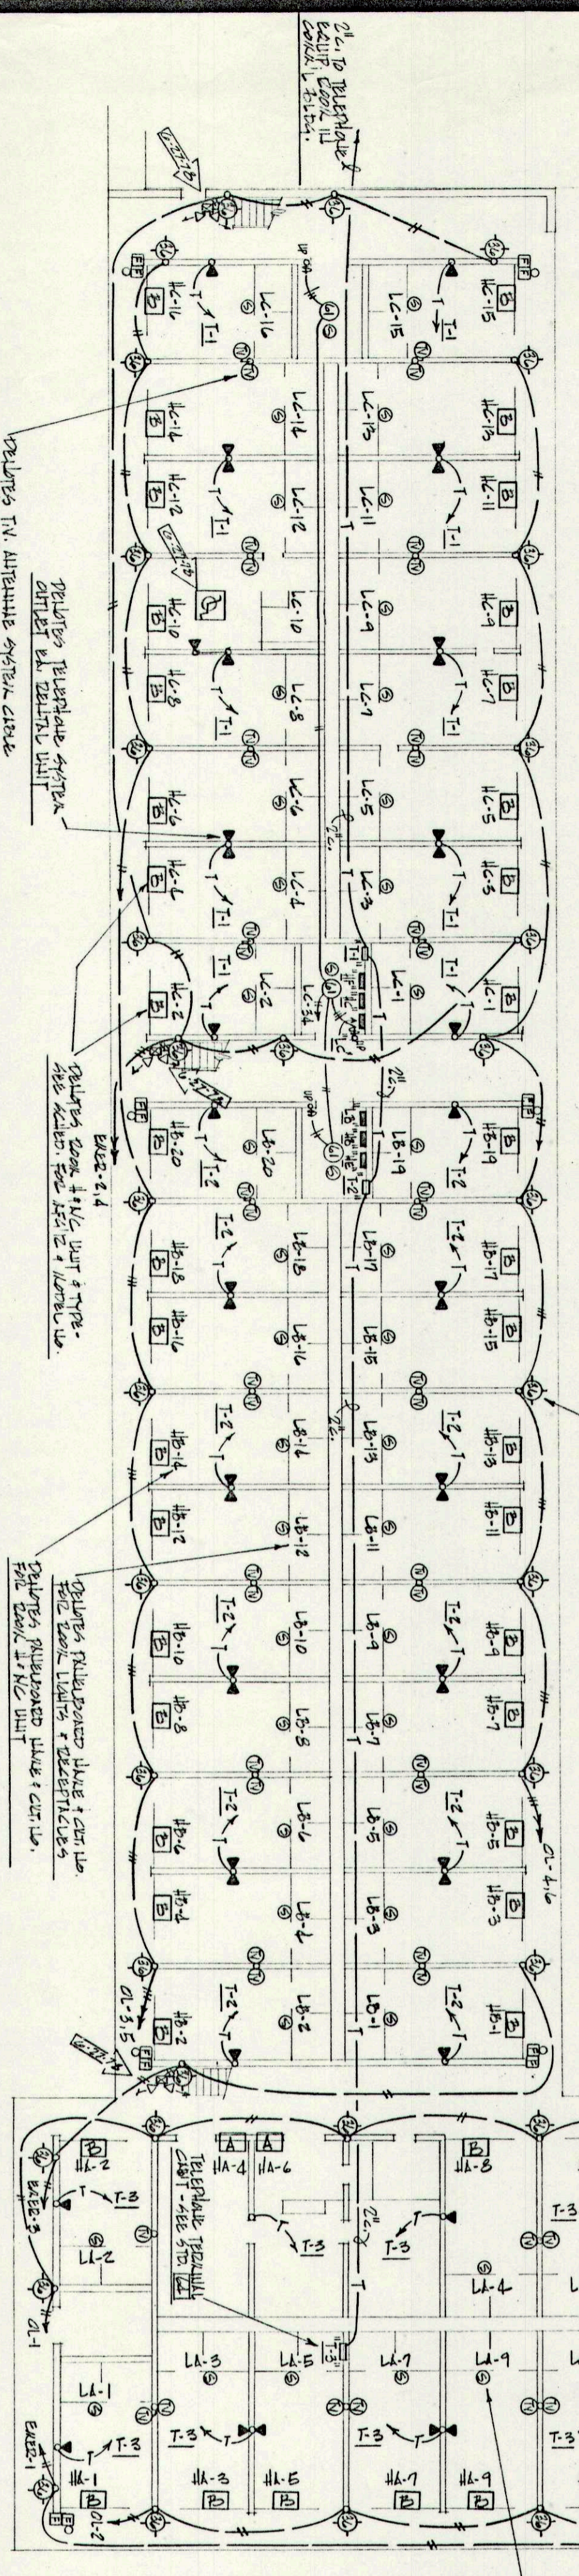


GROUND FLOOR PLAN

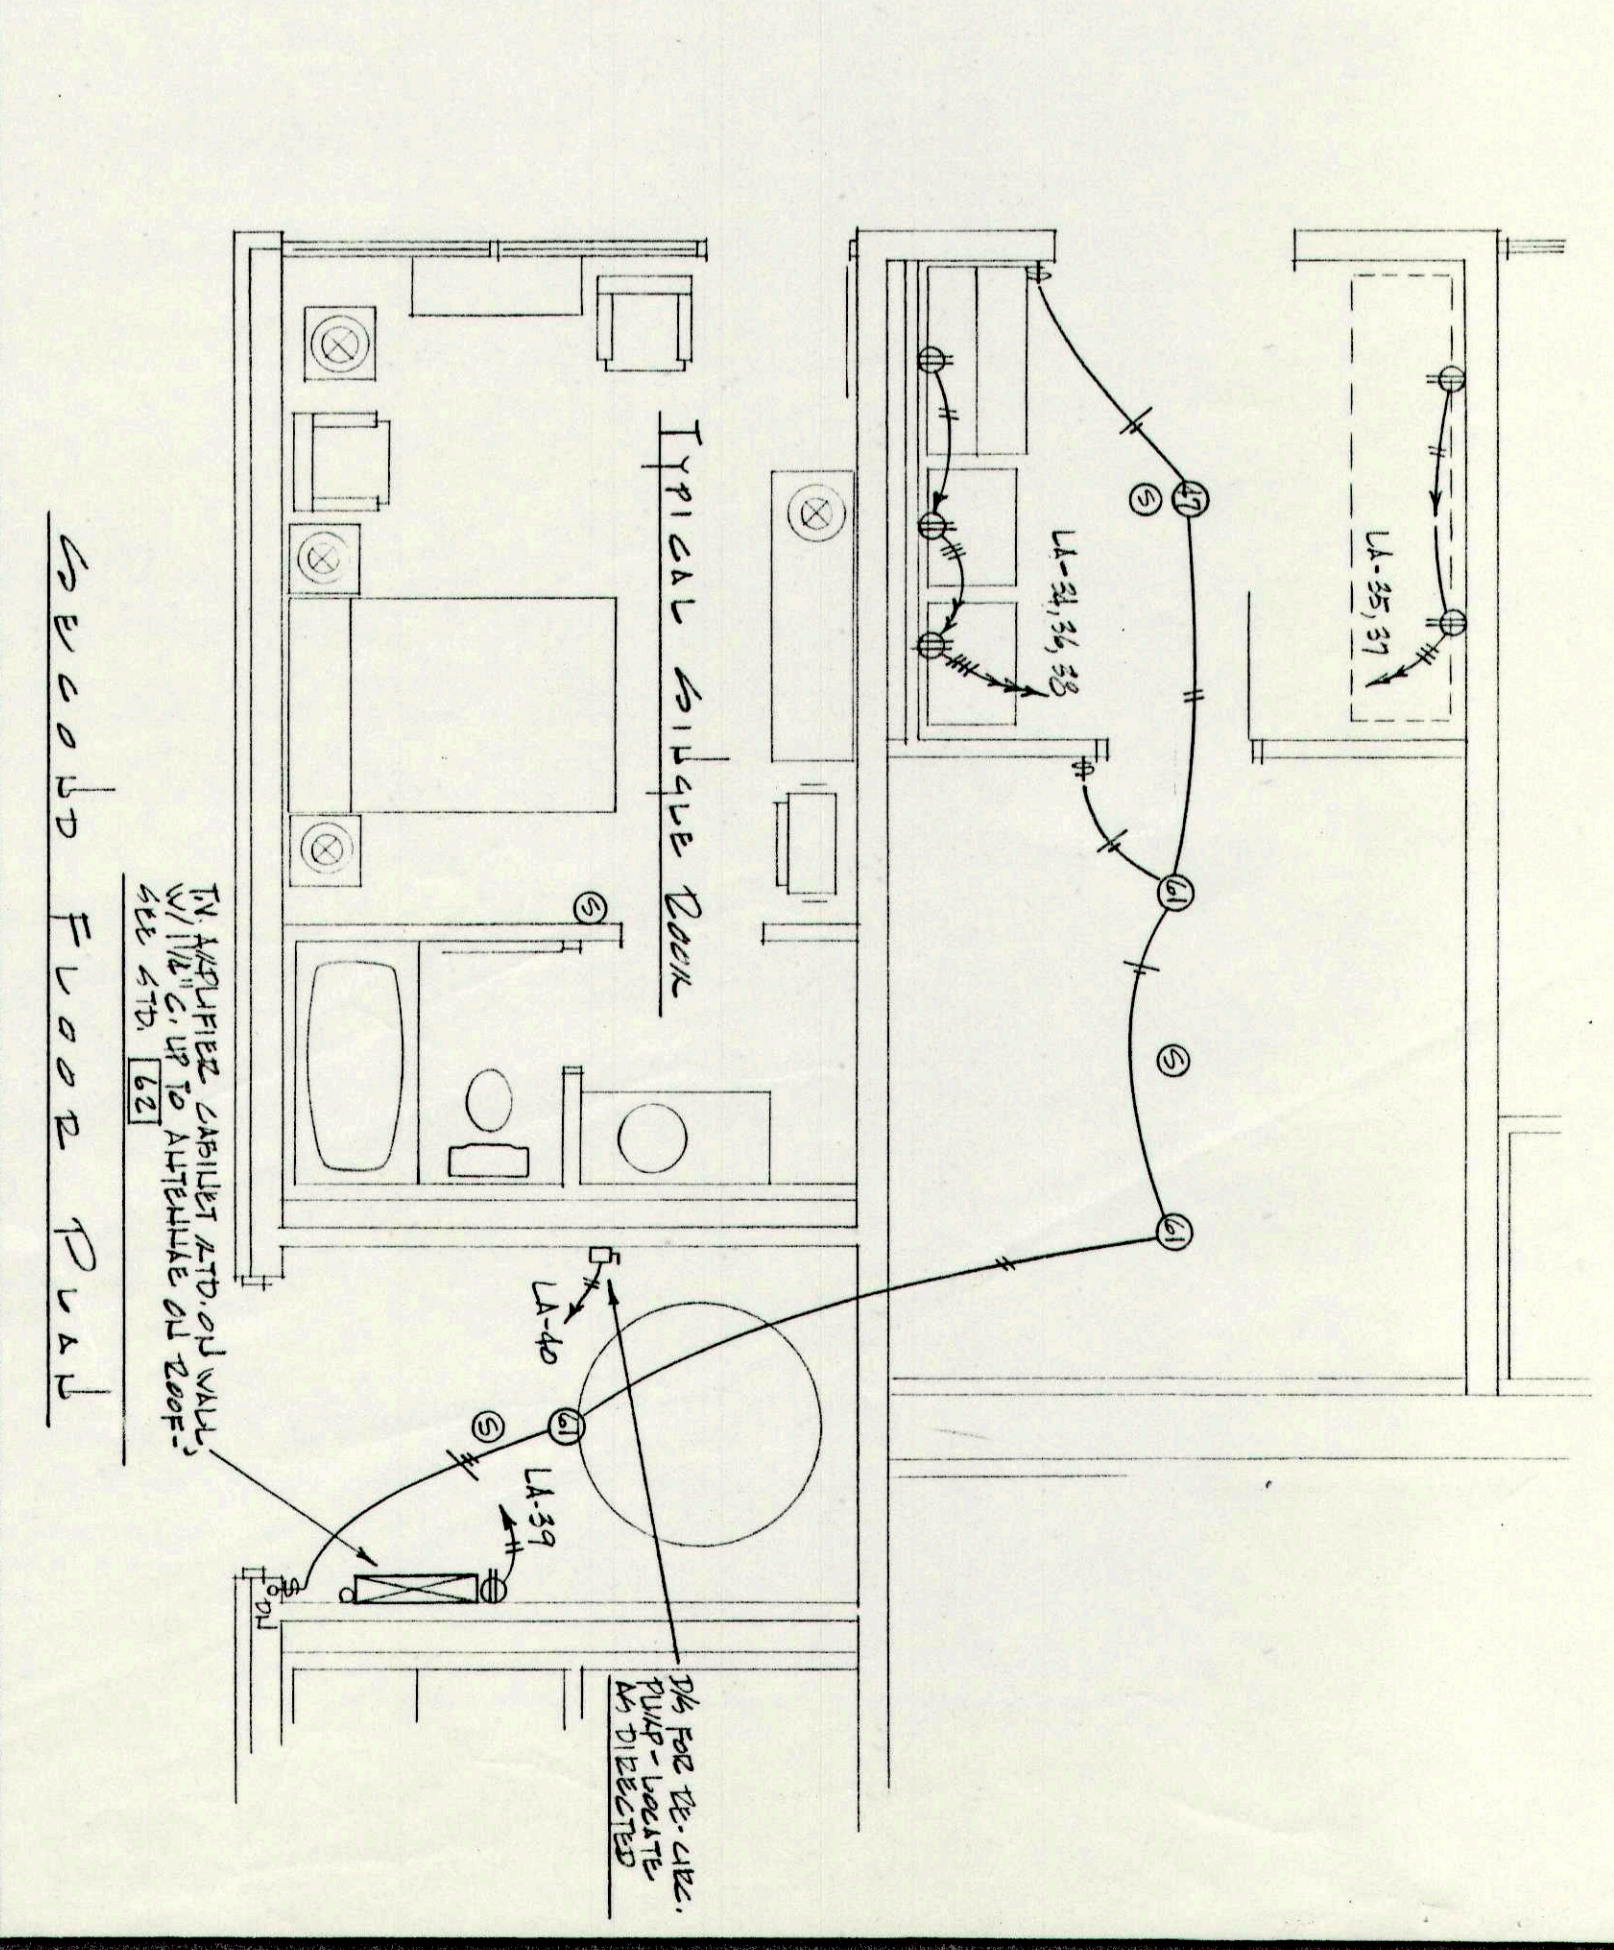

TYPICAL DOUBLE ROOM

SECOND FLOOR PLAN

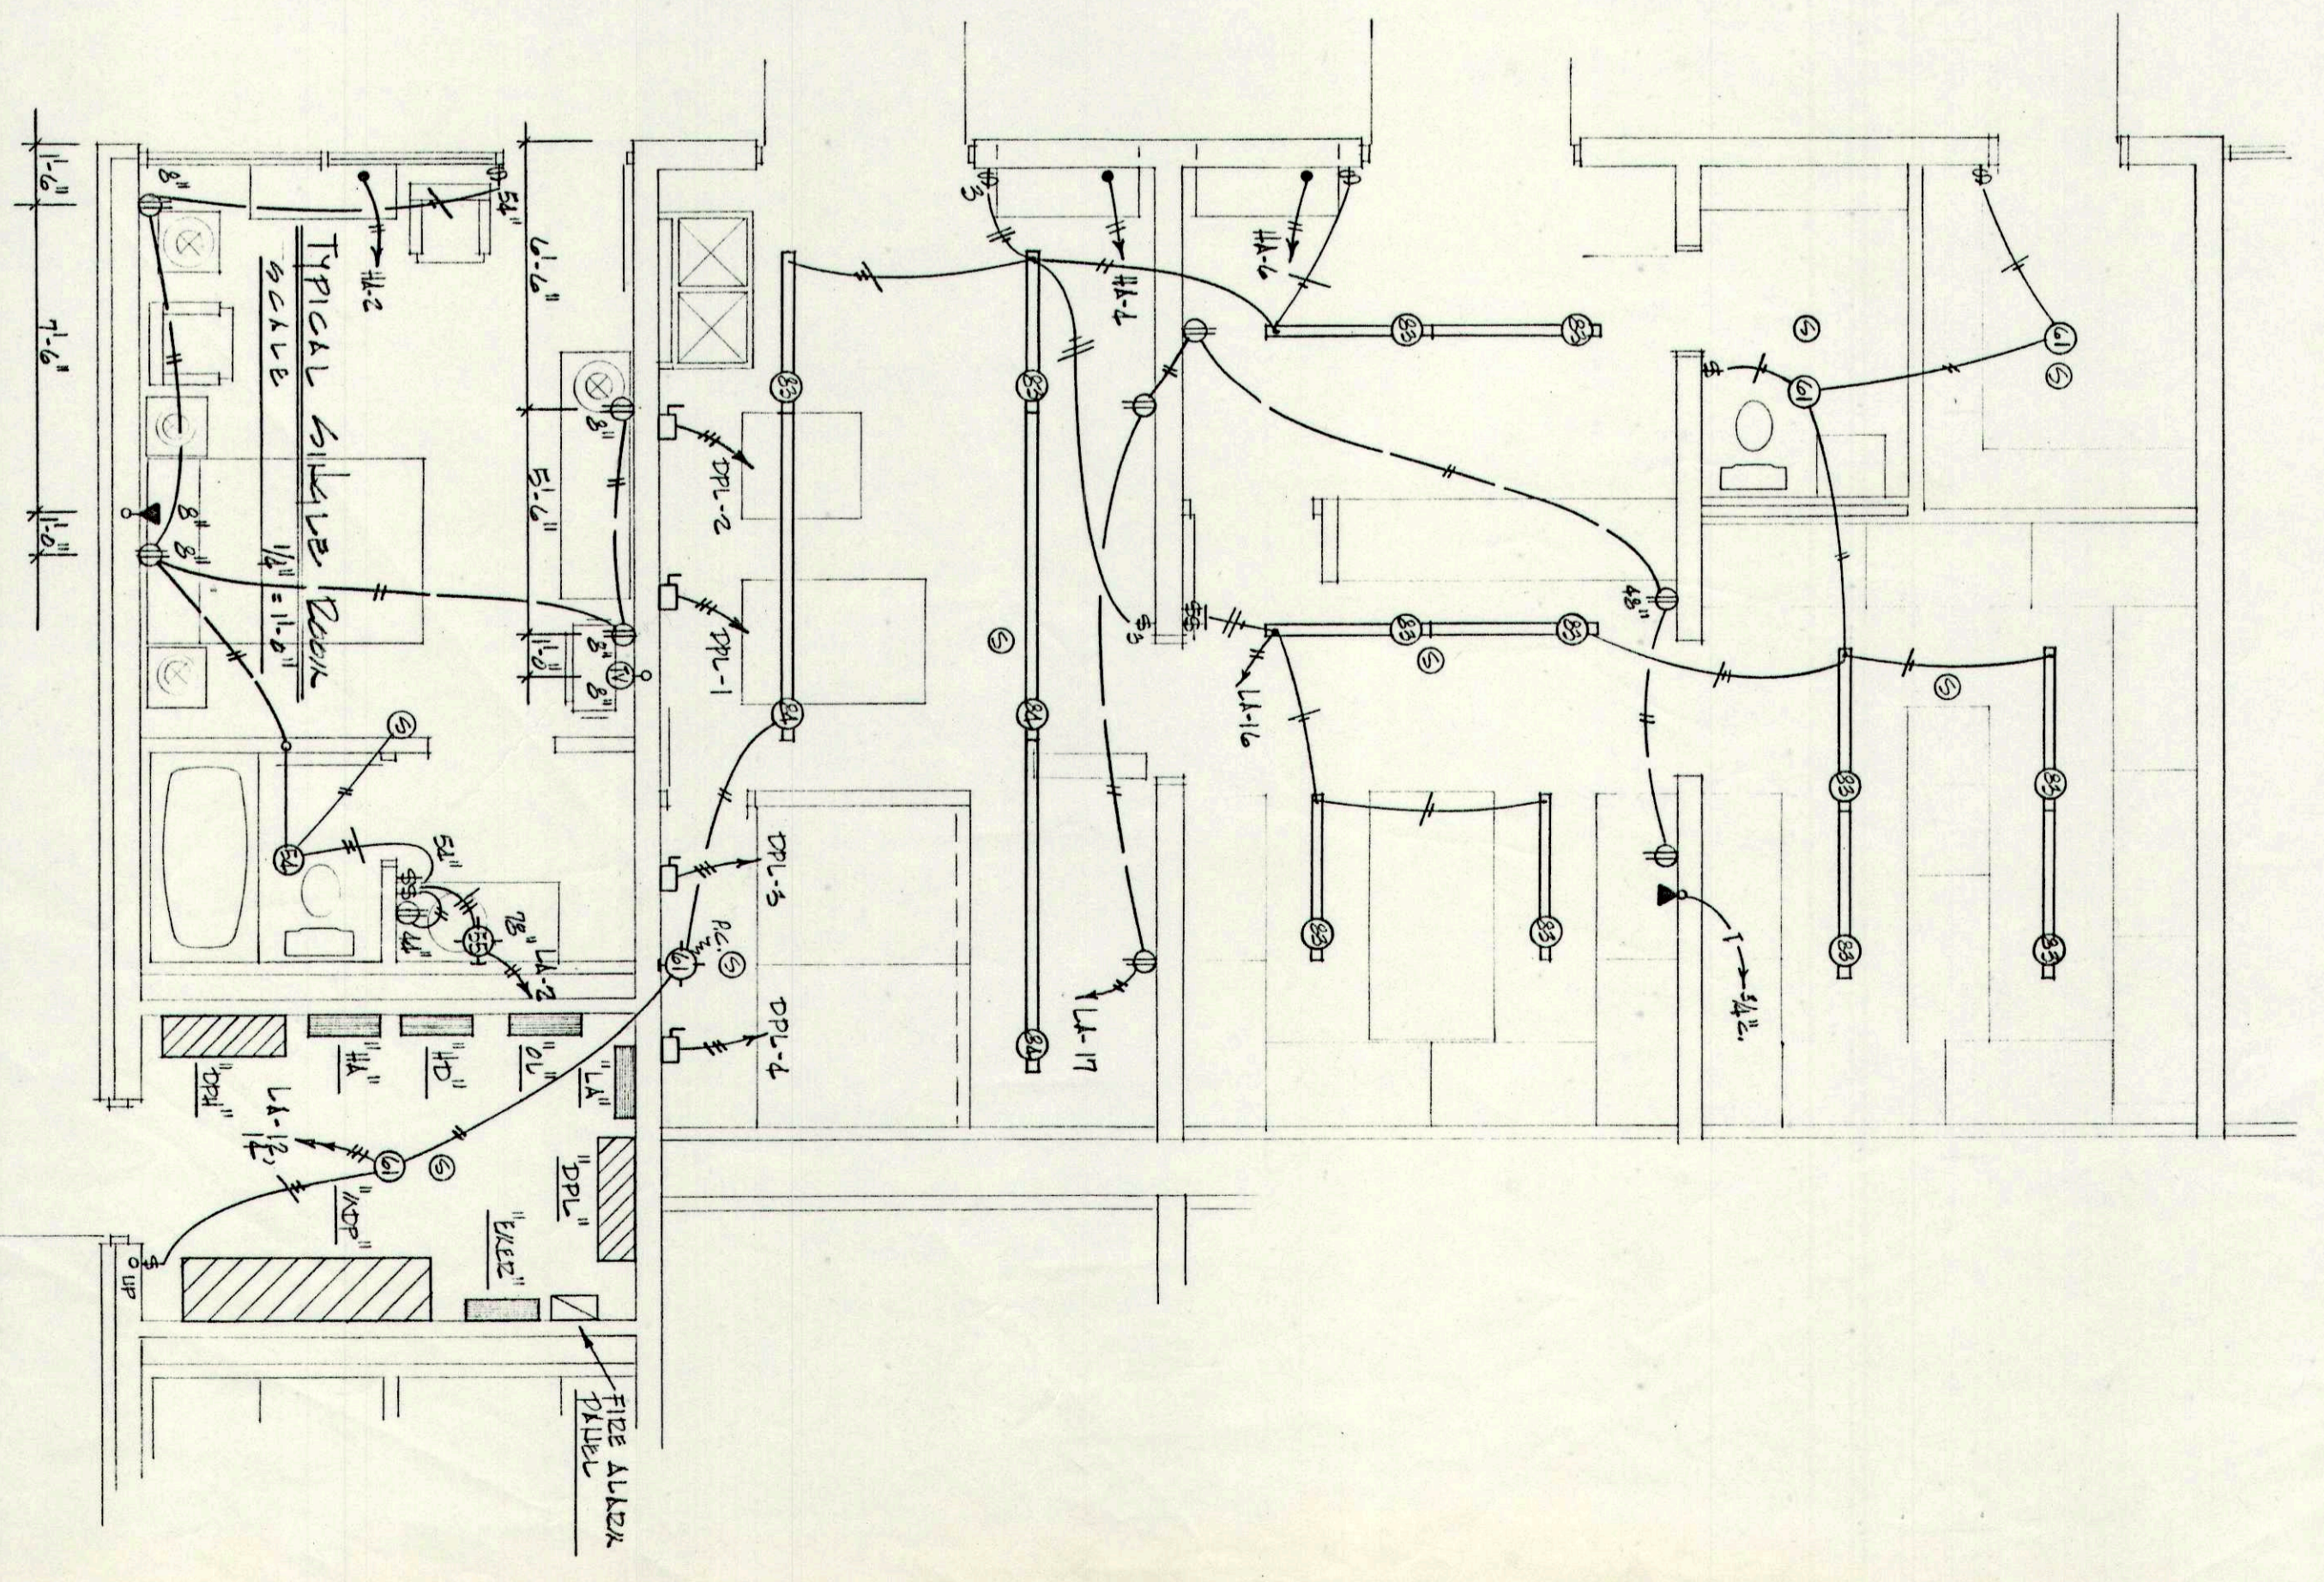

TYPICAL DOUBLE ROOM

GROUND FLOOR PLAN

NO.	DESCRIPTION	CHECK
1	REVISIONS FROM PUBLIC SAFETY 2-23-55	
2		
3		
4		
5		
6		
7		
8		
9		
10		

DRAWN: [Blank]

DESCRIPTION: [Blank]

CHECK: [Blank]

COMM. NO. 75274

DATE [Blank]

SHEET NO. E-2

SLIDELL, LOUISIANA