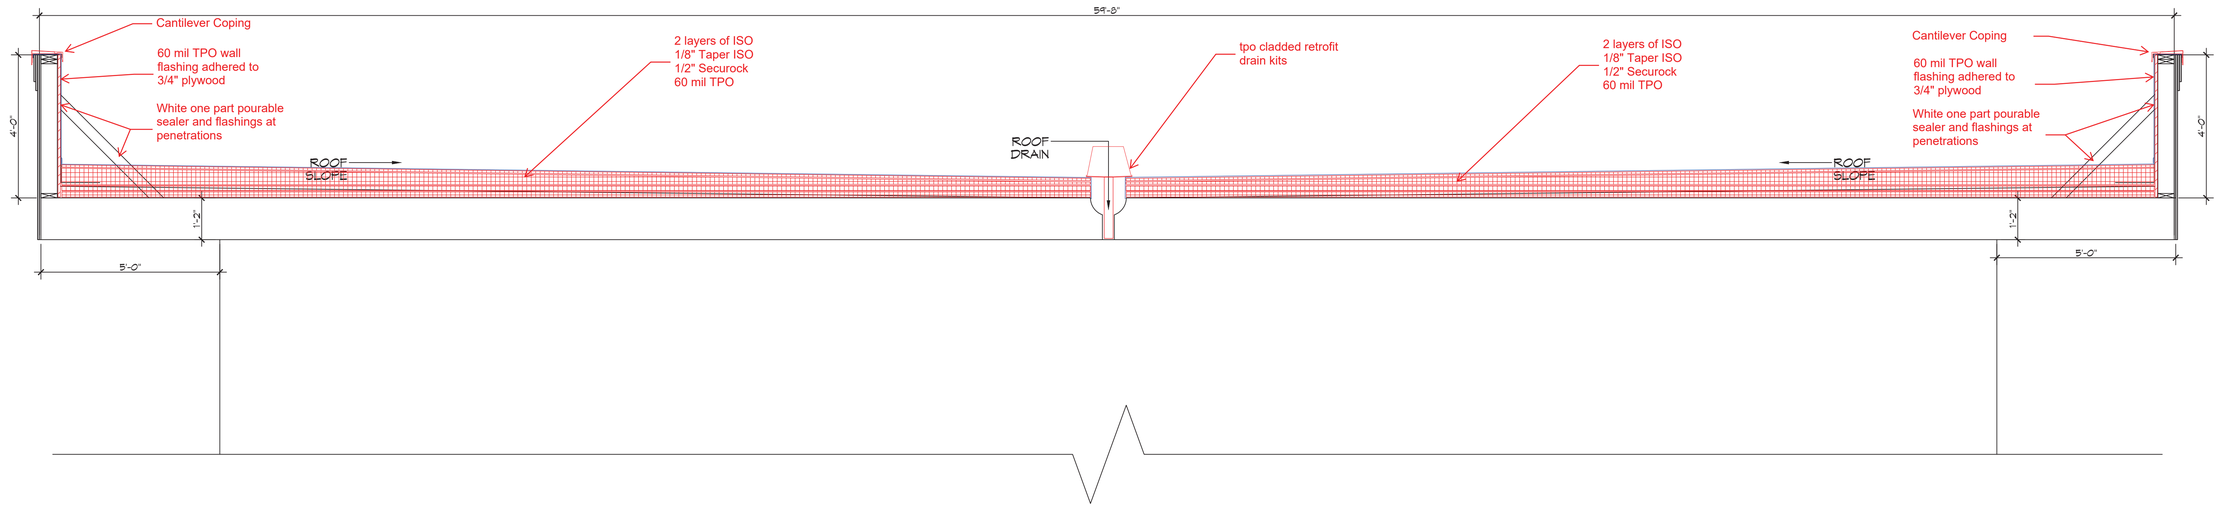

2 ROOF SECTION
SCALE: 1/2"= 1'-0"

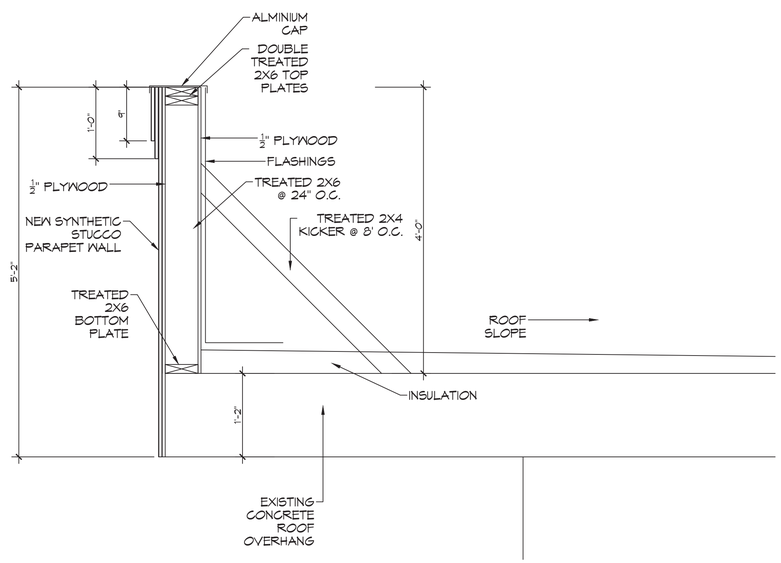

3 ROOF SECTION
SCALE: 1"= 1'-0"

DAMMON ENGINEERING, INC.
LOUISIANA & MISSISSIPPI
www.dammonengineering.com
info@dammonengineering.com
PH: 985.649.5832

Chief Engineer: Brian Mistich, PE
5545 Sugar Trail
Slidell, LA 70458

REVISIONS

#	DESCRIPTION	DATE

SEAL:

NEW ROOF PLAN

RED ROOF INN

1662 GAUSE BLVD.
SLIDELL, LA 70458

JOB No:	2451
DRAWN BY:	CASD
DATE:	09-12-2023
CHECKED BY:	JMS

The plans, specifications and ideas contained herein are the property of Dammon Engineering, and shall not be reused in whole or in part for any other project without the written authorization of Dammon Engineering. This restriction includes reproduction or transmission by any means, electronic or mechanical, and shall apply to all forms of information stored, recorded or transcribed. Any unauthorized reuse will be at the user's sole risk and without liability to Dammon Engineering.

SHEET TITLE:
ROOF SECTION AND DETAIL

DRAWING NUMBER:

A102

SHEET No: 1 of 1

FILE_NAME: J:\-- Homes-Hotels\2451 - Red Roof Inn Slidell\Drawings\Current Drawings\A102 - Elevation Plan Details.rvt PLOT DATE & TIME: Thursday, September 14, 2023 3:43:38 PM