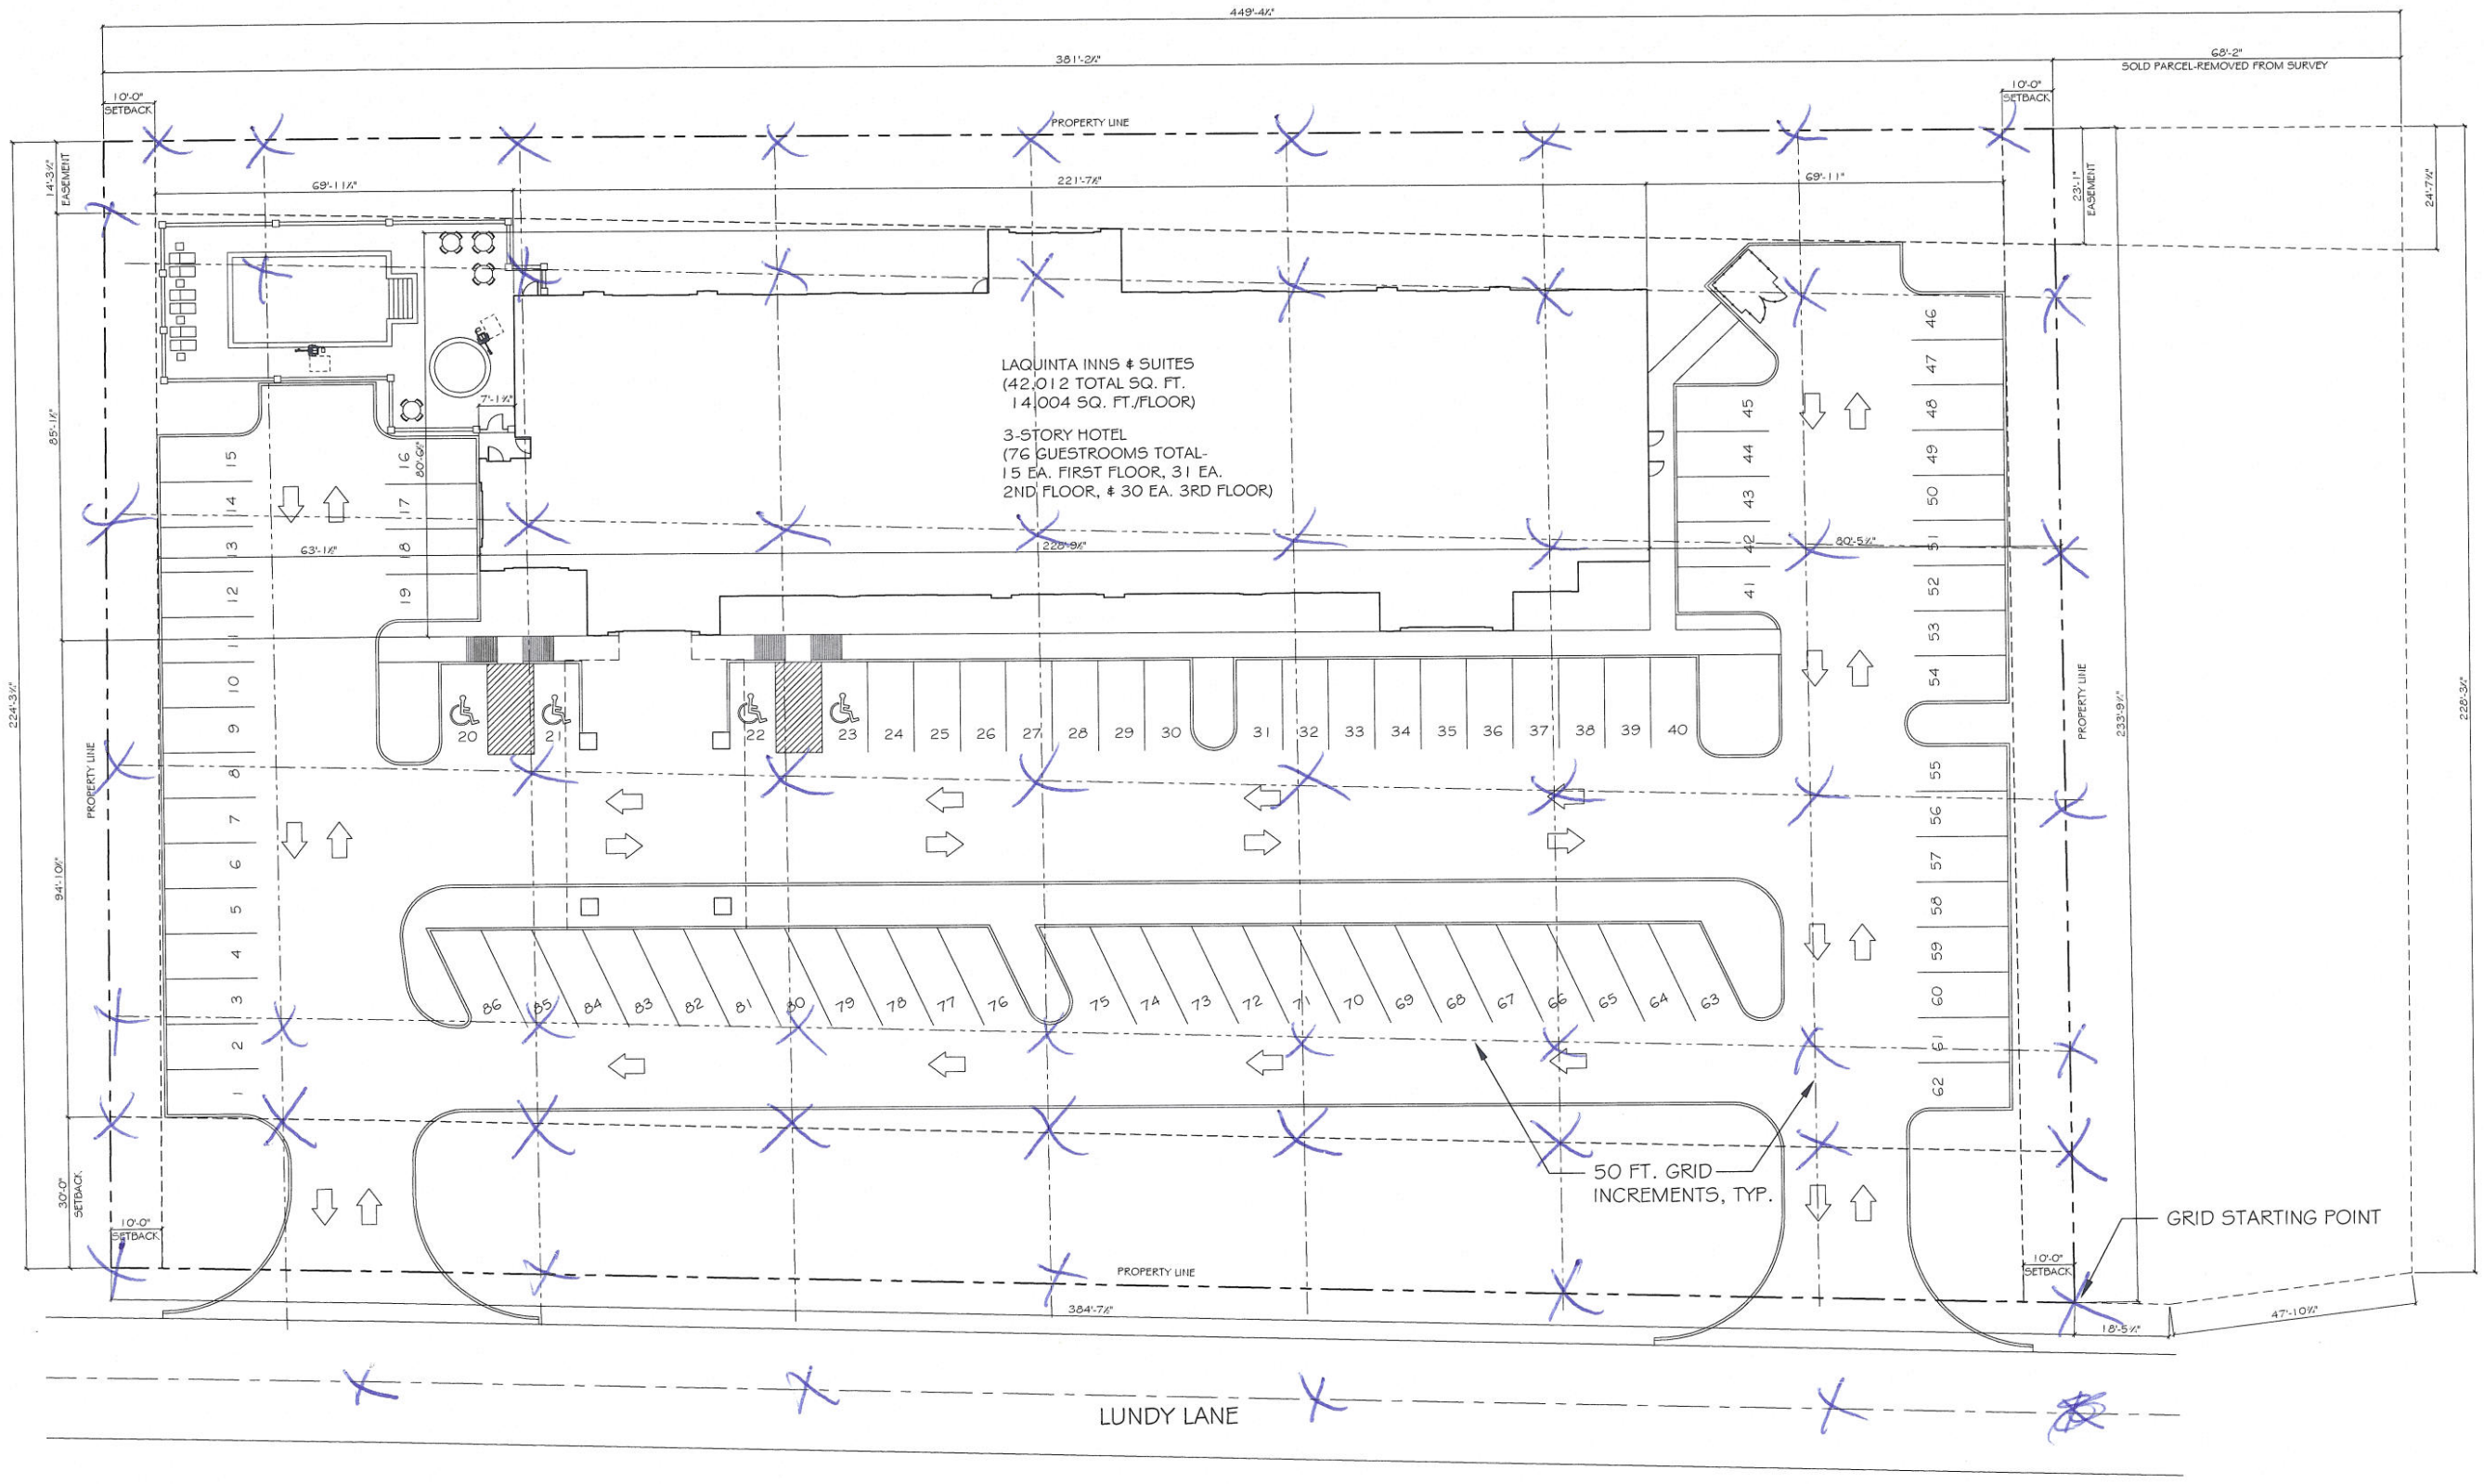

NEW PROPERTY - SCHEME "C"

SITE PLAN - SCHEME "C"
SCALE: 1/16"=1'-0"

PARKING REQUIREMENTS:
1.1 SPACE PER GUESTROOM AND 1 PER FIVE EMPLOYEES,
76 GUESTROOMS x1.1 = 83.6 OR 84 SPACES + 1 = 85
TOTAL SPACES NEEDED. 86 PROVIDED.

PRELIMINARY (NOT FOR CONSTRUCTION)

DAMMON ENGINEERING, INC.
dammoneng@bellsouth.net
PHONE: 985-649-5832
FAX: 985-641-5950
CHIEF ENGINEER: EMMETT DAMMON, P.E.
554 OLD SPANISH TRAIL
SLIDELL, LA 70458

LAQUINTA INNS & SUITES
HATTIESBURG, MISSISSIPPI

JOB No: 2158 | DATE: 01-09-2013
DRAWN BY: JTL | CHECKED BY: -

#	DESCRIPTION	DATE
	REVISIONS	

NEW SITE PLAN SCHEME "C"

SHEET No: C2