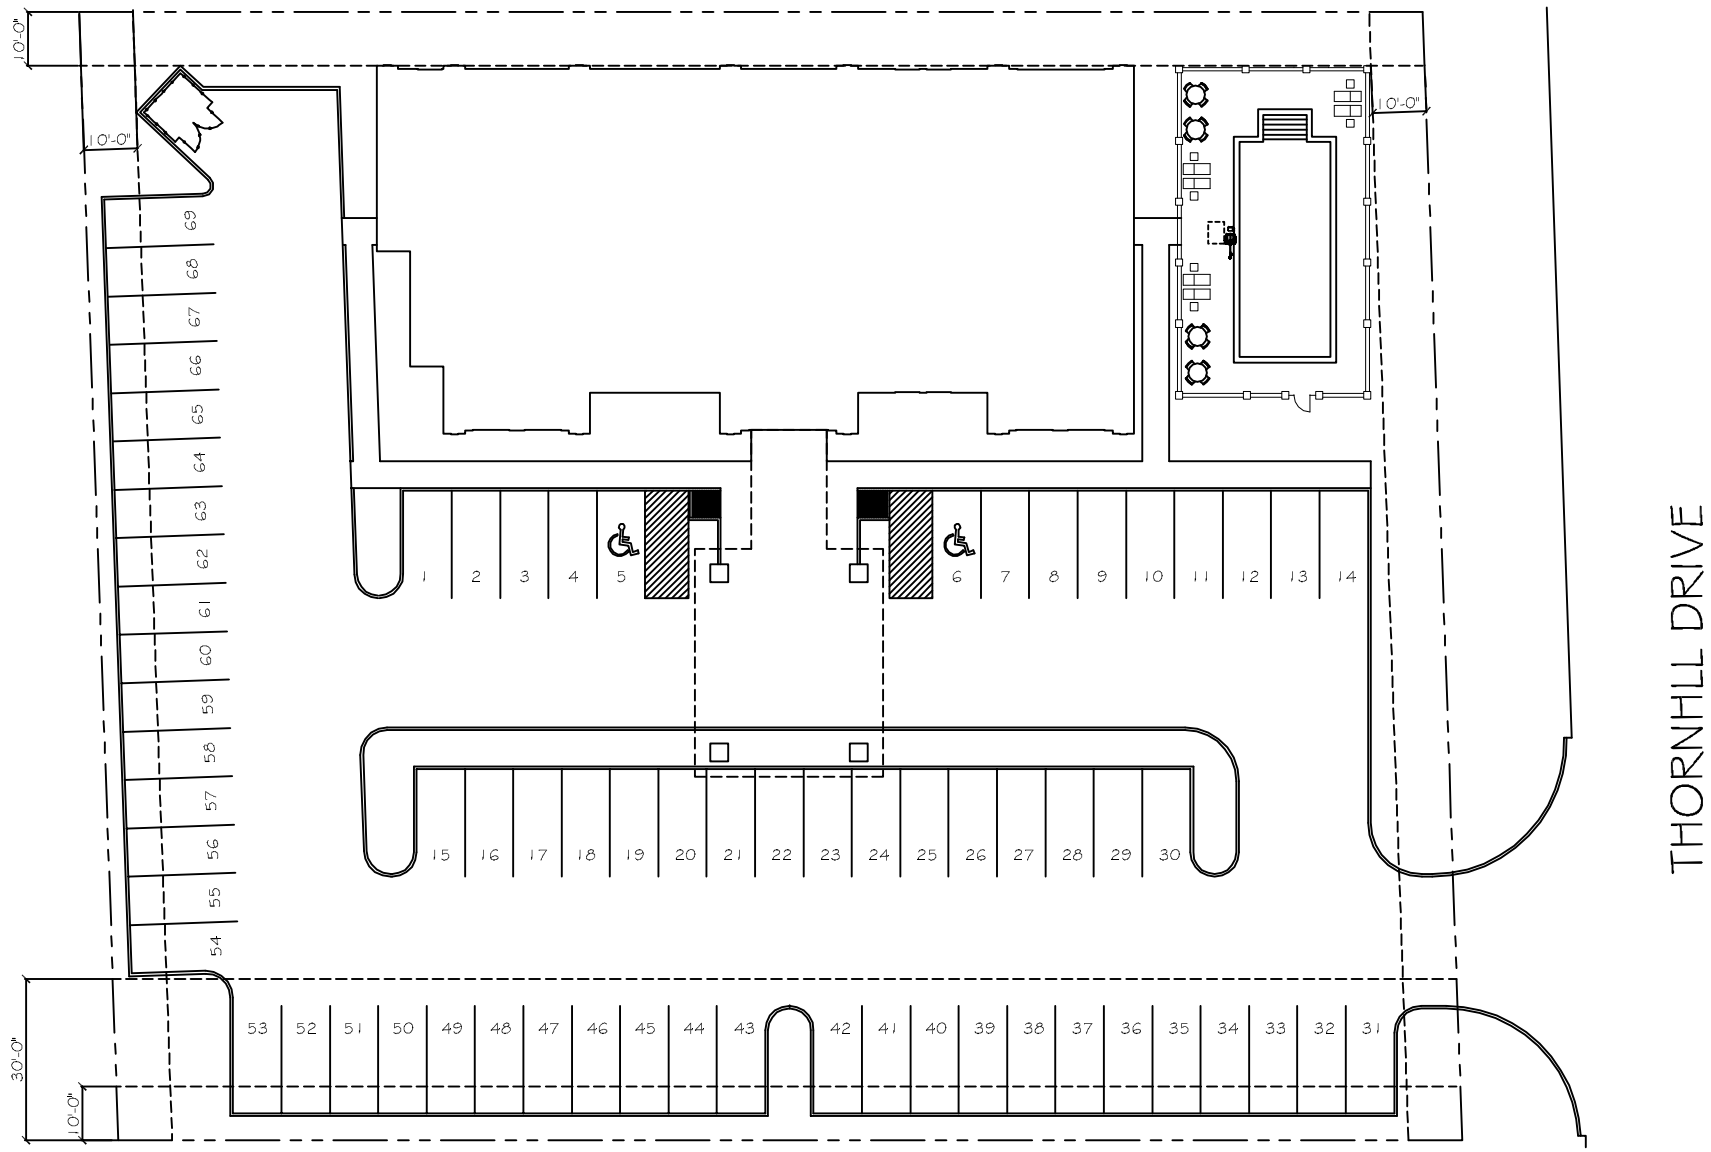

SCHEME - TWO
PROPERTY ROTATED
WITH SHORTER BUILDING
DELETED ONE 12'-5 ½" BAY

WROND SETBACK AT ROAD
SHOULD BE 30 FT. (NOT 10')
AND SHOULD BE NO PARKING
IN REAR & SIDE SETBACKS -
WONT WORK!

DAMMON ENGINEERING, INC.
architects & engineers
dammoneng@engineering.com
dammoneng@bellsouth.net
*HOME: 985 649 5532
FAX: 985 641 9550
CHIEF ENGINEER: EMMETT DAMMON, P.E.
CHIEF ARCHITECT: ROBERT WEITZE
594 OLD SPANISH TRAIL
SLIDELL, LA 70458

LAQUINTA INN & SUITES

HATTIESBURG, MISSISSIPPI

JOB No:	2158
DATE:	11-30-2012
DRAWN BY:	JTL
CHECKED BY:	

This plan, as an instrument of service, is the property of Dammon Engineering, Inc. and shall not be reproduced in whole or in part without written permission of Dammon Engineering, Inc. Reproducibles are provided to the owner for his use in the construction of the project shown on this plan. Any other use or reuse by the owner or others on other projects or extensions to this project without written permission of Dammon Engineering, Inc. is prohibited.

#	DESCRIPTION	DATE

REVISIONS

SITE PLAN
SCHEME-2

SHEET No:

C-2