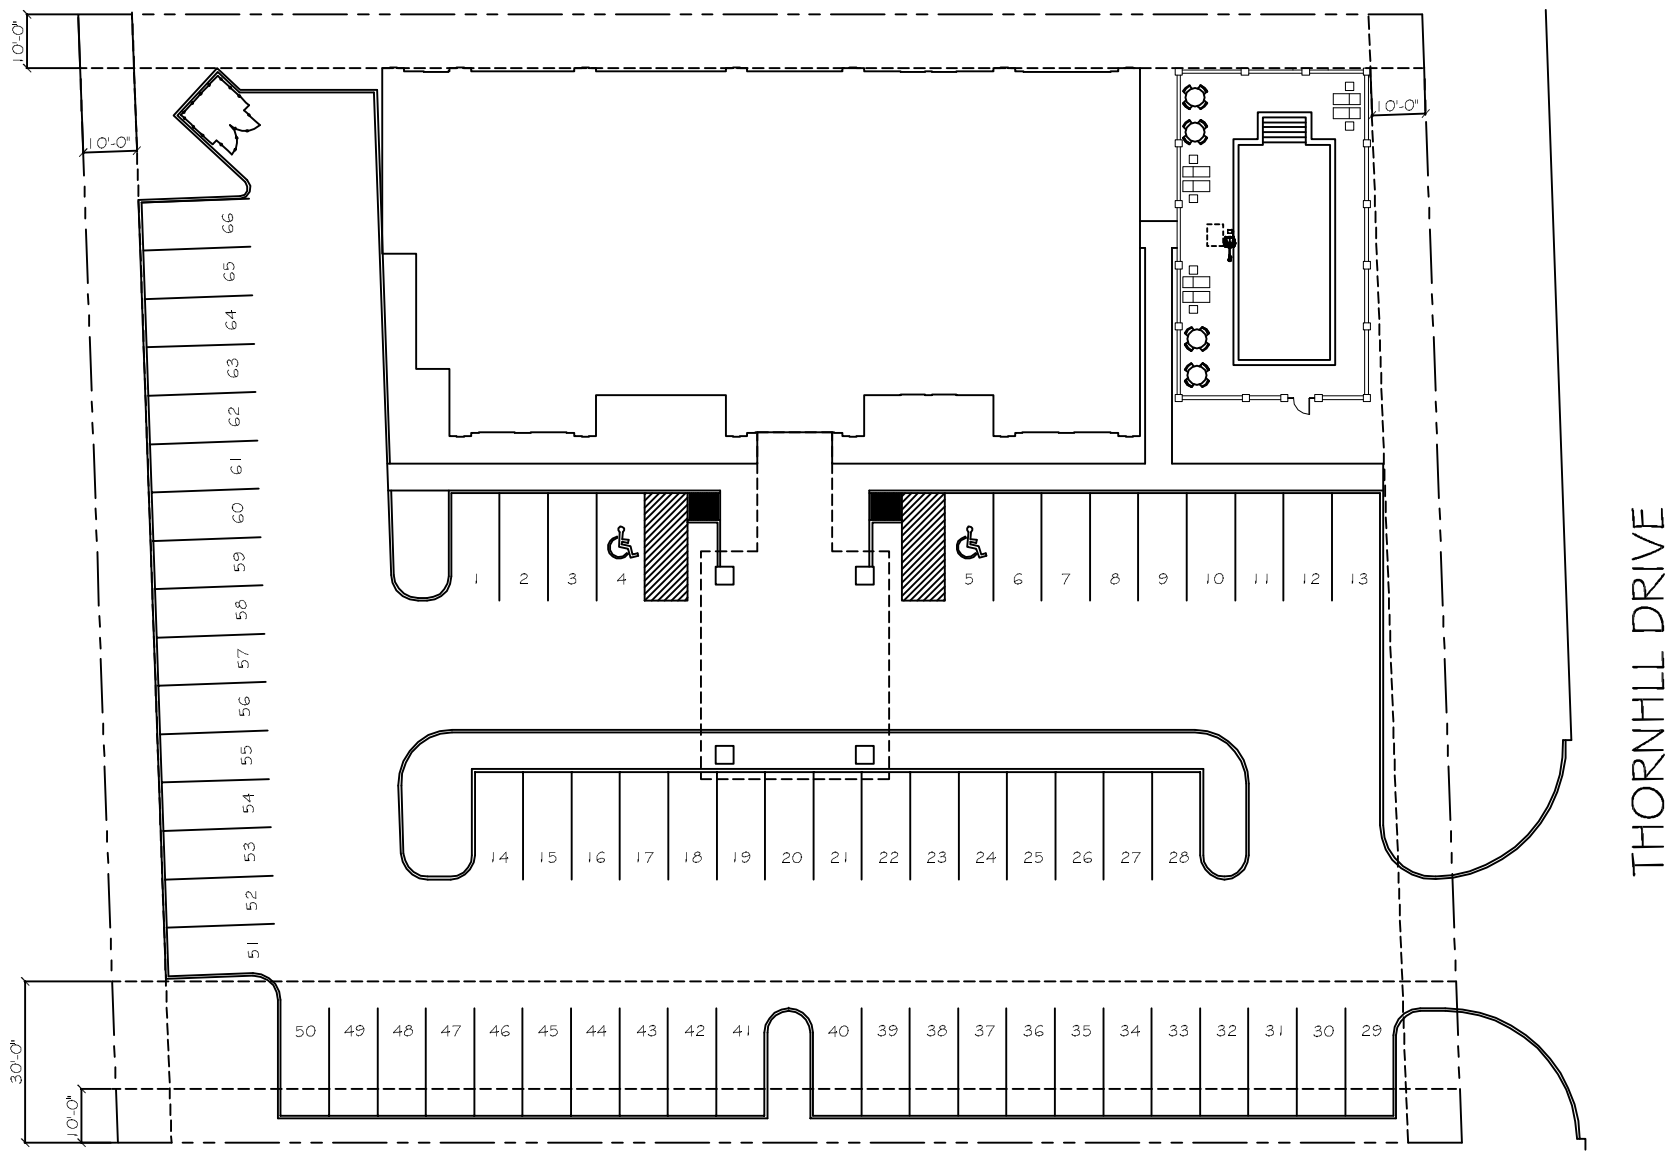

SCHEME - FOUR
WITH SHORTER BUILDING
AND REVISED PARKING

WROND SETBACK AT ROAD
SHOULD BE 30 FT. (NOT 10')

DAMMON
ENGINEERING, INC.
Architects & Engineers

CHIEF ENGINEER: EMMETT DAMMON, P.E.
CHIEF ARCHITECT: ROBERT WEISE
594 O.D. SPANISH TRAIL
SLIDELL, LA 70458

dammoneng@bellsouth.net
*HOME: 985 649 5532
FAX: 985 641 9550

LAQUINTA INN & SUITES

HATTIESBURG, MISSISSIPPI

JOB No: 2158 | DATE: 11-30-2012

DRAWN BY: JTL | CHECKED BY:

REVISIONS

#	DESCRIPTION	DATE

SITE PLAN
SCHEME-4

SHEET No:

C-2