

**SURVEY REFERENCE:**


PLAN OF RESUBDIVISION PREPARED BY BFM CORPORATION, JOHN S. TELGARDEN, REGISTERED LAND SURVEYOR, DATED MARCH 2, 2005, REVISED APRIL 13, 2005, DRAWING NO. F-5379-2005, PROJECT NO. 4551.

**GENERAL NOTES**

THE LOCATIONS OF UNDERGROUND AND OTHER NONVISIBLE UTILITIES SHOWN HEREON HAVE BEEN DETERMINED FROM DATA EITHER FURNISHED BY THE AGENCIES CONTROLLING SUCH DATA AND/OR EXTRACTED FROM RECORDS MADE AVAILABLE TO US BY THE AGENCIES CONTROLLING SUCH RECORDS. WHERE FOUND, THE SURFACE FEATURES OF LOCATIONS ARE SHOWN. THE ACTUAL NONVISIBLE LOCATIONS MAY VARY FROM THOSE SHOWN HEREON. EACH AGENCY SHOULD BE CONTACTED RELATIVE TO THE PRECISE LOCATION OF ITS UNDERGROUND INSTALLATION PRIOR TO ANY RELIANCE UPON THE ACCURACY OF SUCH LOCATIONS SHOWN HEREON, INCLUDING PRIOR TO EXCAVATION AND DIGGING.

ALL ELEVATIONS SHOWN REFER TO N.A.V.D. 88 DATUM.  
N.A.V.D. = NORTH AMERICAN VERTICAL DATUM

REFERENCE B.M. = GRENA 2  
ELEVATION = 1.0' N.A.V.D. 88, GEOID 00 (2008.01)

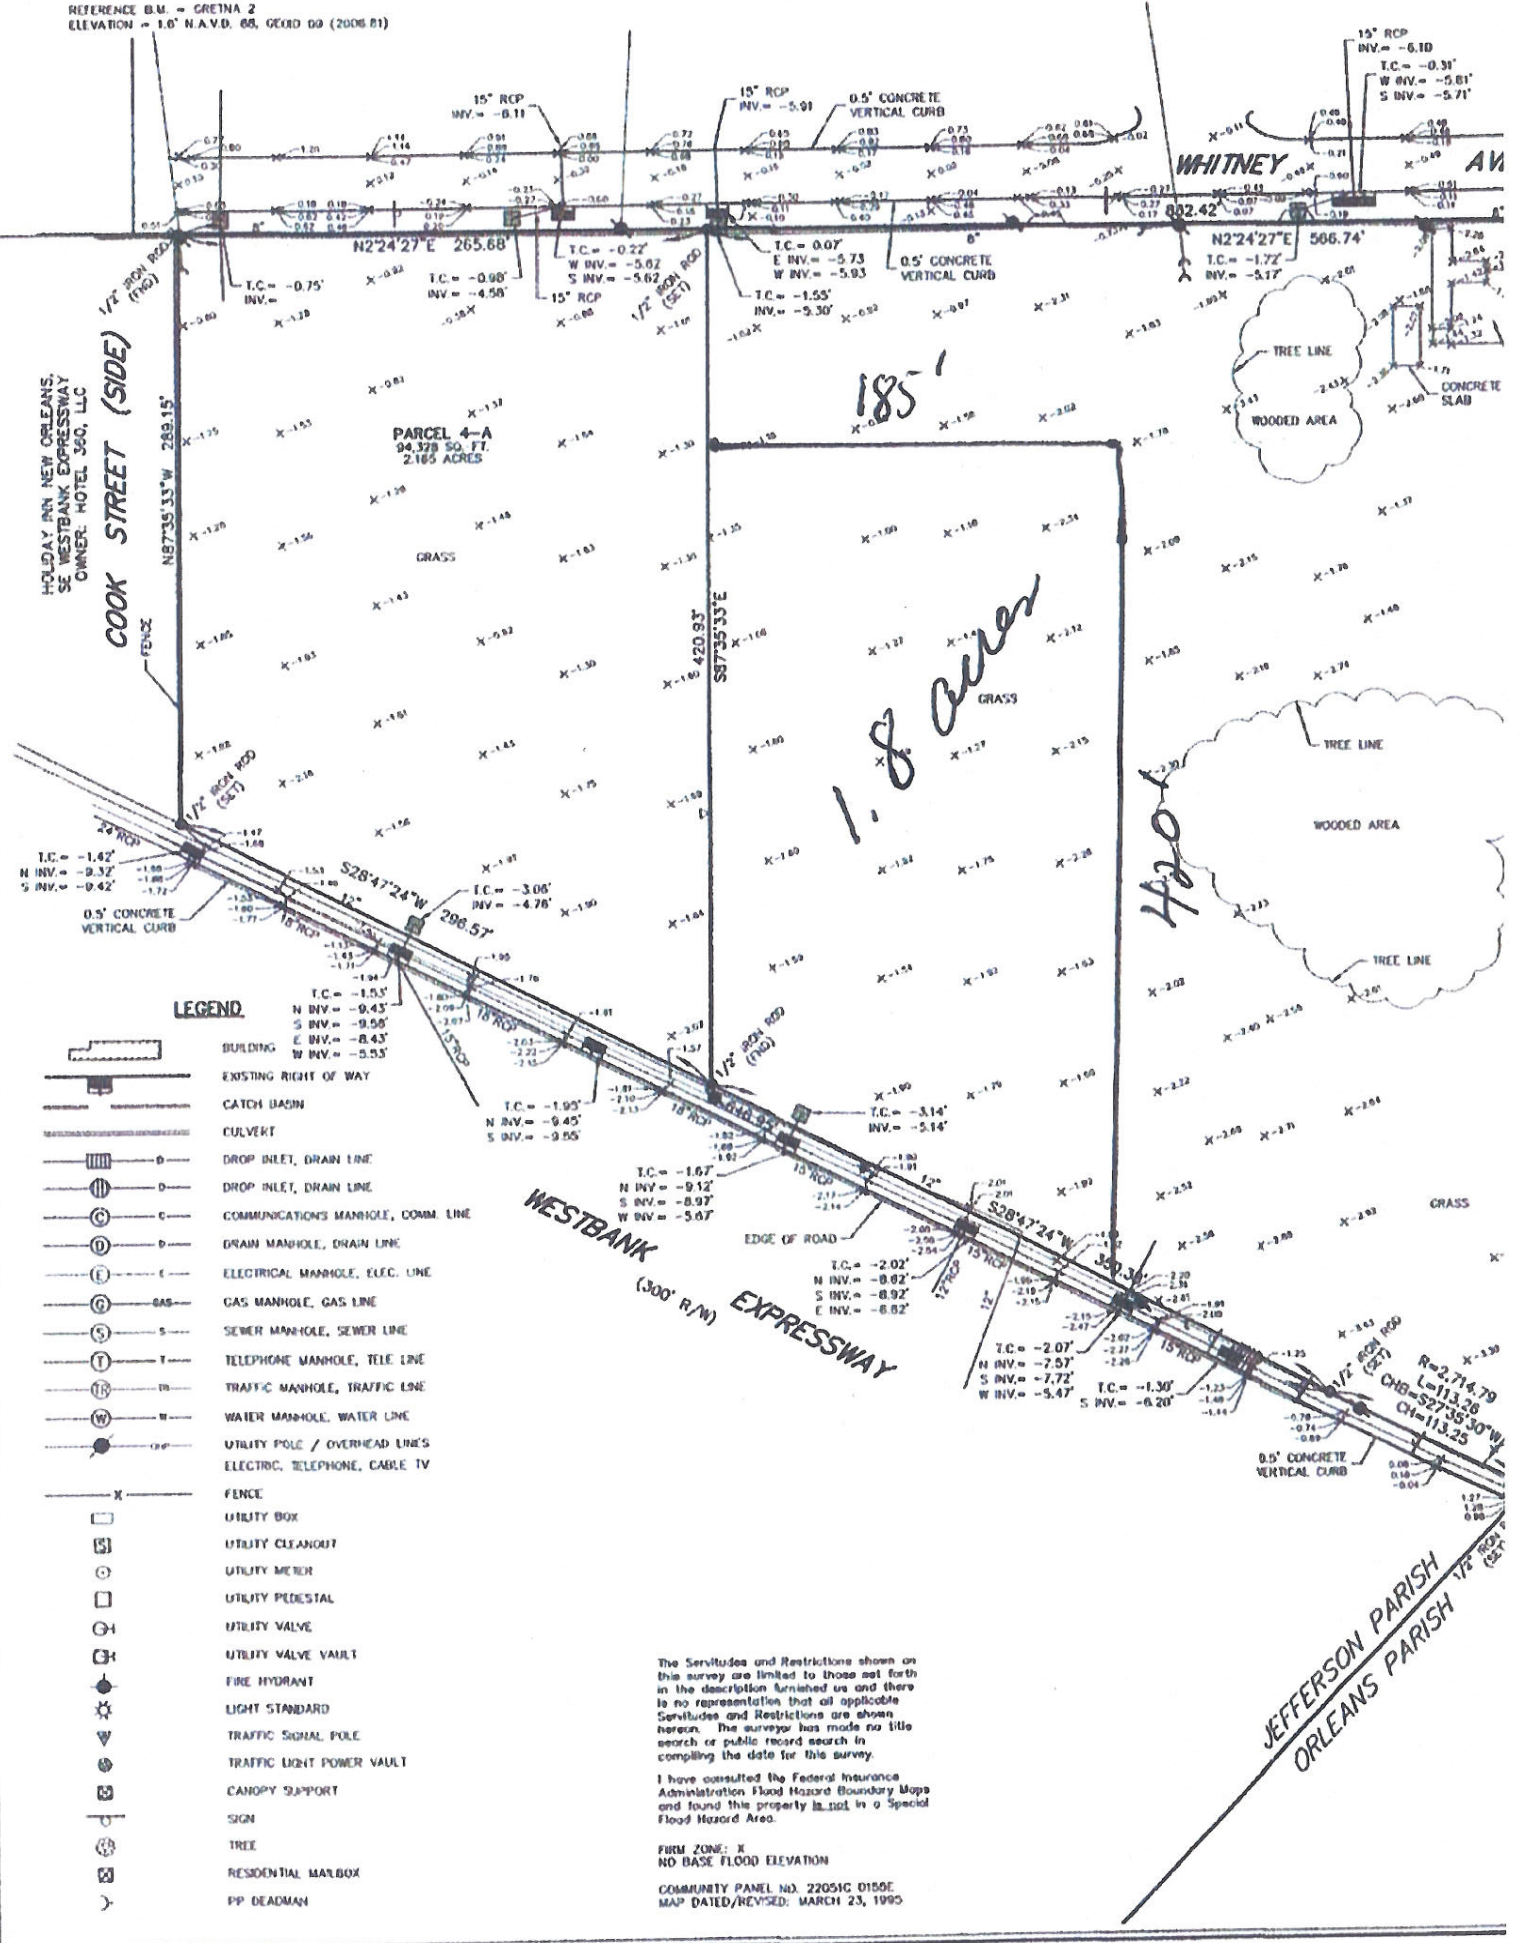

**LEGEND**

- BUILDING
- CATCH BASIN
- CULVERT
- DROP INLET, DRAIN LINE
- DROP INLET, DRAIN LINE
- COMMUNICATIONS MANHOLE, COMM LINE
- DRAIN MANHOLE, DRAIN LINE
- ELECTRICAL MANHOLE, ELCT. LINE
- GAS MANHOLE, GAS LINE
- SEWER MANHOLE, SEWER LINE
- TELEPHONE MANHOLE, TELE LINE
- TRAFFIC MANHOLE, TRAFFIC LINE
- WATER MANHOLE, WATER LINE
- UTILITY POLE / OVERHEAD LINES
- FENCE
- UTILITY BOX
- UTILITY CLEANOUT
- UTILITY METER
- UTILITY PEDESTAL
- UTILITY VALVE
- UTILITY VALVE VAULT
- FIRE HYDRANT
- LIGHT STANDARD
- TRAFFIC SIGNAL POLE
- TRAFFIC LIGHT POWER VAULT
- CANOPY SUPPORT
- SIGN
- TREE
- RESIDENTIAL MAILBOX
- PP DEADMAN

The Servitudes and Restrictions shown on this survey are limited to those set forth in the description furnished us and there is no representation that all applicable Servitudes and Restrictions are shown hereon. The surveyor has made no title search or public record search in compiling the data for this survey.

I have consulted the Federal Insurance Administration Flood Hazard Boundary Maps and found this property is not in a Special Flood Hazard Area.

FIRM ZONE: X  
NO BASE FLOOD ELEVATION

COMMUNITY PANEL NO. 22051C D150E  
MAP DATED/REVISED: MARCH 23, 1995