



CONV. EC-5A & BC-5B FOUNDATION PLAN
T/CONC. EL. 39'-0" (U.N.)

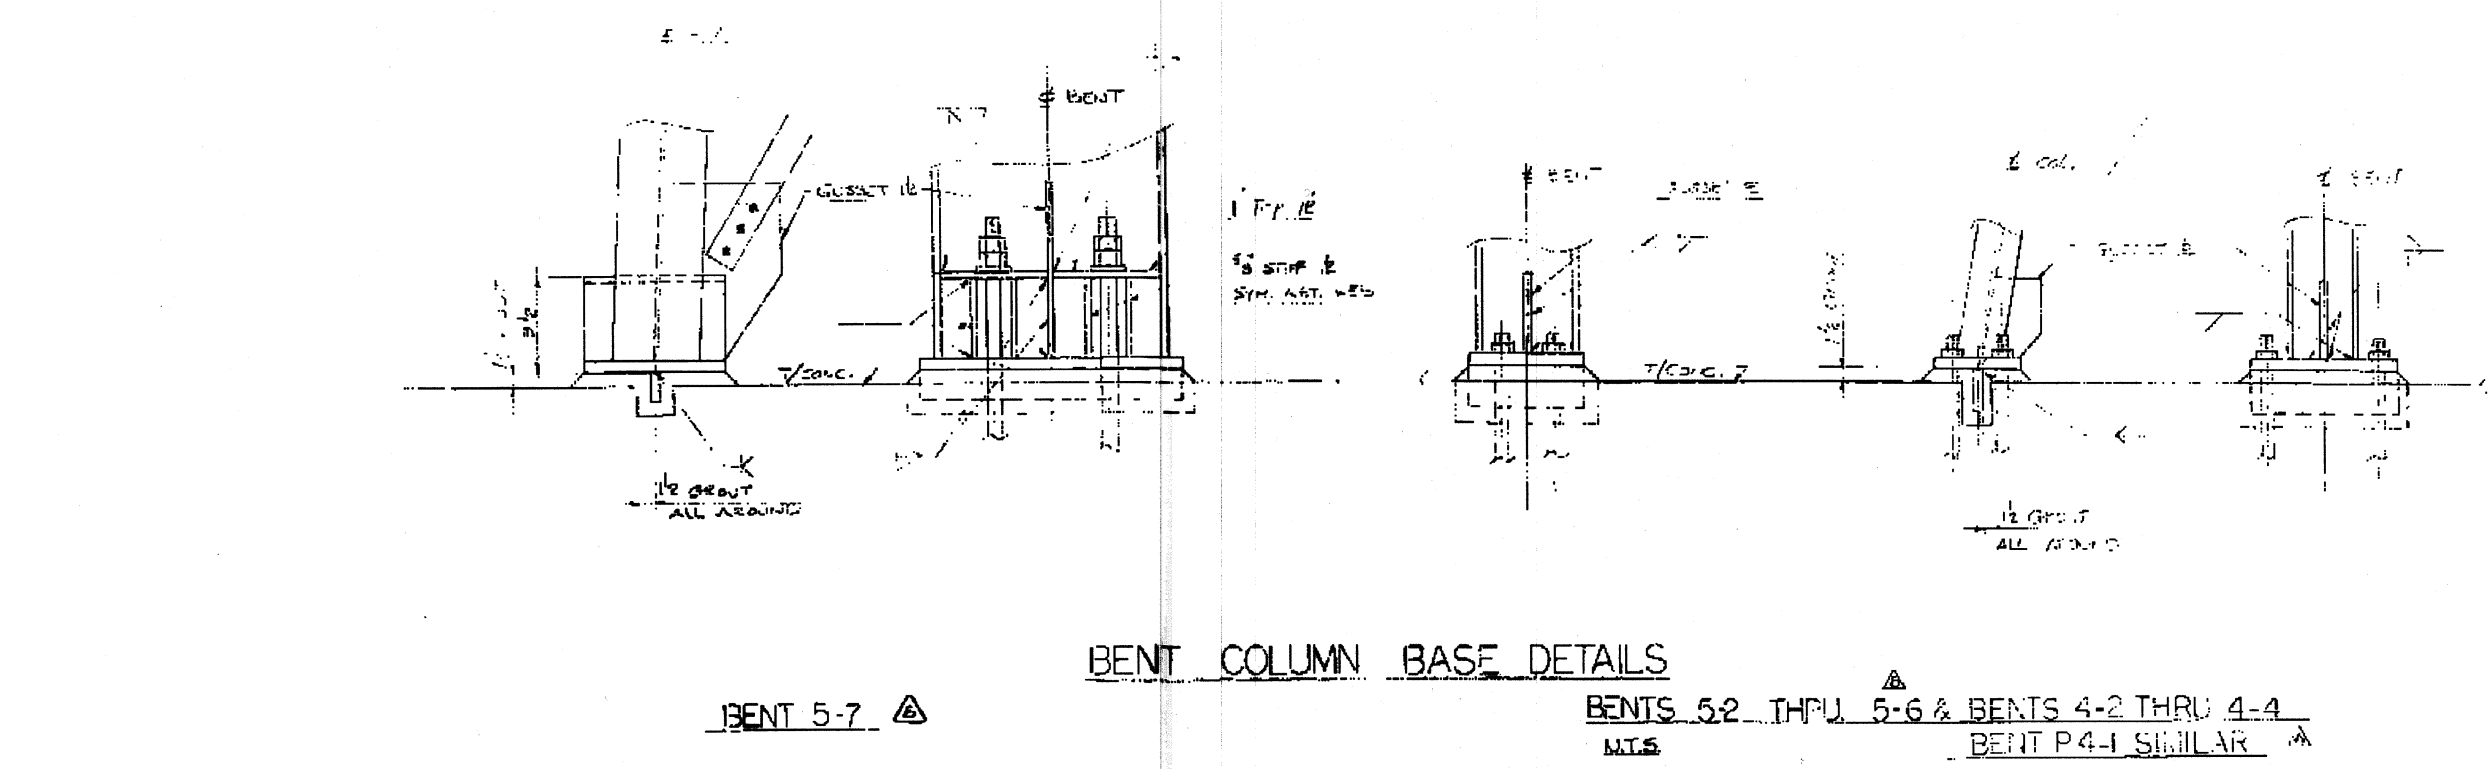

BENT COLUMN BASE DETAILS
BENTS 5-2 THRU 5-6 & BENTS 4-2 THRU 4-4
BENT P-4-1 SIMILAR

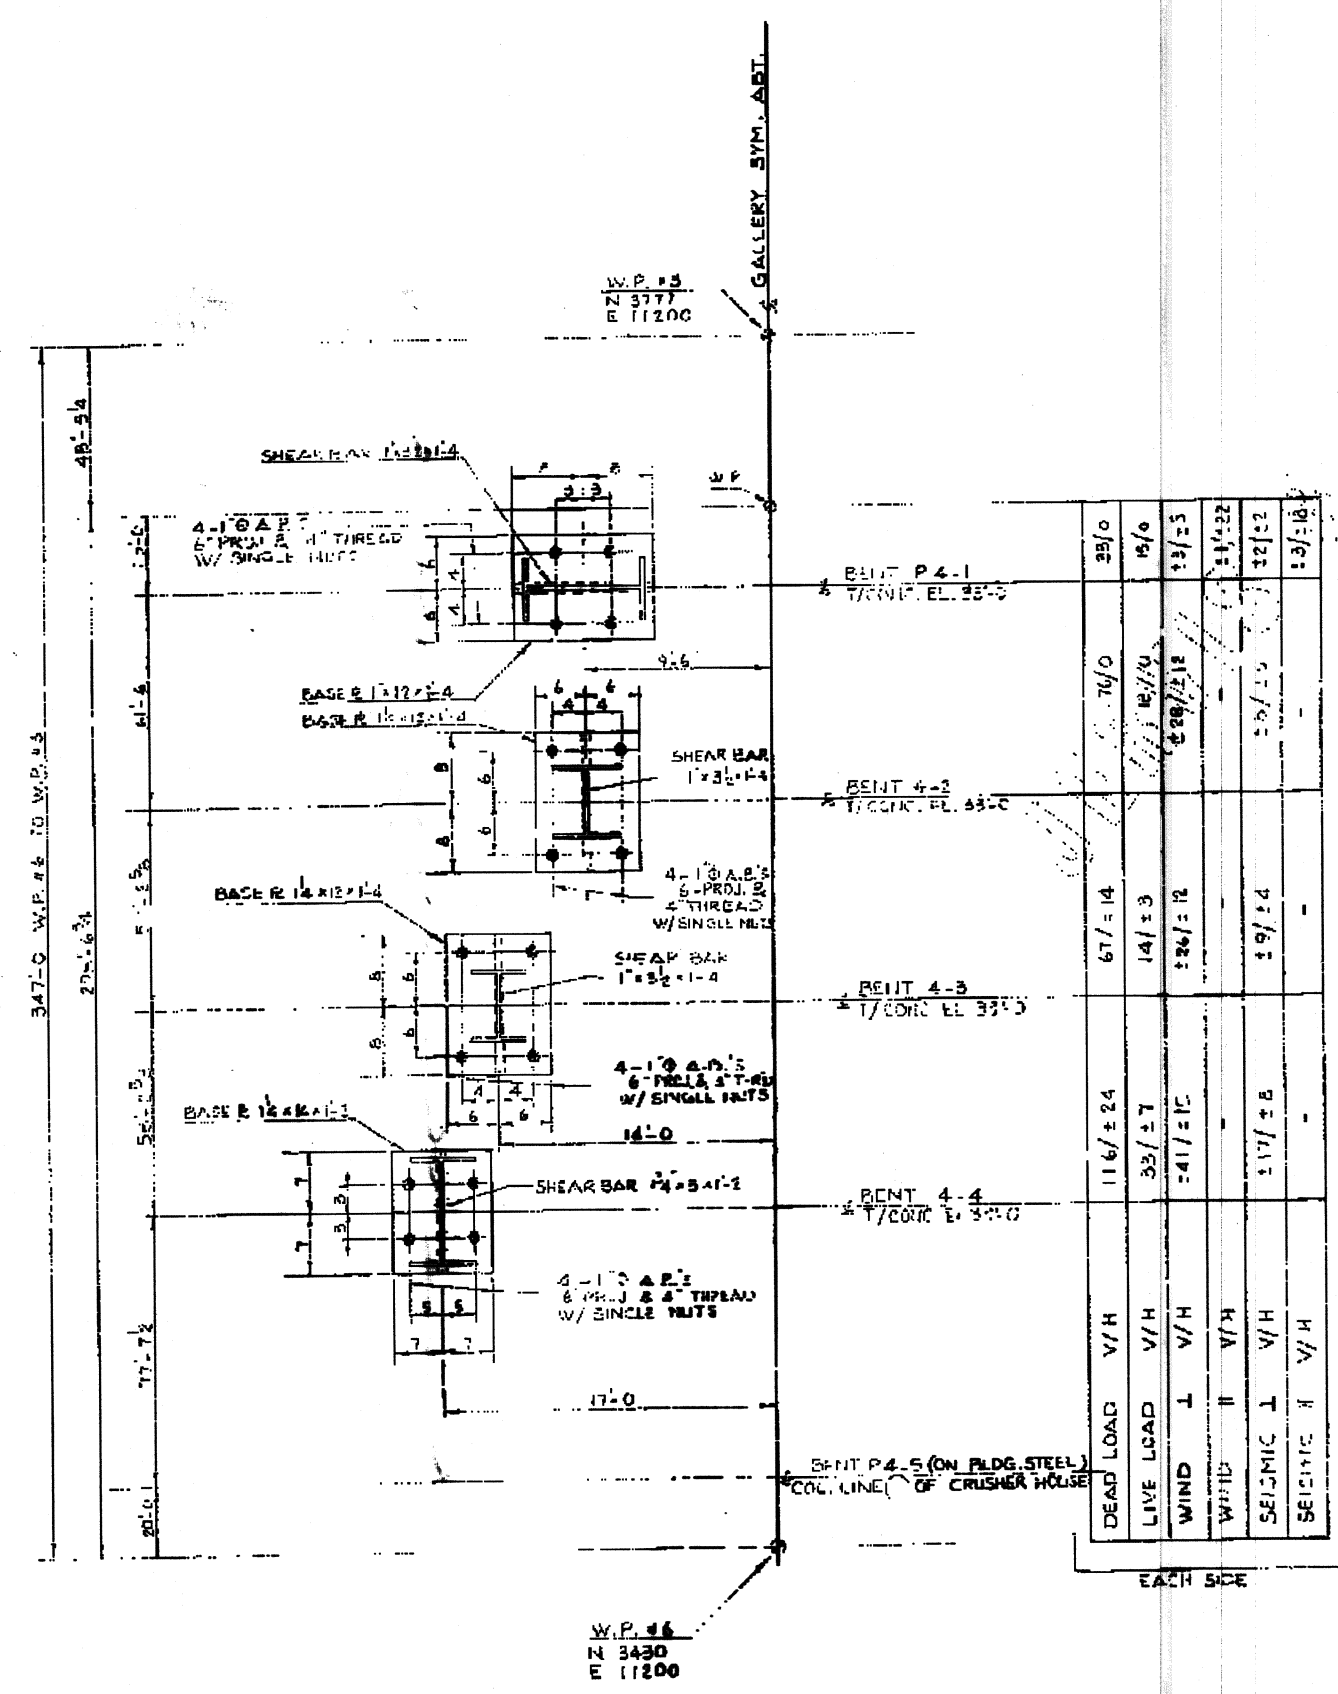

CONV. BC-4A & BC-4B FOUNDATION PLAN
T/CONC. EL. 39'-0" (U.N.)


NOTE:
FOR TYPICAL FOUNDATION NOTES
SEE DWG. ESI-4

REF. DWG.
E1-1 GENERAL PLOT PLAN
E1-3 GENERAL ELEVATION VIEWS FOR
SERV. BC-5A & BC-5B AND
ALSO CONV. BC-4A & BC-4B.

10-7-72 Jgg
10-13-72 Jgg

CALUM ELECTRIC POWER COOPERATIVE, INC.
800 GALEY RD. & POWER STATION
LOUISIANA 80 DAYOU
CONTRACT 02-17-COAL, HANCOCK

BUILDING SYSTEMS
SERVIS B. WEBB CO.

ANCHOR BOLT PLANS AND FOUNDATION LOADS
FOR CONV. BC-5A & BC-5B & CONV. BC-4A & BC-4B
CALUM ELECTRIC POWER COOPERATIVE, INC.
800 GALEY RD. & POWER STATION
LOUISIANA 80 DAYOU
SERVIS B. WEBB CO.
AS NOTED 4-11-1977
6-34850-E ESI-6 C

W. MENSCH

