


SECTION A-A
16'-0" (E59-1 ~ E59-4 & E57-1 ~ E57-2)

CONV'S	BELT SIZE	DIM. FOR DUAL CONV. GALLERY							
		A	B	C	D	E	F	G	H
BC-5A & BC-6E	4B	18'-4"	1'-2"	7'	16'-0"	1'-1"	1'-5"	3'-11 1/2"	2'-7"
BC-4A & BC-1B	4B	21'-6"	1'-2"	8'	14'-0"	1'-5"	1'-5"	3'-6"	2'-0"


NOTE C:
DO NOT PLACE REIN. BARS WITHIN
"A" EITHER SIDE OF EXP. BOLT.

NOTE B: ROOFING & SIDING
1/2" HI-RIB 22 GA. STEELITE W/2"22
LINER PANEL & INSULATION


NOTE A: CONCRETE FLOOR SLAB
1) S_c = 400 PSI @ 28 DAYS
2) MAC-COR. TYPE 2, 22 GA. D4 T-WIRE @ 6" (DESIGN C)
3) 3" @ 6" 16'-0" LG. TOP OVER
ALL INTERIOR BENTS
4) SHORE SINGLE SPANS
5) FOR ADDITIONAL CONCRETE INFORMATION
REFER TO CUSTOMER'S SPECIFICATIONS
17B-18B-18
6) DECK FASTENERS - MILTI ESD 16 PBT DECKING PIN.
7) ALLOWABLE CONSTRUCTION LOAD 35 PSF

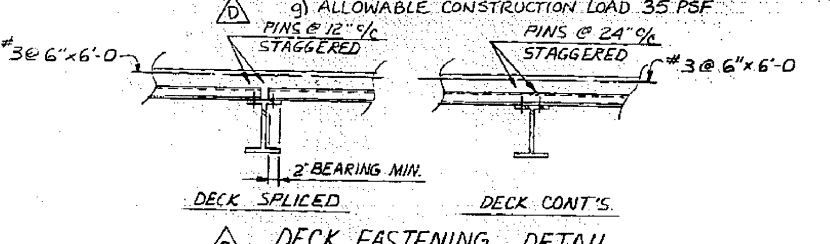


DECK FASTENING DETAIL

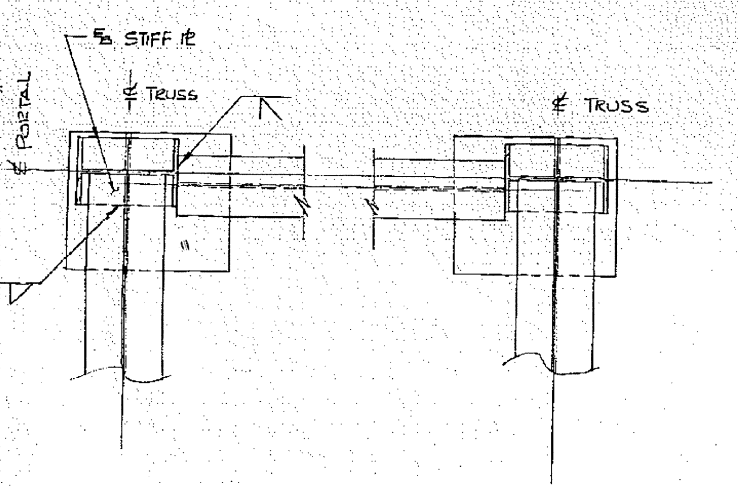


SECTION M-M
BOTTOM CHORD AT PORTAL

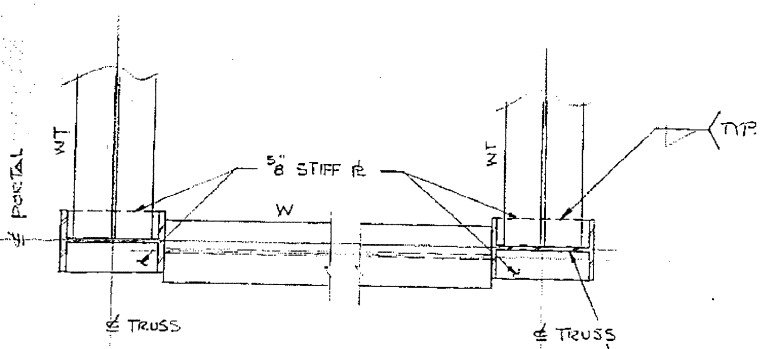

SECTION M-M
BOTTOM CHORD AT PORTAL

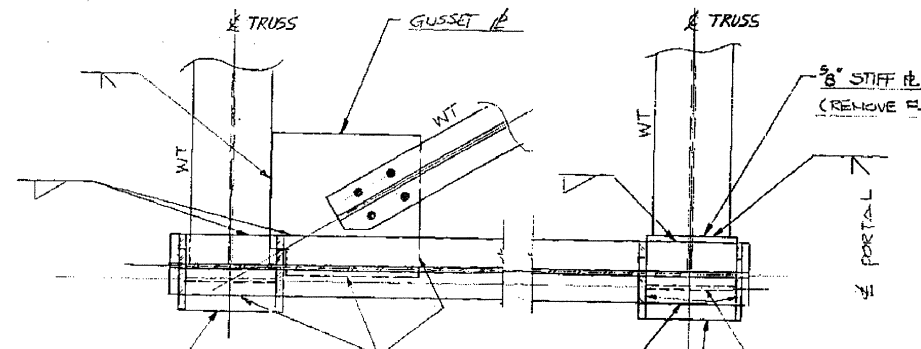


SECTION N-N
TOP CHORD AT PORTAL

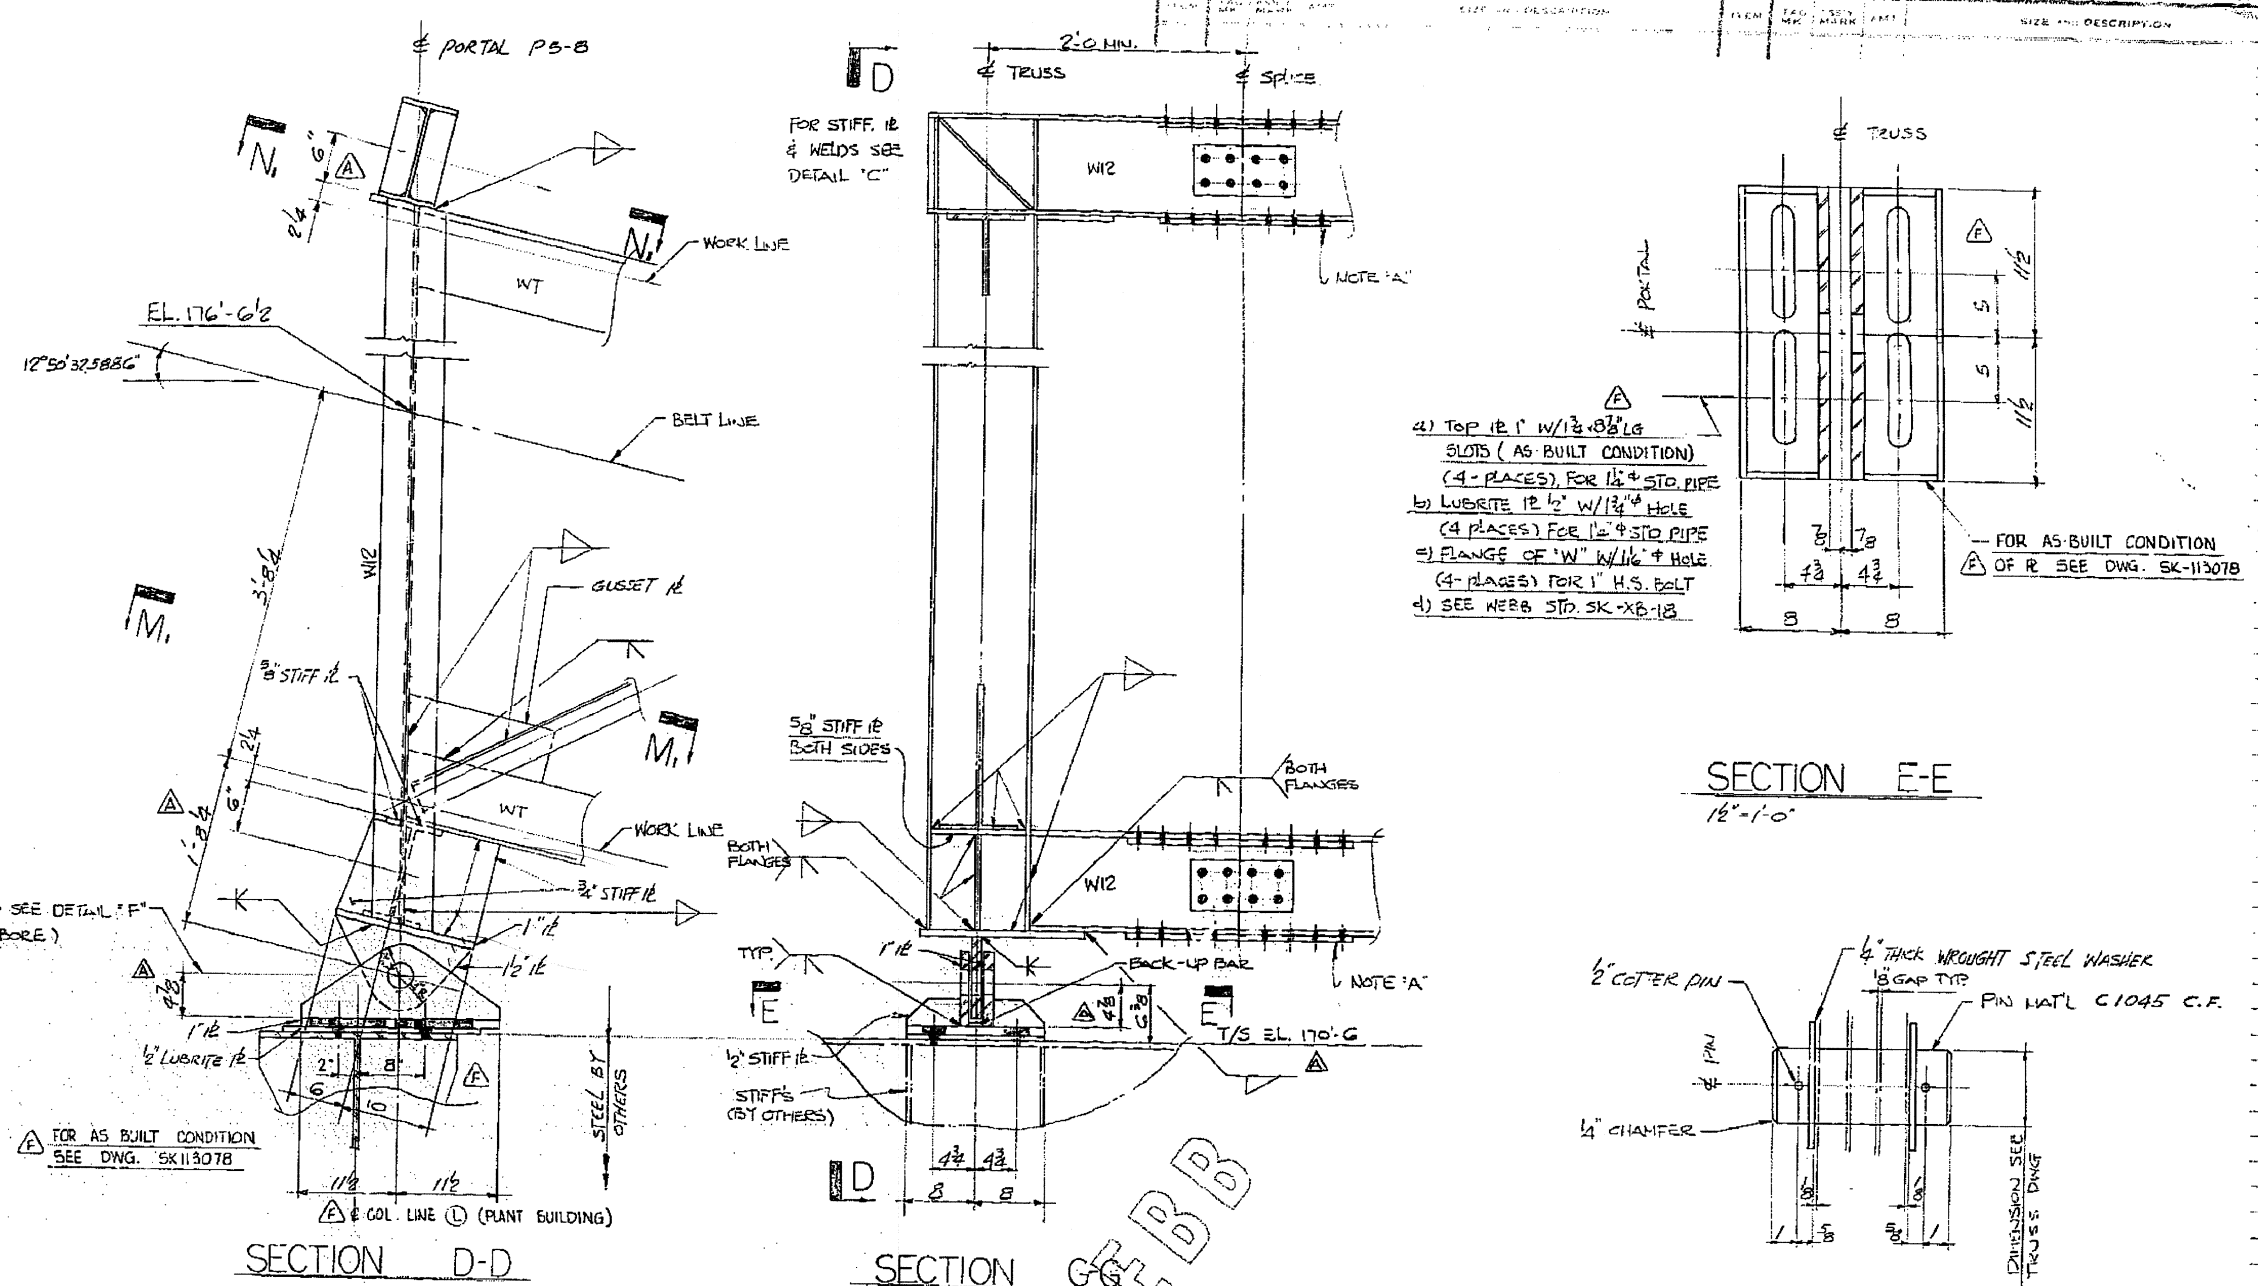


SECTION D-D


SECTION E-E
16'-0"

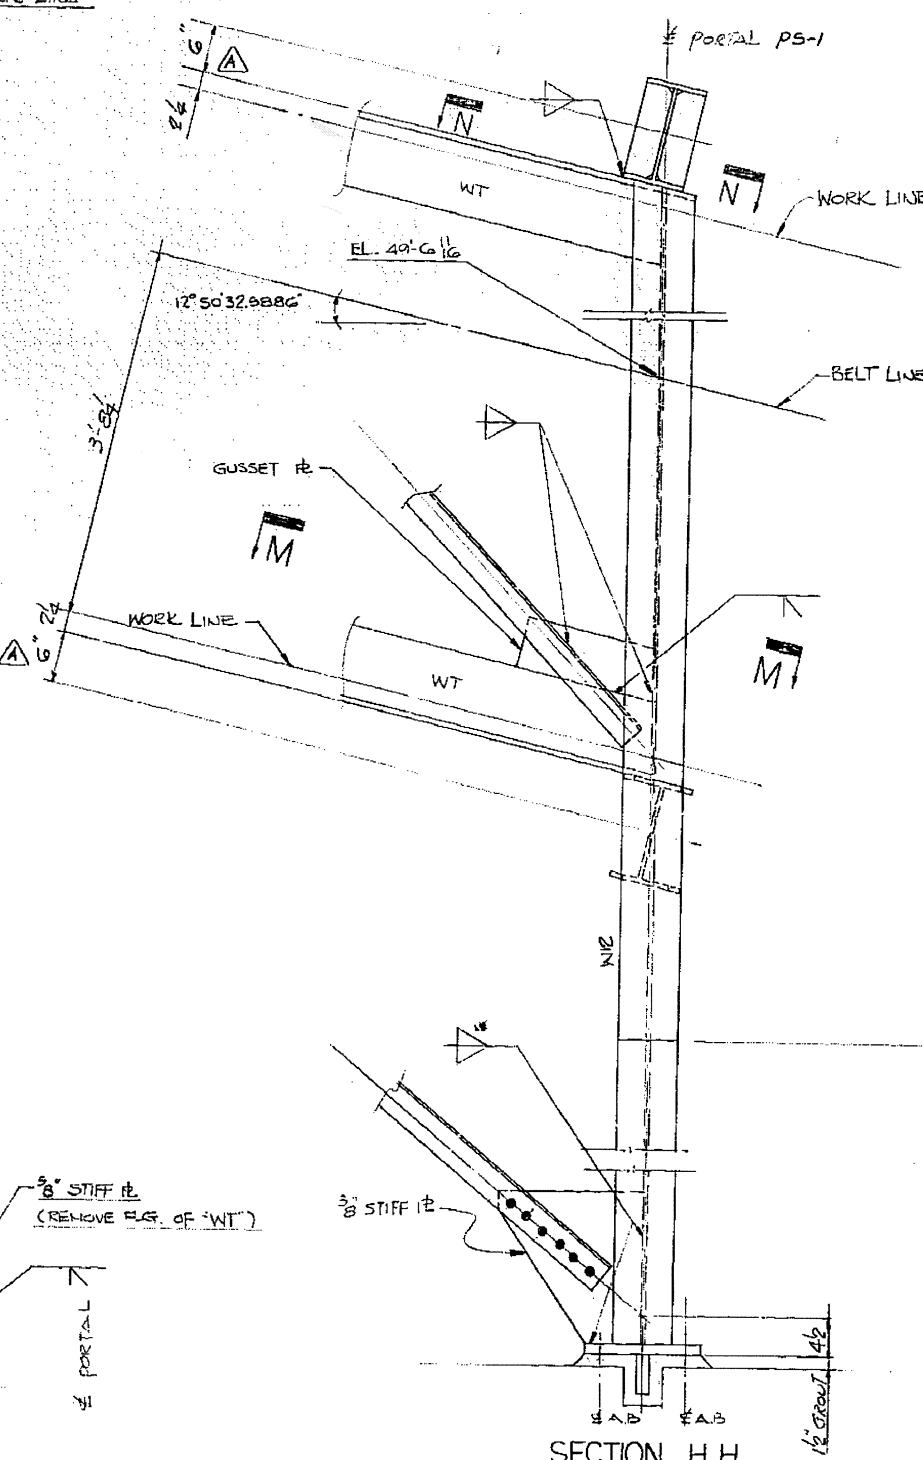

SECTION H-H

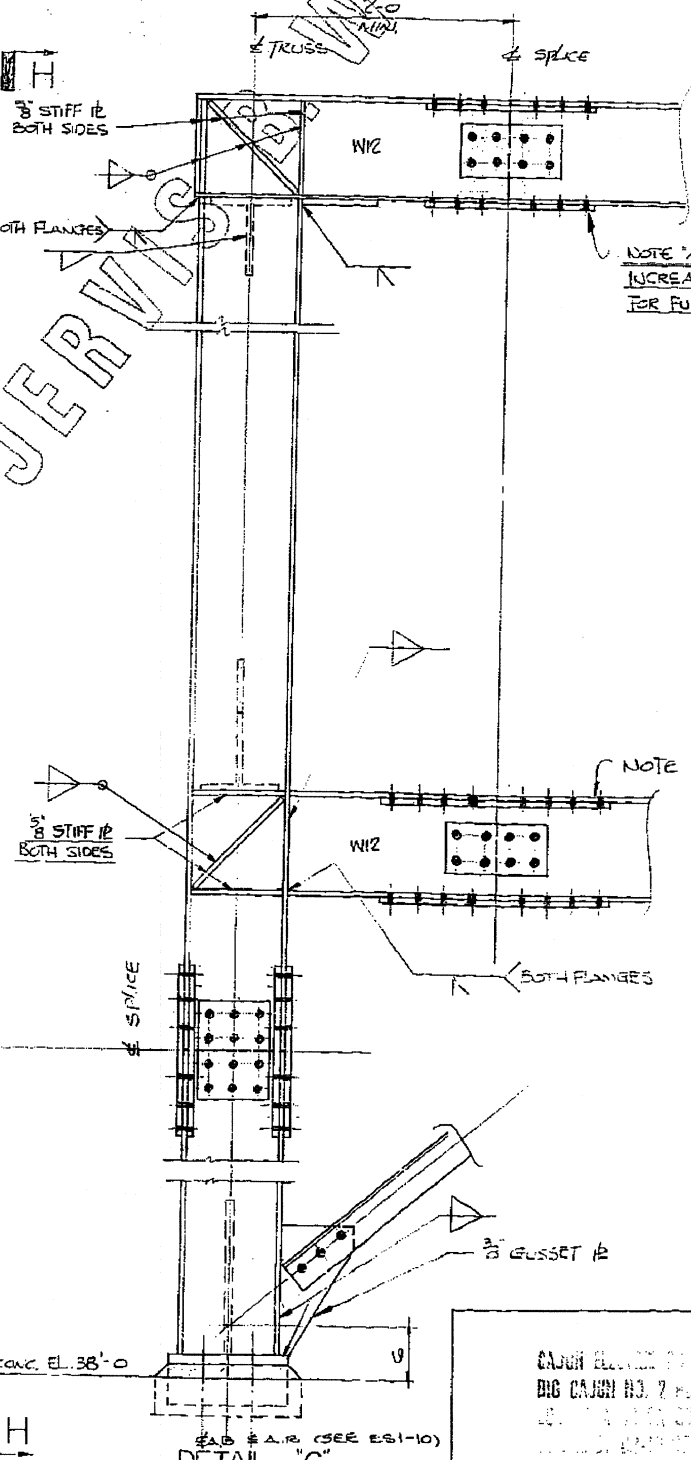

DETAIL C

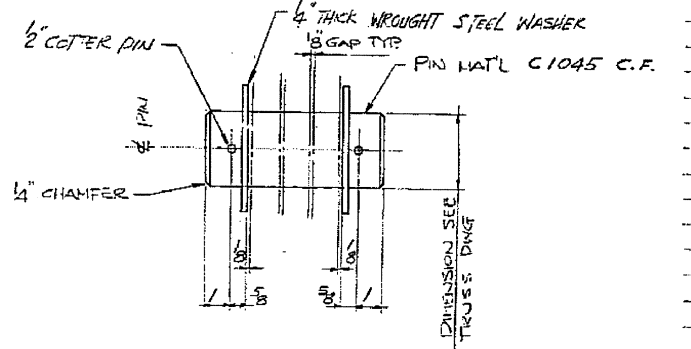

DETAIL F
3'-1-0"

WORK THIS DRAWING WITH:
E51-6 ANCHOR BOLT AND FOUNDATION PLAN
FOR CONV. BEAMS BC-5A & BC-5B
E59-1 TRUSS T5-1 TO T5-2 FOR CONV. BEAMS BC-5A & BC-5B
E59-2 TRUSS T5-3 TO T5-4 FOR CONV. BEAMS BC-5A & BC-5B
E59-3 TRUSS T5-5 TO T5-6 FOR CONV. BEAMS BC-5A & BC-5B
E59-4 TRUSS T5-7 FOR CONV. BEAMS BC-5A & BC-5B
E59-5 BELTS B2 THROUGH-7 FOR CONV. BEAMS BC-5A & BC-5B
E59-6 PLANT TRANSFER TOWER ENTRY DETAILS
CONV. BEAMS BC-5A & BC-5B
E59-8 TYPICAL GALLERY CONNECTIONS FOR
CONV. BEAMS BC-5A & BC-5B
SK 113078 FIELD FIX OR HEAD END OF CONV. BEAM BC-5A & BC-5B

Checked for Design - 10/12/77 by SGL
Checked for Detail - 10/12/77 by SGL
10/12/77 SGL
10/12/77 SGL

BULK SYSTEMS
JERVIS B. WEBB CO.
DETROIT MICH 48244

CAJON ELECTRIC CO.
ENGINEER: W. MENSCH
IN CHARGE: W. MENSCH

NOTICE

1/10 (LUN) A.B. 8-31-77
B-34936-E
ES9-6F