


ELEVATION VIEW
LOOKING SOUTH
SCALE 3/4"=1'-0

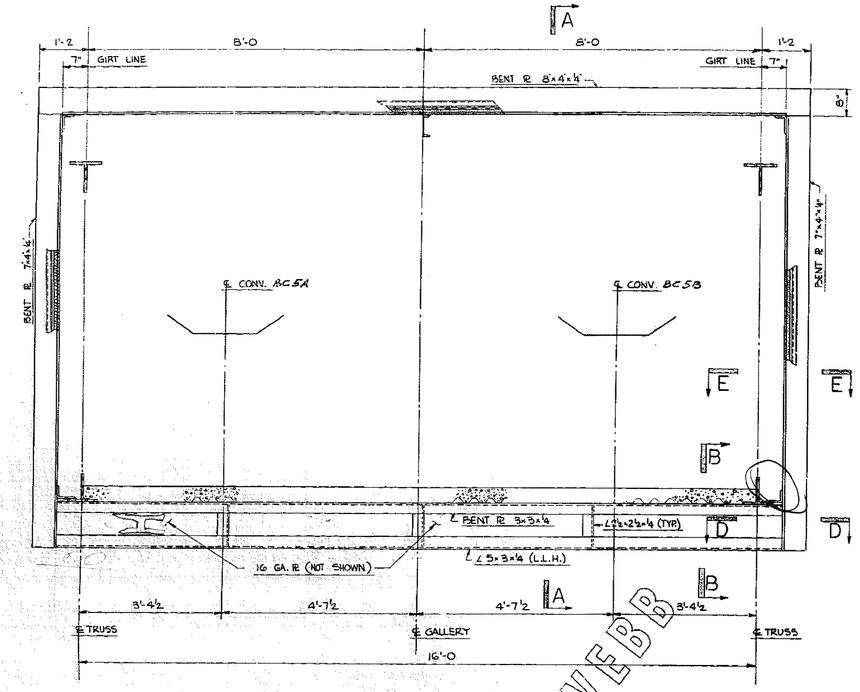


SECTION A-A




SECTION C-C

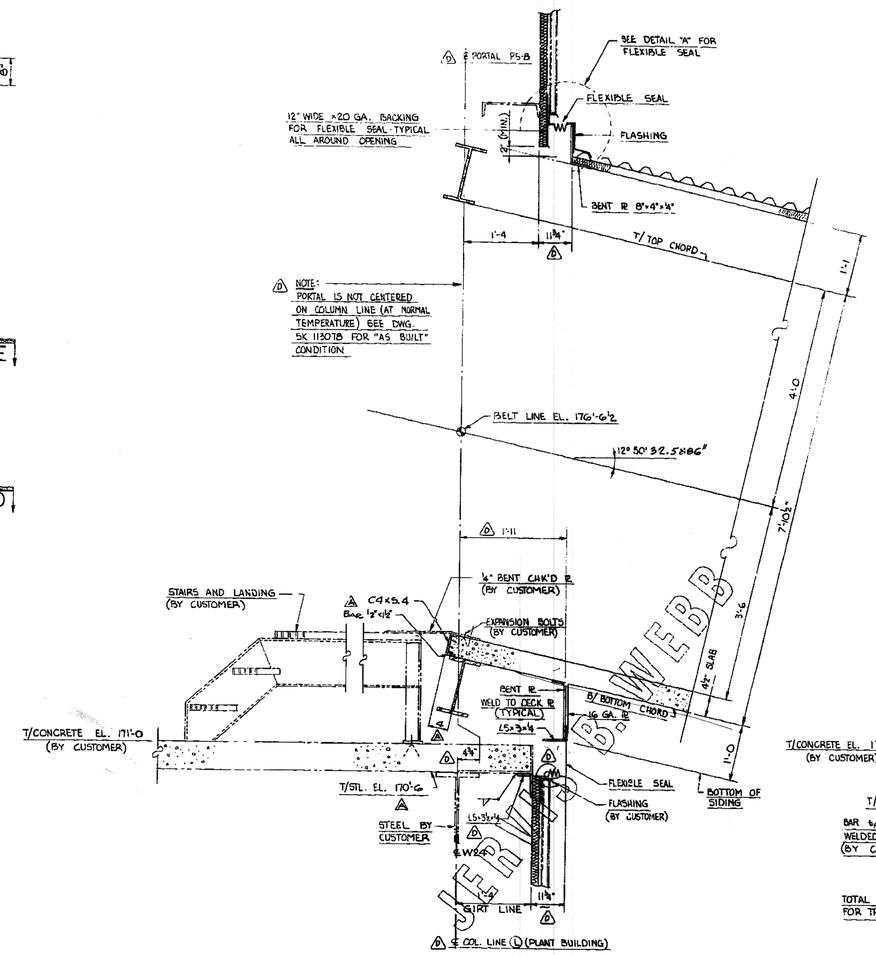


SECTION B-B

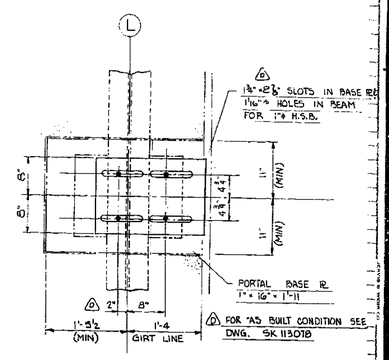


SECTION D-D

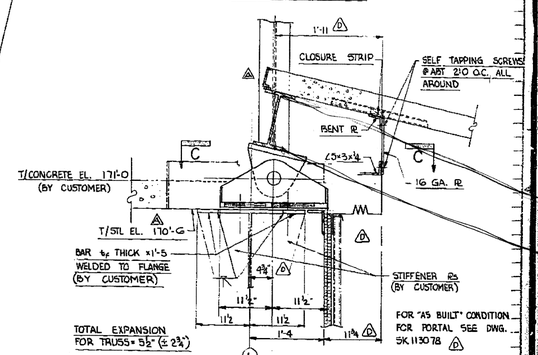


SECTION E-E

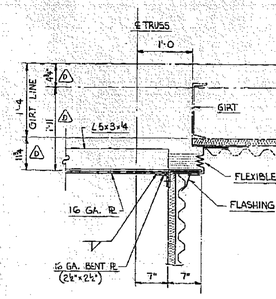


DETAIL "A"

WORK THIS DRAWING WITH:
ES9-G 2ND PORTALS FOR CONV. BC-5A & BC-5B
SK 113078 FIELD FIX @ HEAD END CONV. BC5A-BC5B

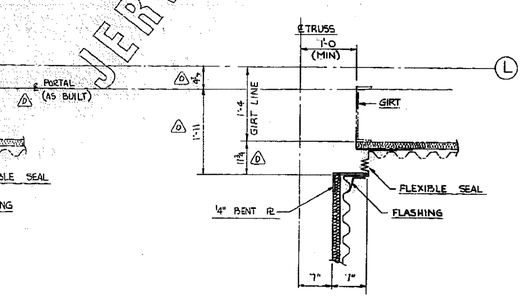Contract for design - date 10-13-77 by DGP
Contract for construction - date 10-13-77 by DGP
Revision No. 1 - 3 DGP
Bulk Systems Series

CAJUN ELECTRIC POWER COOPERATIVE, INC.
BIG CAJUN NO. 2 POWER STATION
LOUISIANA 30 BAYOU
CONTRACT 82-17-COAL HANDLING

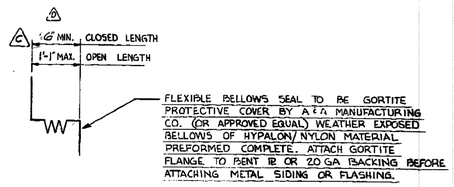NOTE
[illegible] FOR DETAIL ARRANGEMENT, LOCATION AND [illegible] RELATION TO TRANSFERS AND OTHER CUSTOMER EQUIPMENT

CUSTOMERS APPROVAL DATE

BULK SYSTEMS
DIV OF JERVIS B. WEBB CO.
9700 ALPINE AVENUE DETROIT MICH. 48204

PLANT TRANSFER TOWER
ENTRY DETAILS - CONVEYORS BC5A & BC5B
CAJUN ELECTRIC POWER COOPERATIVE, INC.
BIG CAJUN No. 2 POWER PLANT, BONAY ENG. INC.

| | | | |
|---|---|---|---|
| DRAWN | G.L. HOGSTON | APPROVED | [illegible] 1/20/77 |
| SCALE | 1"=1'-0 (U.N.) | CHKD | A.B. |
| DATE | 8-31-77 | | |
| DWG NO. | B-34836-E | REV. | D |
| SHEET | ES 9-7 | | |

| REV | DATE | DESCRIPTION | BY | CHKD BY | NEW NO | REV | DATE | DESCRIPTION | BY | CHKD BY | NEW NO |
|---|---|---|---|---|---|---|---|---|---|---|---|
| D | 12-2-78 | REVISED TO SHOW "AS BUILT" CONDITION | GH. | | | | | | | | |
| C | 8-7-78 | REV. CLOSED LENGTH FOR EXP. JT. | J.D. | | | | | | | | |
| B | 1/9/77 | RELEASED FOR FABRICATION | Ray | | | | | | | | |
| A | 10-6-77 | REV. T/STL. ELEV. ADDED C4 | E.K. | | | | | | | | |

ENGINEER IN CHARGE WILLIAM MENSCH

NOTICE

JERVIS B. WEBB CO.