

STIPULATION FOR REUSE
 THE DRAWINGS HAVE BEEN PREPARED FOR
 USE ON A SPECIFIC SITE AT
 CONTIGUOUSLY WITH ITS ISSUE
 DATE. THIS DRAWING IS NOT
 SUITABLE FOR USE ON A DIFFERENT
 PROJECT SITE OR AT A LATER TIME
 WITHOUT THE WRITTEN CONSENT OF
 HARRISON FRENCH & ASSOCIATES, LTD.
 LICENSED ARCHITECTS AND ENGINEERS.
 REUSE ON ANOTHER PROJECT IS NOT
 PERMITTED AND MAY BE CONSIDERED TO
 BE A VIOLATION OF THE LAW.

Loves
 STORE NUMBER: 860
 I-59, EXIT 1
 NICHOLSON, MS 39463
 JOB NUMBER: 03-23-30003

ISSUE BLOCK		
1	ADD 1	02/16/23


CHECKED BY: LST
 DRAWN BY: CRM
 DOCUMENT DATE: 02/06/23

LINGSHEN TSAO
 LICENSED PROFESSIONAL
 ENGINEER
 20847

2023.02.22 10:12:12-06'00"

ROOF MECH
 PLAN

SHEET:
S122

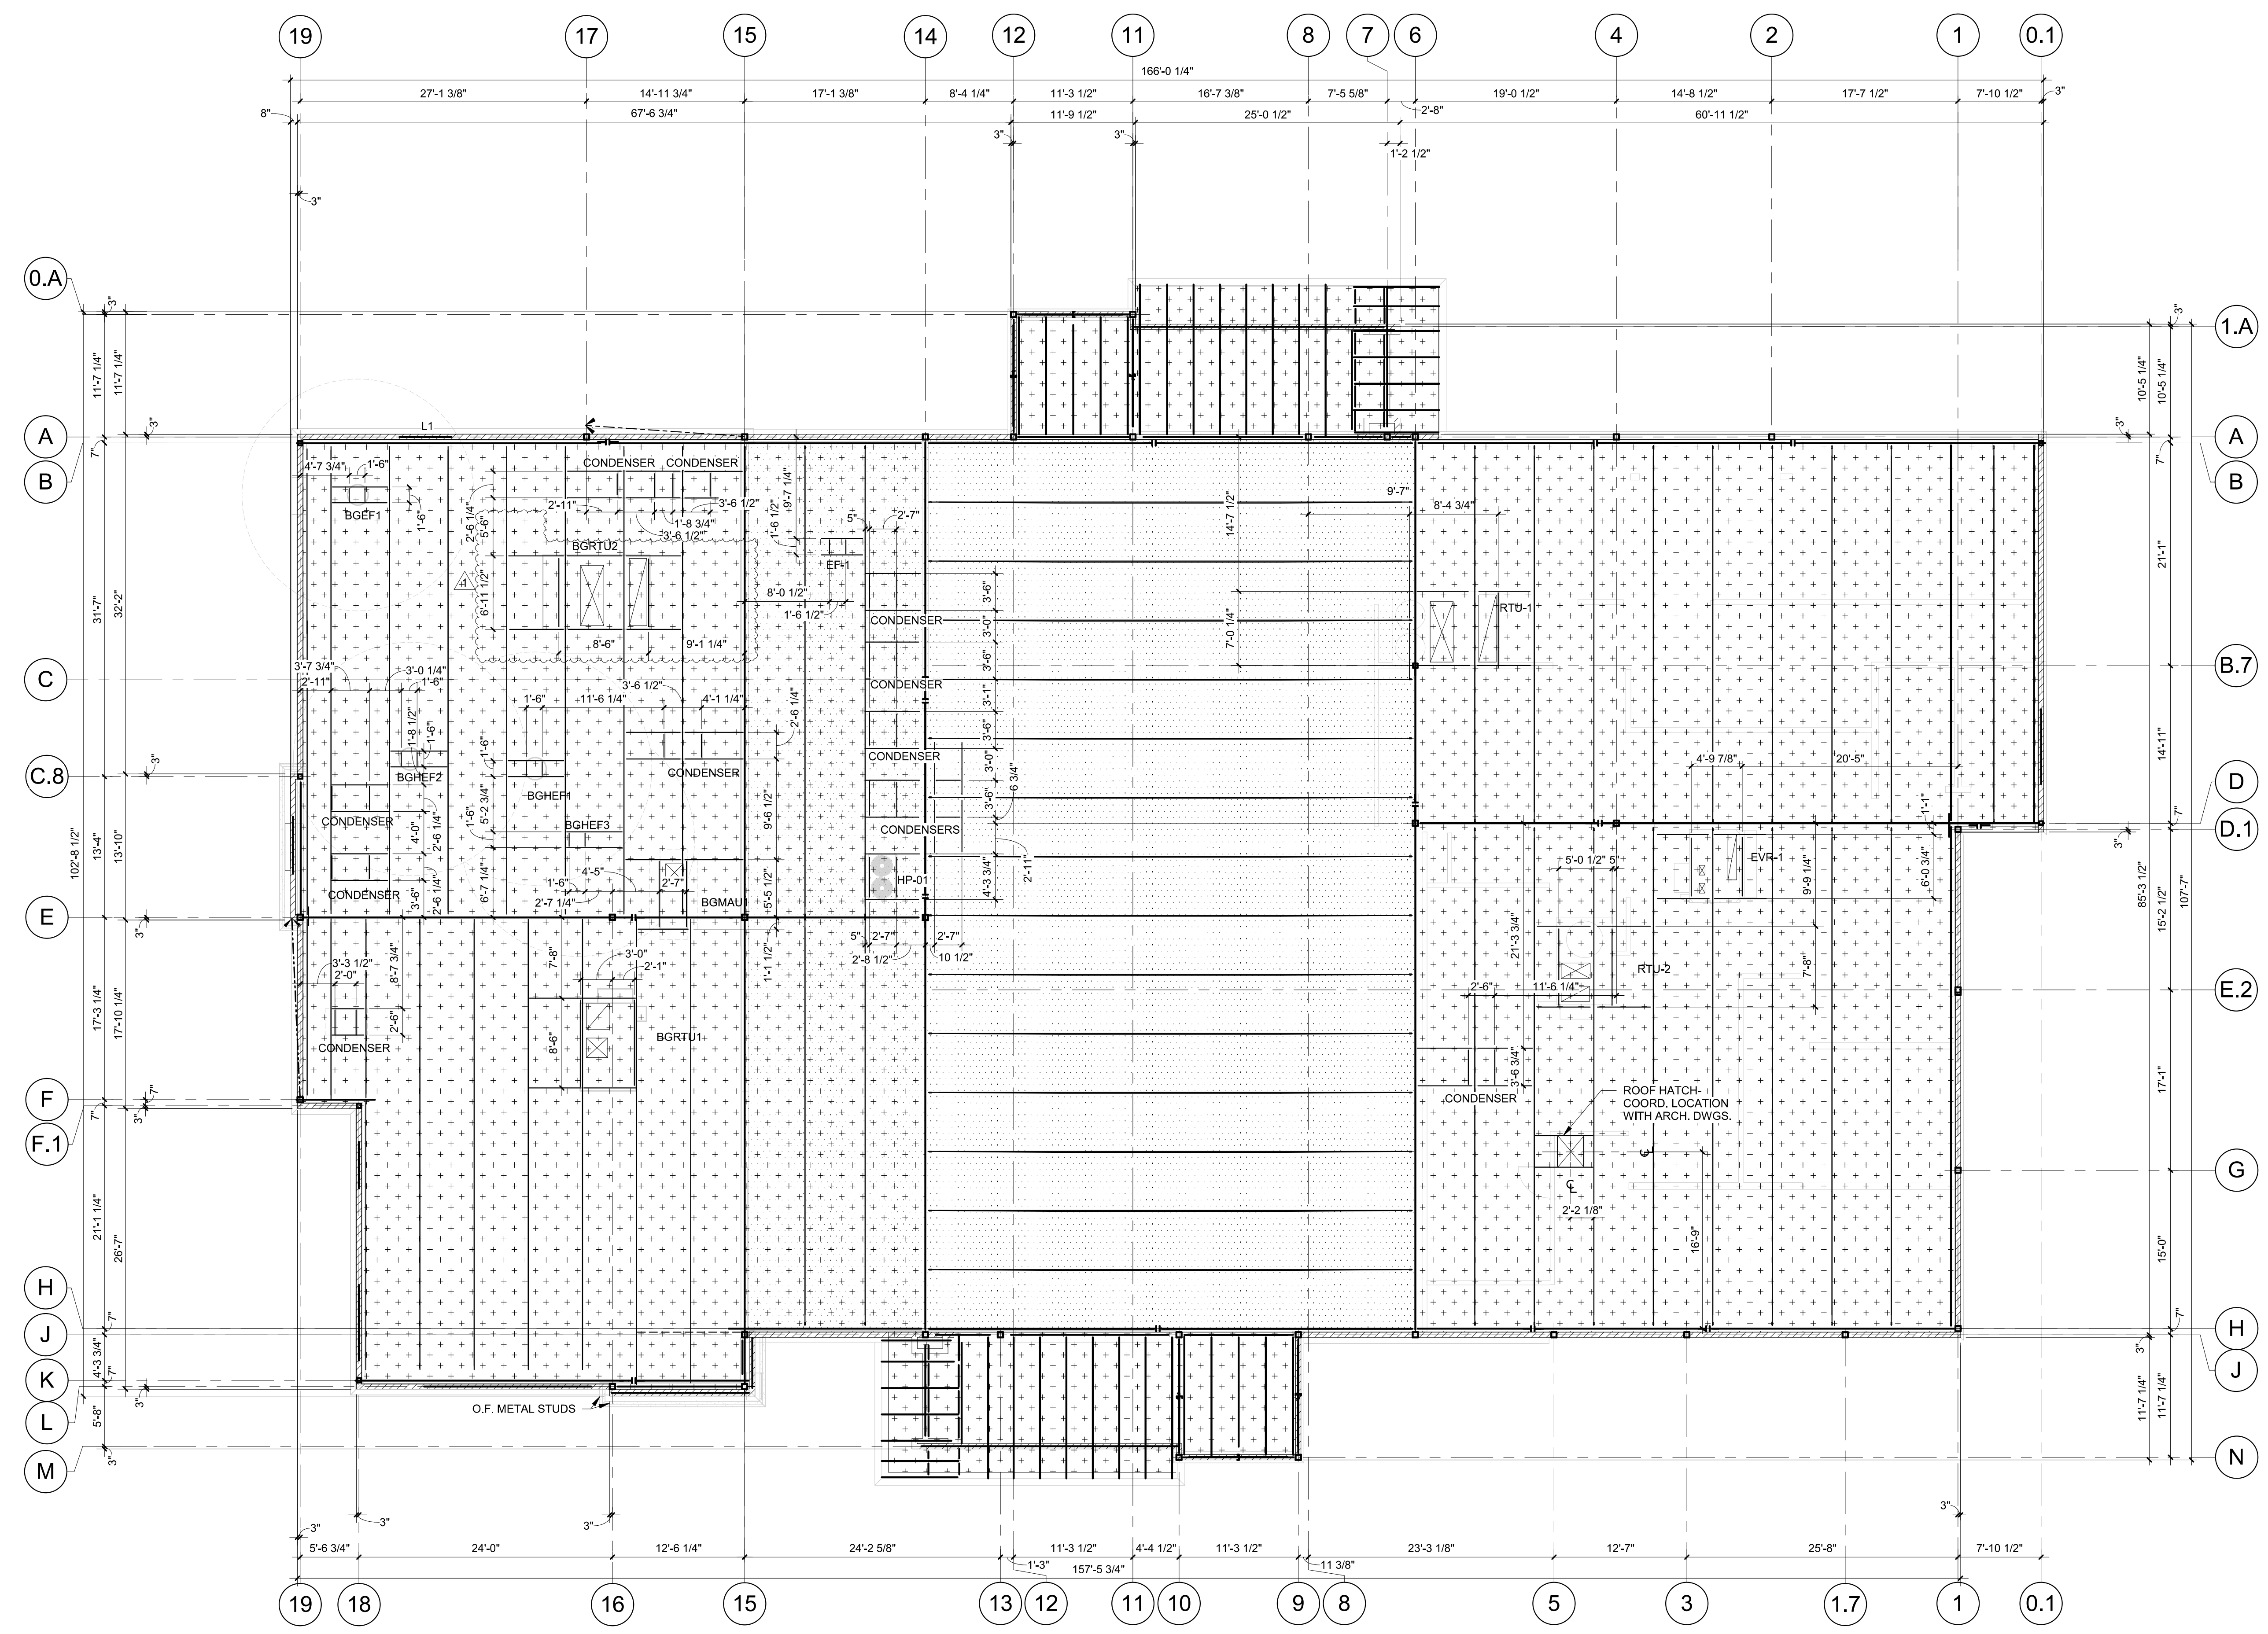

RTU AND ROOF PENETRATION SCHEDULE AND NOTES:
 RTU, MECH. FAN, UNITS HUNG FROM JOIST, CONDENSER, ETC. - LOAD NOTES:
 JOISTS SHALL BE DESIGNED TO SUPPORT LOADS FROM ALL ROOF TOP UNIT, MECH. FAN, UNITS HUNG FROM JOISTS, CONDENSER & OTHER ROOF EQUIPMENT. SEE TABLE BELOW FOR EQUIPMENT LOADS.
 ALL ROOF TOP UNIT AND MECH. FAN FRAMES SHALL BE PROVIDED. G.C. SHALL COORDINATE AND VERIFY FINAL FRAME SIZES AND LOCATIONS PRIOR TO FABRICATION AND INSTALLATION. SEE DETAIL.
 G.C. SHALL SUPPLY TOTAL LOADS OF ALL ROOF EQUIPMENT (INCLUDING ALL ACCESSORIES) TO JOIST MANUF. PRIOR TO JOIST FABRICATION. G.C. SHALL VERIFY QUANTITY.

*ALL CURB DIMENSIONS AND LOCATIONS OF UNITS (SHOWN ON PLAN) SHALL BE VERIFIED/COORDINATED PRIOR TO FABRICATION OF ROOF FRAMES.

UNIT DESIGNATION	WEIGHT (LB)	INSIDE CLEAR CURB DIM'S
ERV-1	1143 (LB)	57" x 83"
RTU-1	2666 (LB)	116 7/8" x 77"
RTU-2	1360 (LB)	80 1/2" x 46 3/8"
BGRTU-1	1370 (LB)	80 1/2" x 46 3/8"
BGRTU-2	1677 (LB)	80 1/2" x 56 3/8"
MAU-1	1348 (LB)	79" x 21"
HP-01	632 (LB)	-----
EF DESIGNATION	135 (LB)	-----
KITCHEN HOOD FANS	135 (LB)	-----
WICWIF CONDENSER	325 (LB)	-----
ICE-MAKER CONDENSER	110 (LB)	-----

1 ROOF MECHANICAL EQUIPMENT DIMENSION PLAN
 1/8" = 1'-0"

02/06/23 10:12:12-06'00"
 C:\Users\lisa\OneDrive\Documents\2023\Revit\Projects\Lowell_Nicholson_MS_2375_T2_180_07_HFA\Jobs\Revit\01
 2302-01-000P-MECH-PLAN-001.rvt