GENERAL NOTES

1. ALL PRE-FINISHED METAL COPING TO MATCH ADJACENT WALL COLOR UNLESS NOTED OTHERWISE
2. PROVIDE FLEXIBLE WALKWAYS, (30" WIDE MIN) AROUND ALL MECHANICAL UNITS/EQUIPMENT & ROOF ACCESS LOCATIONS. REF HATCHED AREAS ON ROOF PLAN
3. REFER TO SPECS FOR THERMAL INSULATION R-VALUE AND MANUFACTURER INFORMATION.
4. REFER TO A112 FOR ROOF DETAILS

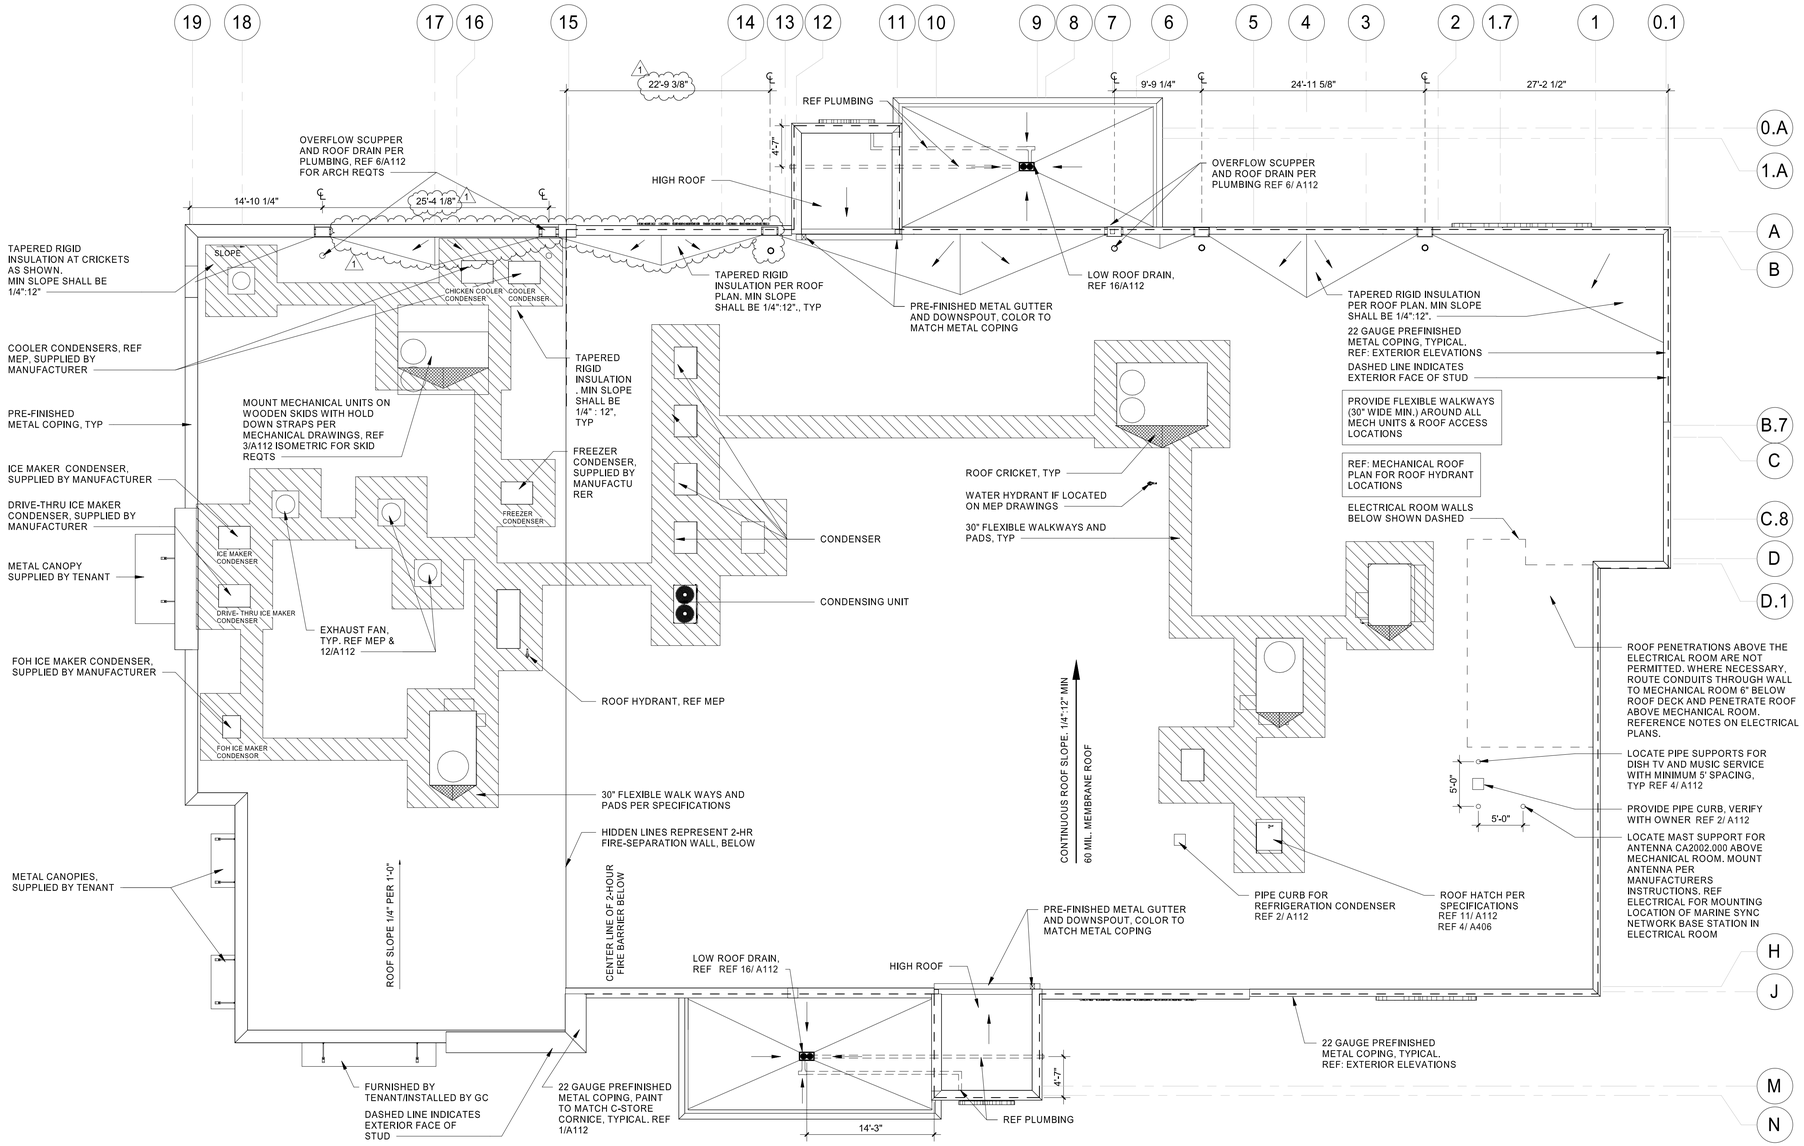

1 ROOF PLAN
1/8" = 1'-0"

HFA
HARRISON FRENCH
& ASSOCIATES, PLLC
t 479.273.7780
1705 S. Walton Blvd., Suite 3
Bentonville, Arkansas 72712
www.hfa-ae.com

STIPULATION FOR REUSE
THIS DRAWING WAS PREPARED FOR USE ON A SPECIFIC SITE AT NICHOLSON, MS AND IS NOT CONTEMPORANEOUSLY WITH ITS ISSUE SUITABLE FOR USE ON A DIFFERENT SITE. SEE A DIFFERENT SITE. ANY REUSE OR USE OF THIS DRAWING FOR REFERENCE REQUIRES THE SERVICES OF PROPERLY REGISTERED ARCHITECT. ANY UNAUTHORIZED REPRODUCTION OF THIS DRAWING FOR USE ON ANOTHER PROJECT OR SITE IS UNAUTHORIZED AND MAY BE CONTRARY TO LAW.

Love's
STORE NUMBER: 860
I-59, EXIT 1
NICHOLSON, MS 39466
JOB NUMBER: 03-23-30009
T1-180

ISSUE BLOCK		
1	ADD 1	02/16/23

CHECKED BY:	MAP
DRAWN BY:	ASE
DOCUMENT DATE:	02/06/23
PROTO:	T1-180
PROTO CYCLE:	Q4 - 2022

REGISTERED ARCHITECT
BOGUE L. EBBRECHT
STATE OF MISSISSIPPI
2023.02.20 12:18:10-06'00'

ROOF PLAN

SHEET:
A111

2/20/2023 11:00:40 AM
C:\Users\ase\Desktop\Temp\Document2021\Real Projects\Love_Nicholson_MS_ARC_72_180_v21_HFA Mahyco Prompt.rvt
2023-111-ROOF PLAN-A00.1