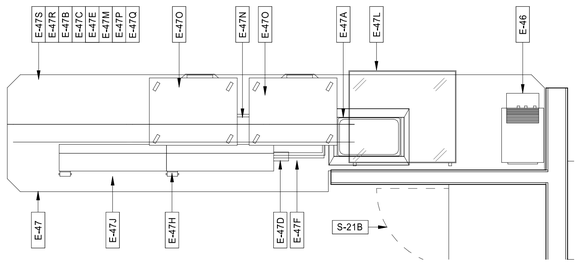

2 ENLARGED COUNTER PLAN
1/2" = 1'-0"

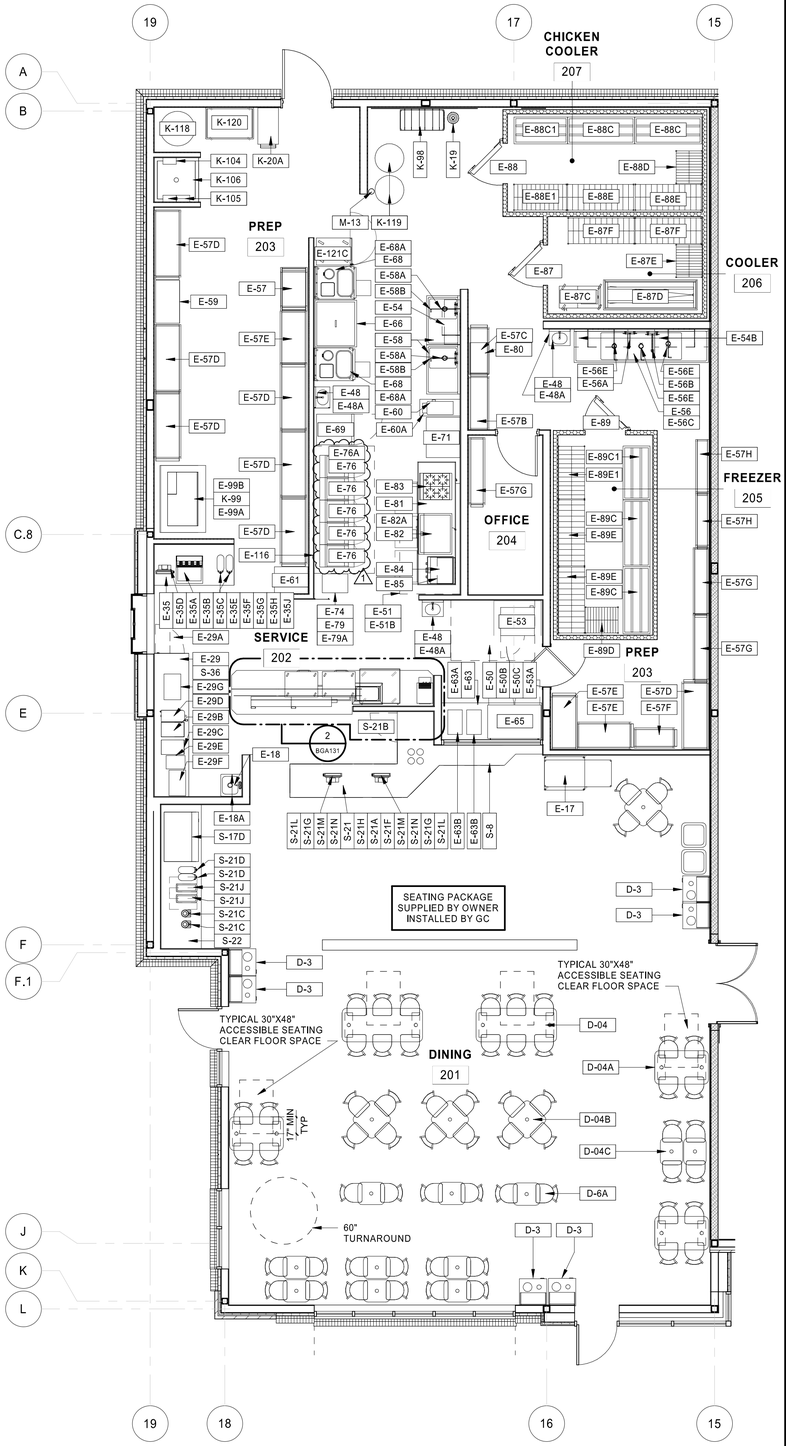

1 EQUIPMENT PLAN
3/16" = 1'-0"

HFA
HARRISON FRENCH
& ASSOCIATES, PLLC
t 479.273.7780
1705 S. Walton Blvd., Suite 3
Bentonville, Arkansas 72712
www.hfa-ae.com

STIPULATION FOR REUSE
THIS DRAWING WAS PREPARED FOR USE ON A SPECIFIC SITE AT NICHOLSON, MS. CONTEMPORANEOUSLY WITH ITS ISSUE THIS DRAWING WAS NOT PRESUMED SUITABLE FOR USE ON A DIFFERENT SITE OR AT A LATER DATE. REPEATED USE OF THIS DRAWING FOR REFERENCE BY THE OWNER OR ANY OTHER PARTY REQUIRES THE SERVICES OF PROPERLY LICENSED ARCHITECT. UNAUTHORIZED REPRODUCTION OF THIS DRAWING FOR REUSE BY ANY OTHER PARTY IS NOT AUTHORIZED AND MAY BE CONTRARY TO LAW.

Lowe's
STORE NUMBER: 860
I-59, EXIT 1
NICHOLSON, MS 39466
JOB NUMBER: 03-23-30009
BOJANGLES

ISSUE BLOCK

1	ADD 1	02/16/23

CHECKED BY:	MAP
DRAWN BY:	ASE
DOCUMENT DATE:	02/06/23
PROTO:	BOJANGLES
PROTO CYCLE:	Q4 - 2022

REGISTERED ARCHITECT
BOGUE L EBBRECHT
MISSISSIPPI
2023.02.20 12:18:41-06'00'

EQUIPMENT PLAN

SHEET:
BGA131

2/16/2023 4:40:45 PM
C:\Users\mattpowell\AppdataLocal\Temp\acpublish_4292\Revit Project\Love_Nicholson_MS_ARC_FT_R23_v21_HFA Mirror Design.rvt
5025-BGA131-EQUIPMENT PLAN.ADQ 1